


EXHIBIT A

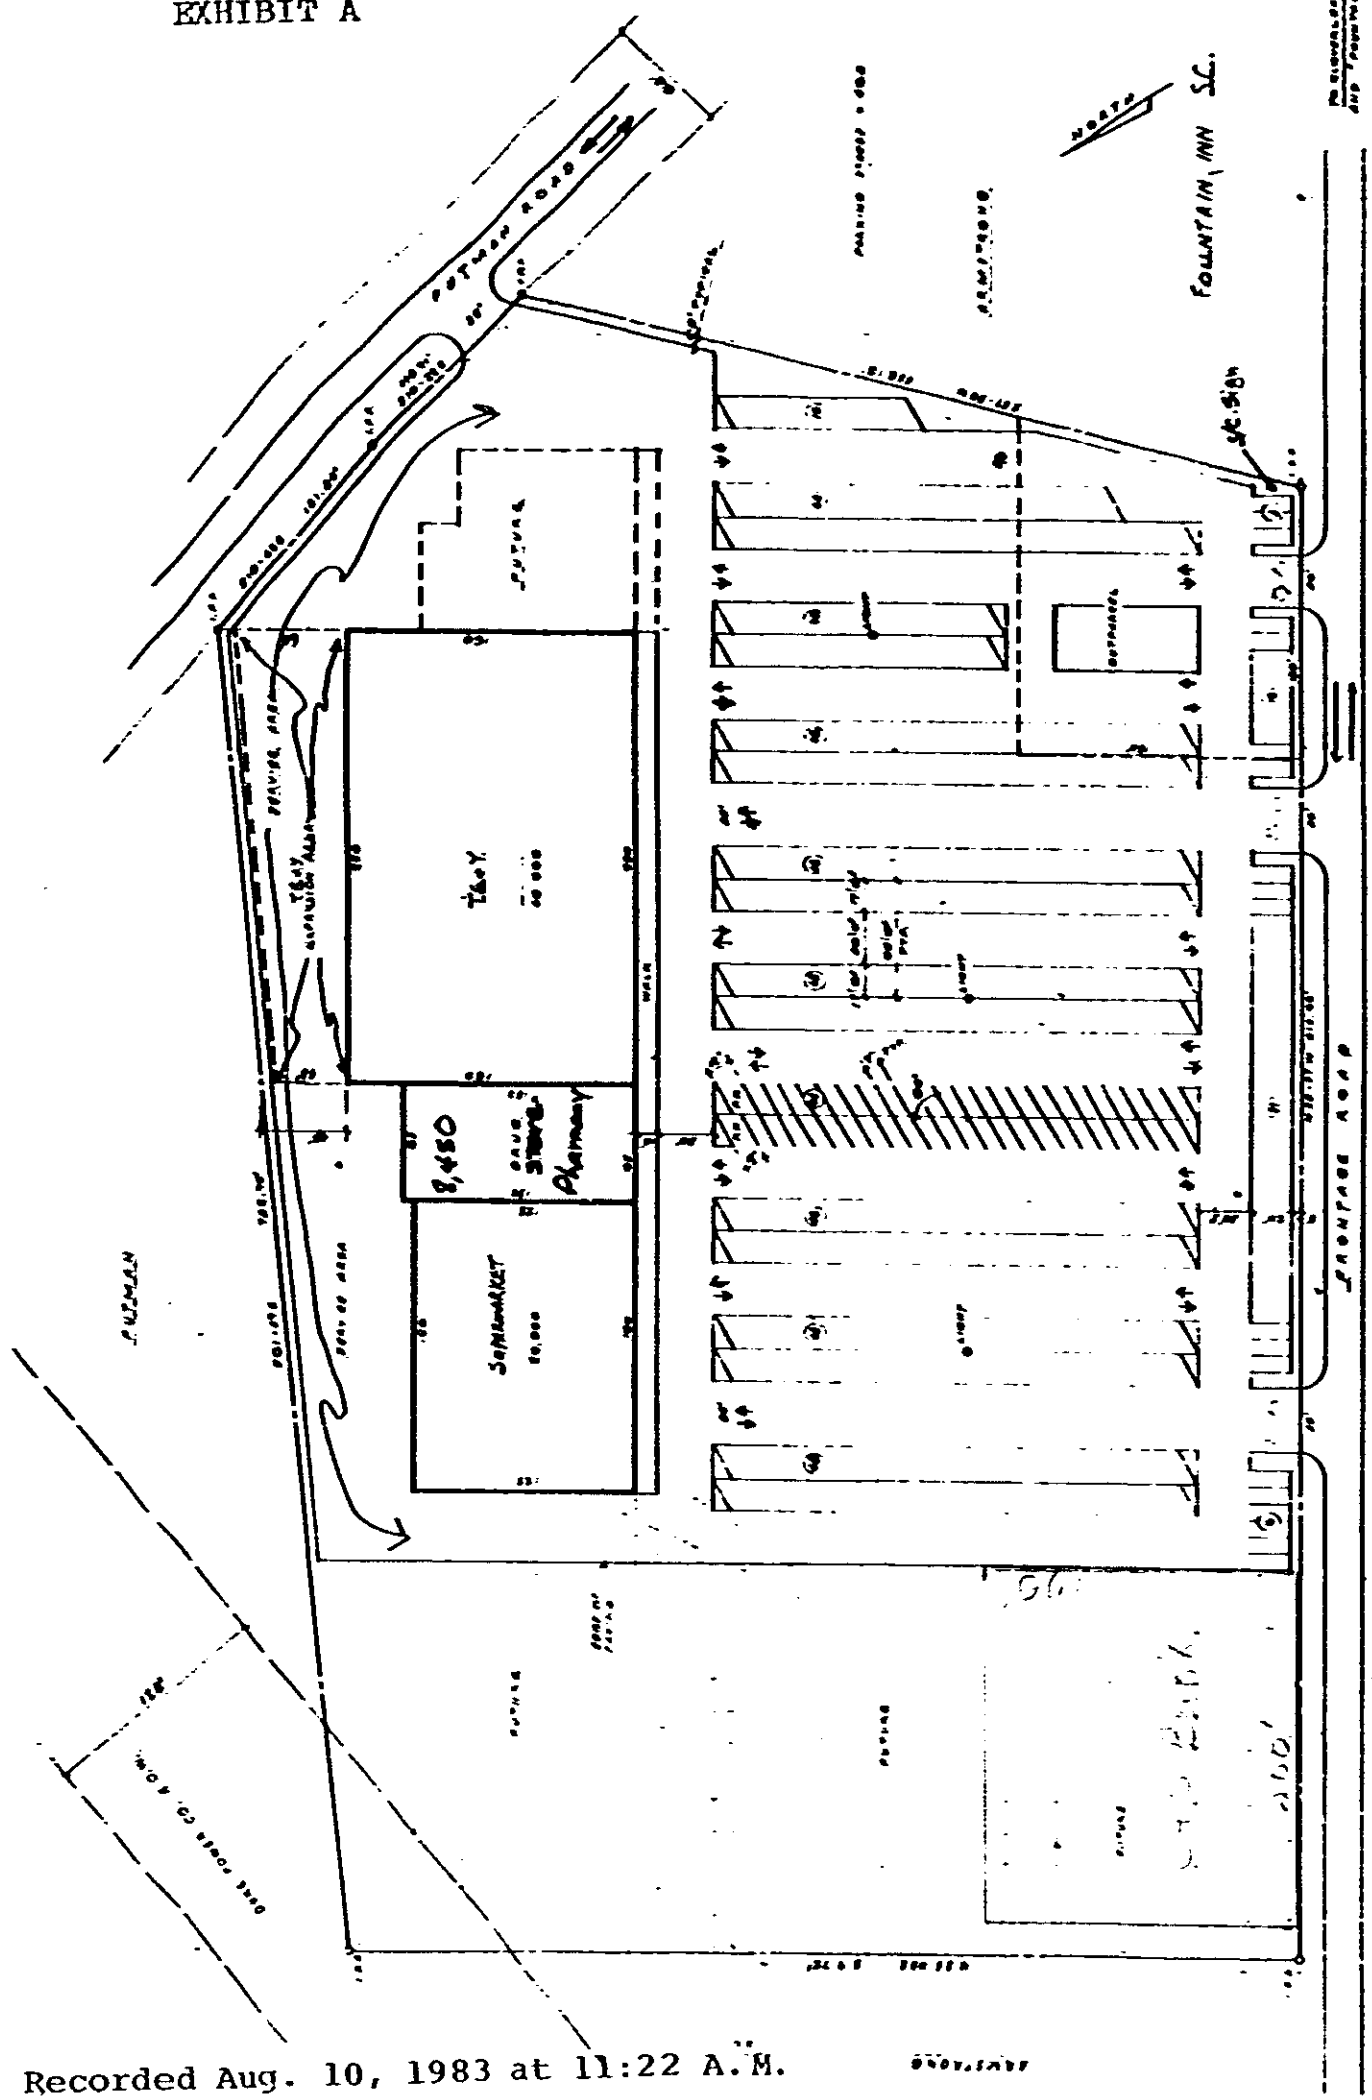

Recorded Aug. 10, 1983 at 11:22 A.M.

*Handwritten notes:* 3.17.83, 3.17.83



U.S. MAP, 478

3.17.83, 3.17.83

1843

0130

4325-W-21