

0684



LOCATION MAP

CERTIFICATE OF OWNERSHIP AND DEDICATION
 The undersigned hereby acknowledges that I own and the interests of the property shown and described herein and that I have hereby dedicated the same.


CERTIFICATE OF ACCURACY


FILE NUMBER

SCOTTFIELD VILLAS
 Apartment Community

NO. OF ACRES 7.32
 NO. OF LOTS 144
 DATE 11.14.82

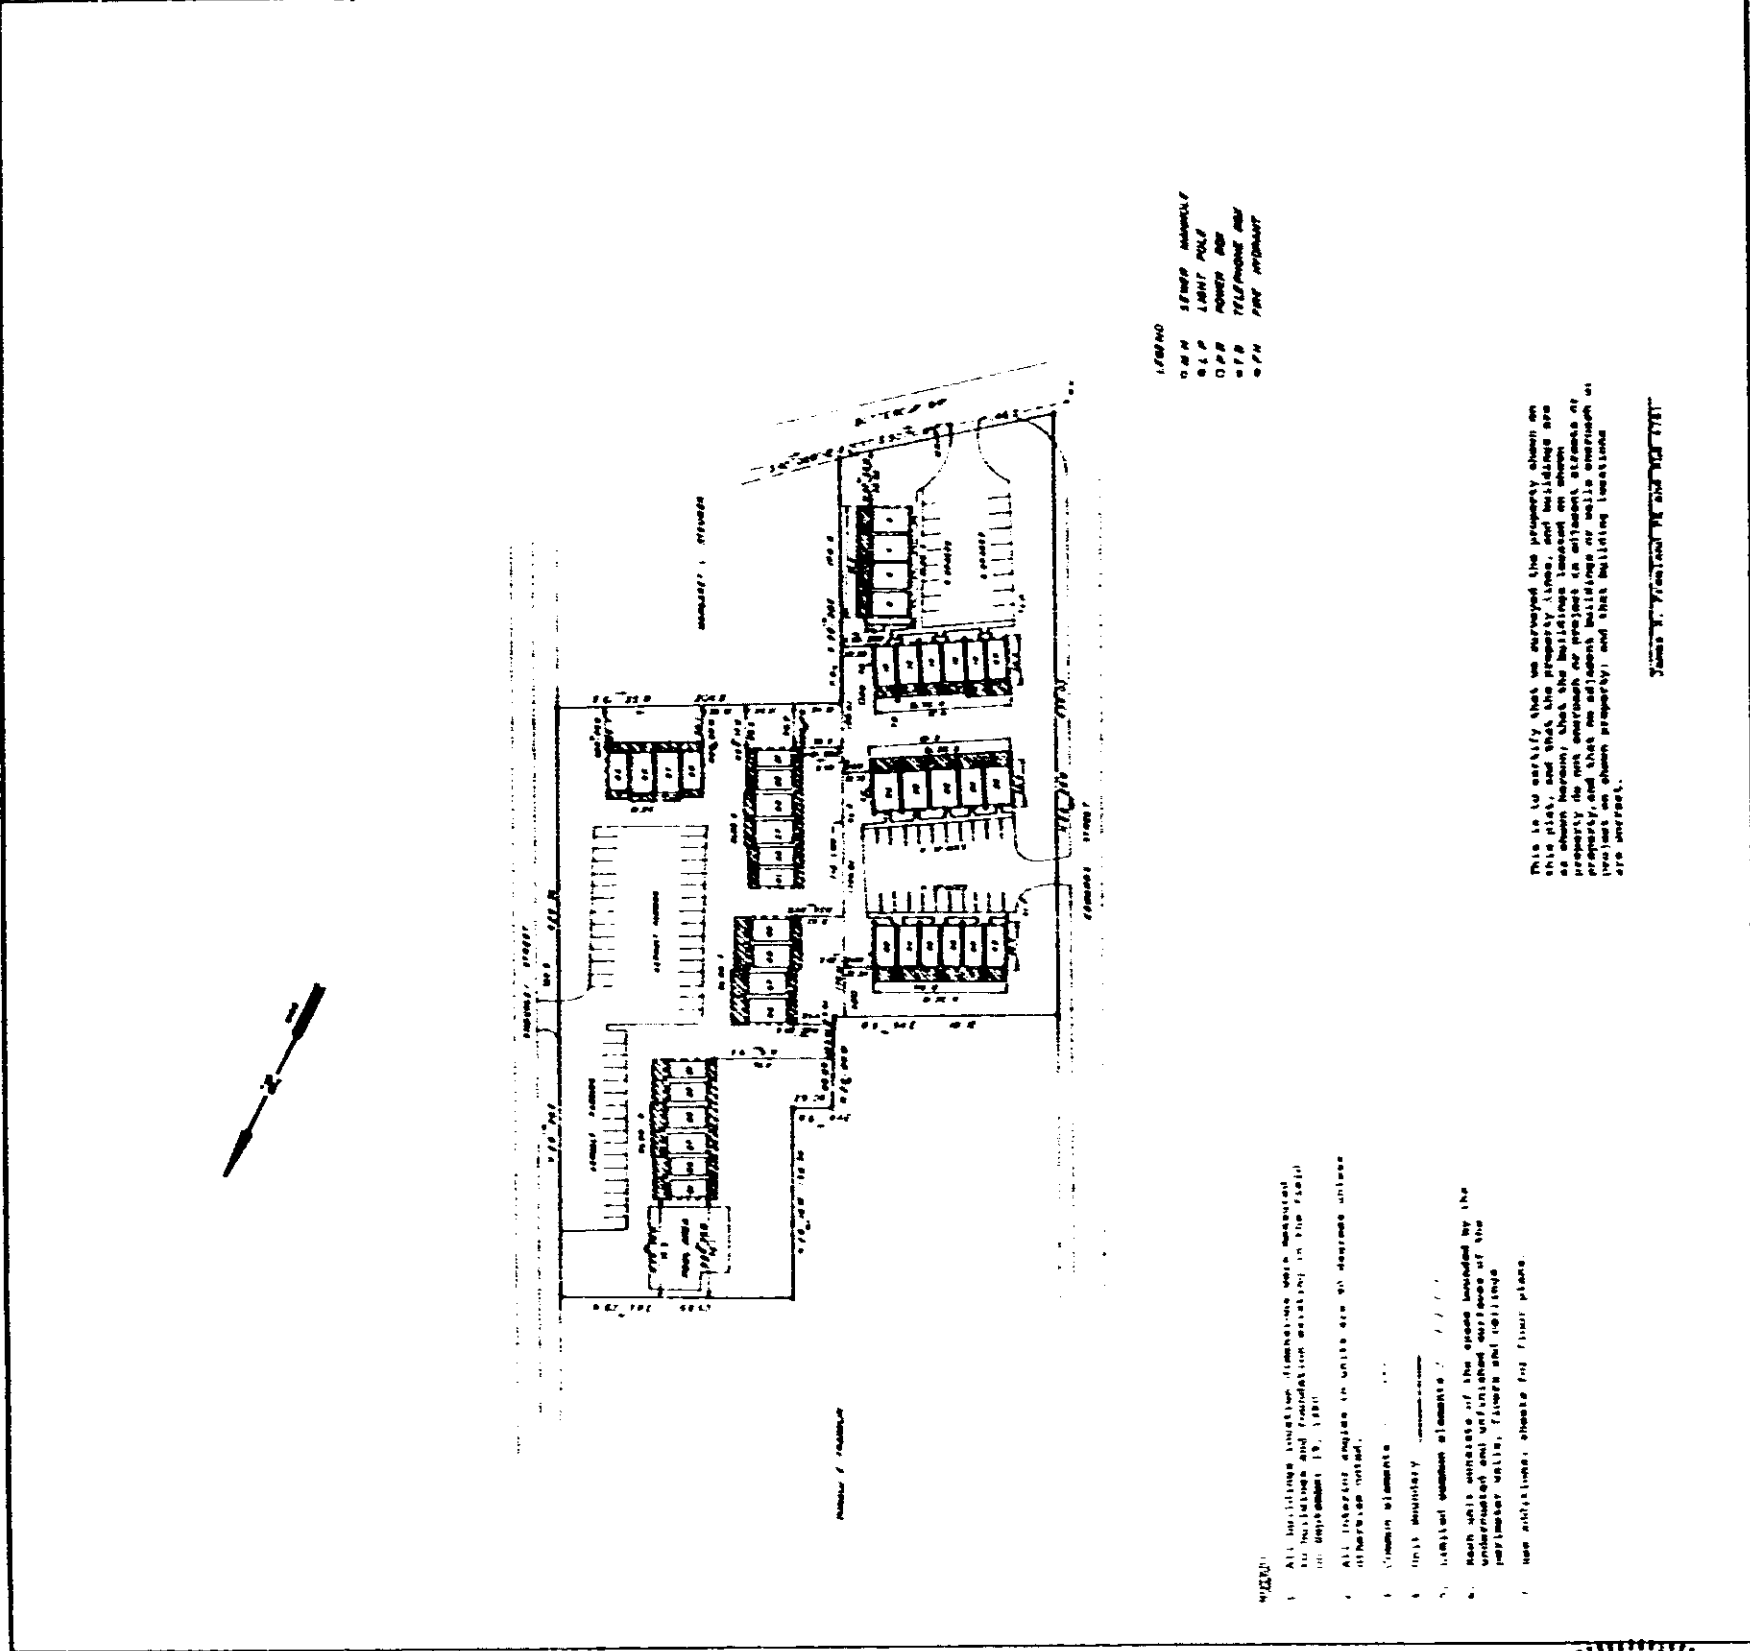


- NOTES:**



RECORDED OCT 4 1983 at 10:35 A.M.

11047

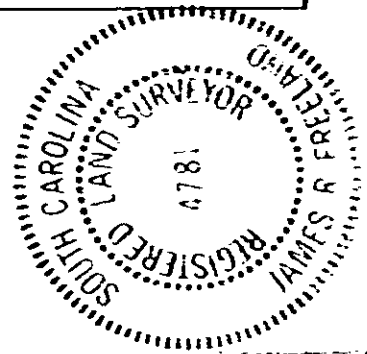

1328-RV-21