



EXHIBIT A

1209-420

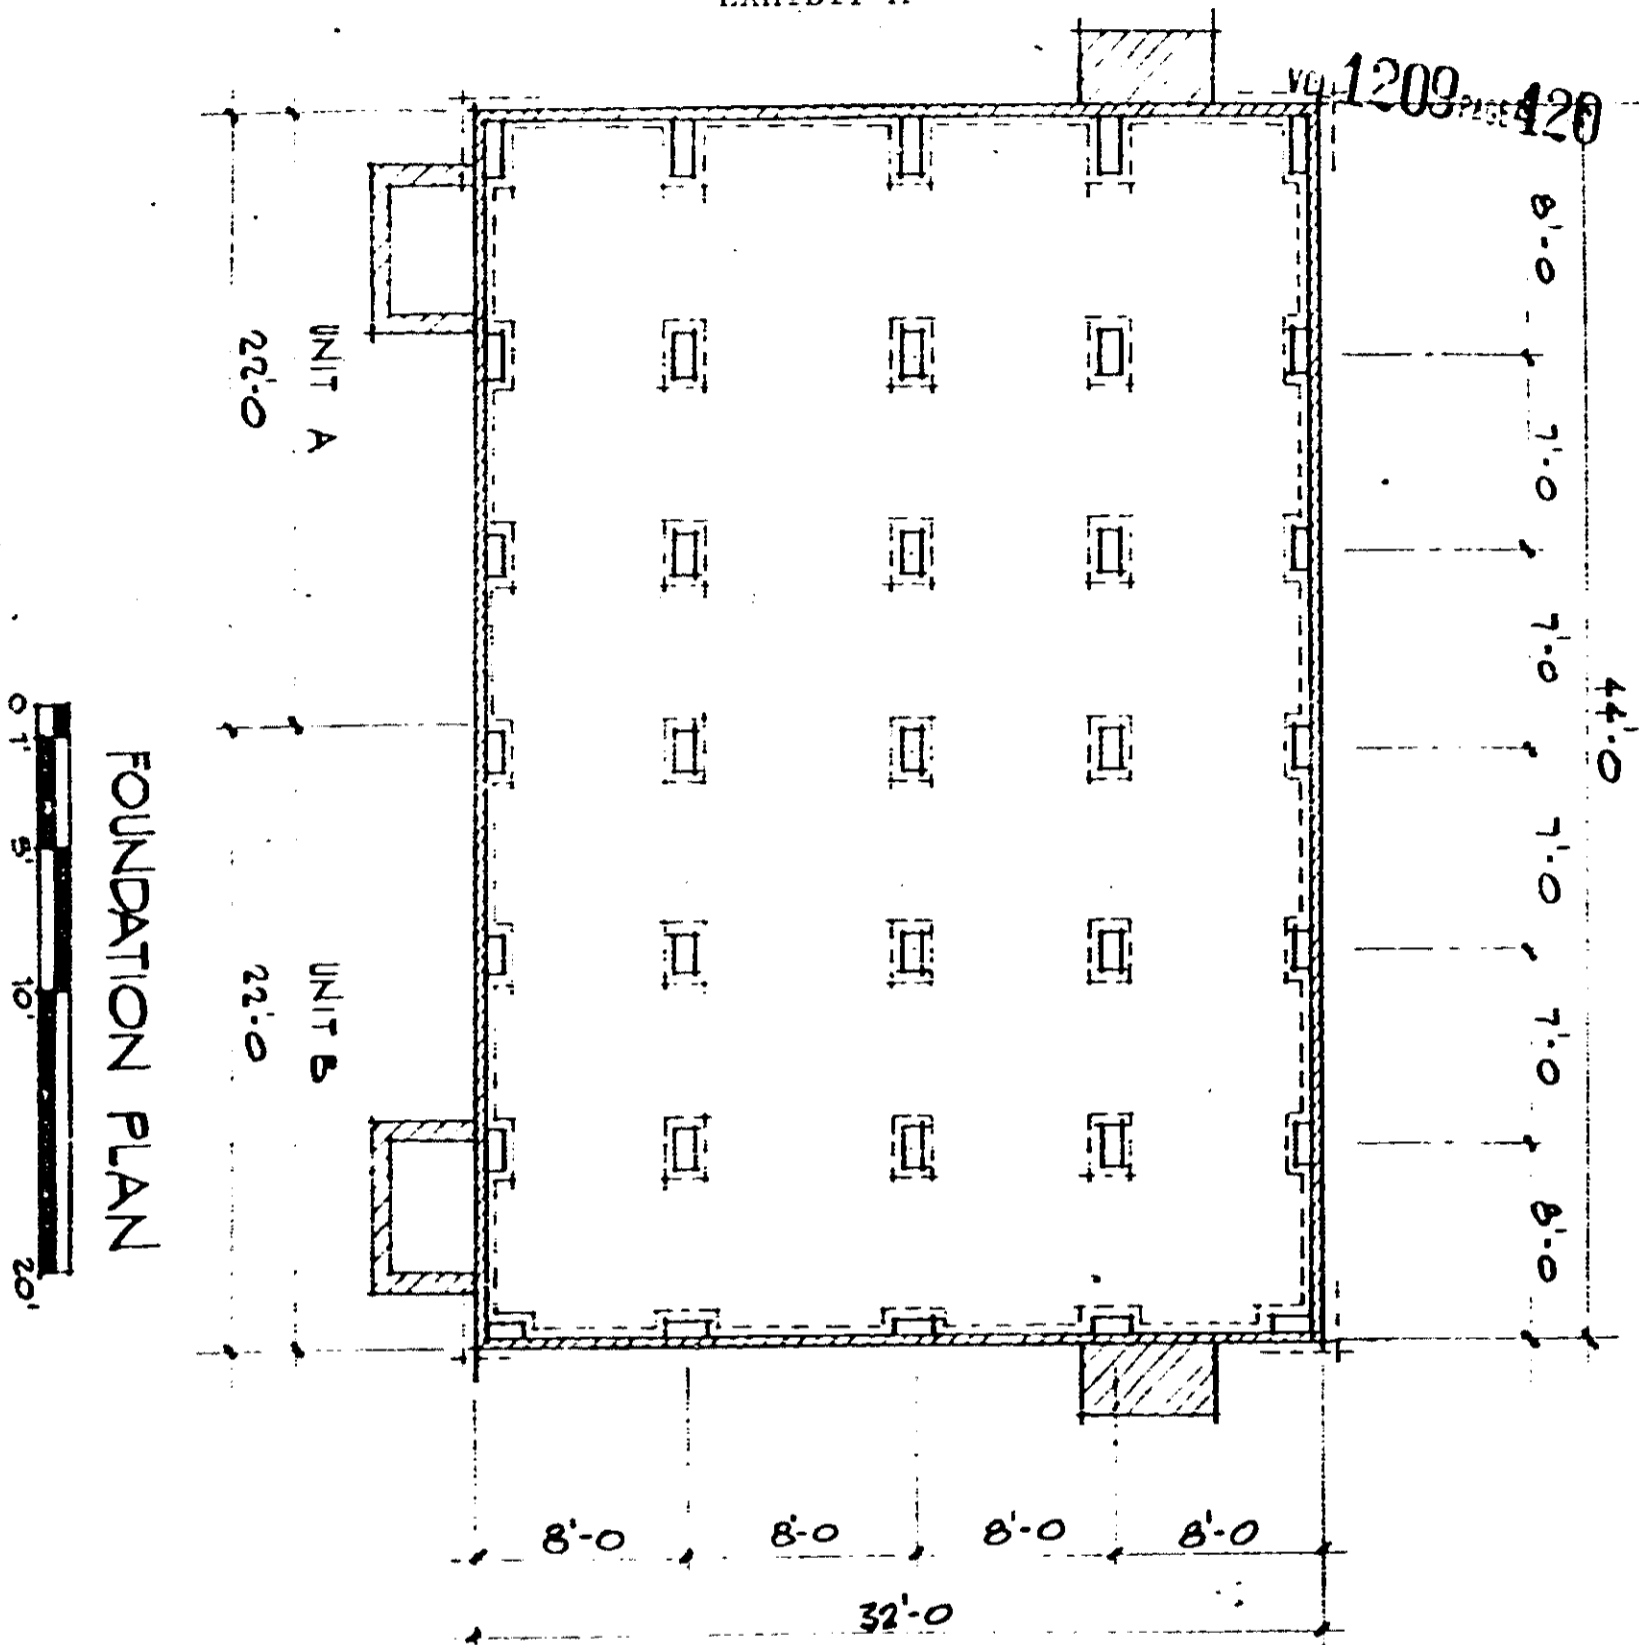

CERTIFICATE

I, Wade H. Barber, do hereby certify that these plans fully depict within reasonable construction tolerances the layout, location letter identification, and dimensions of the buildings and dwellings contained therein.

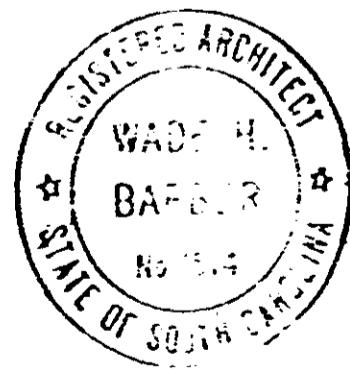

Wade Barber