


EXHIBIT "B"


VEL 1210 PAGE 827

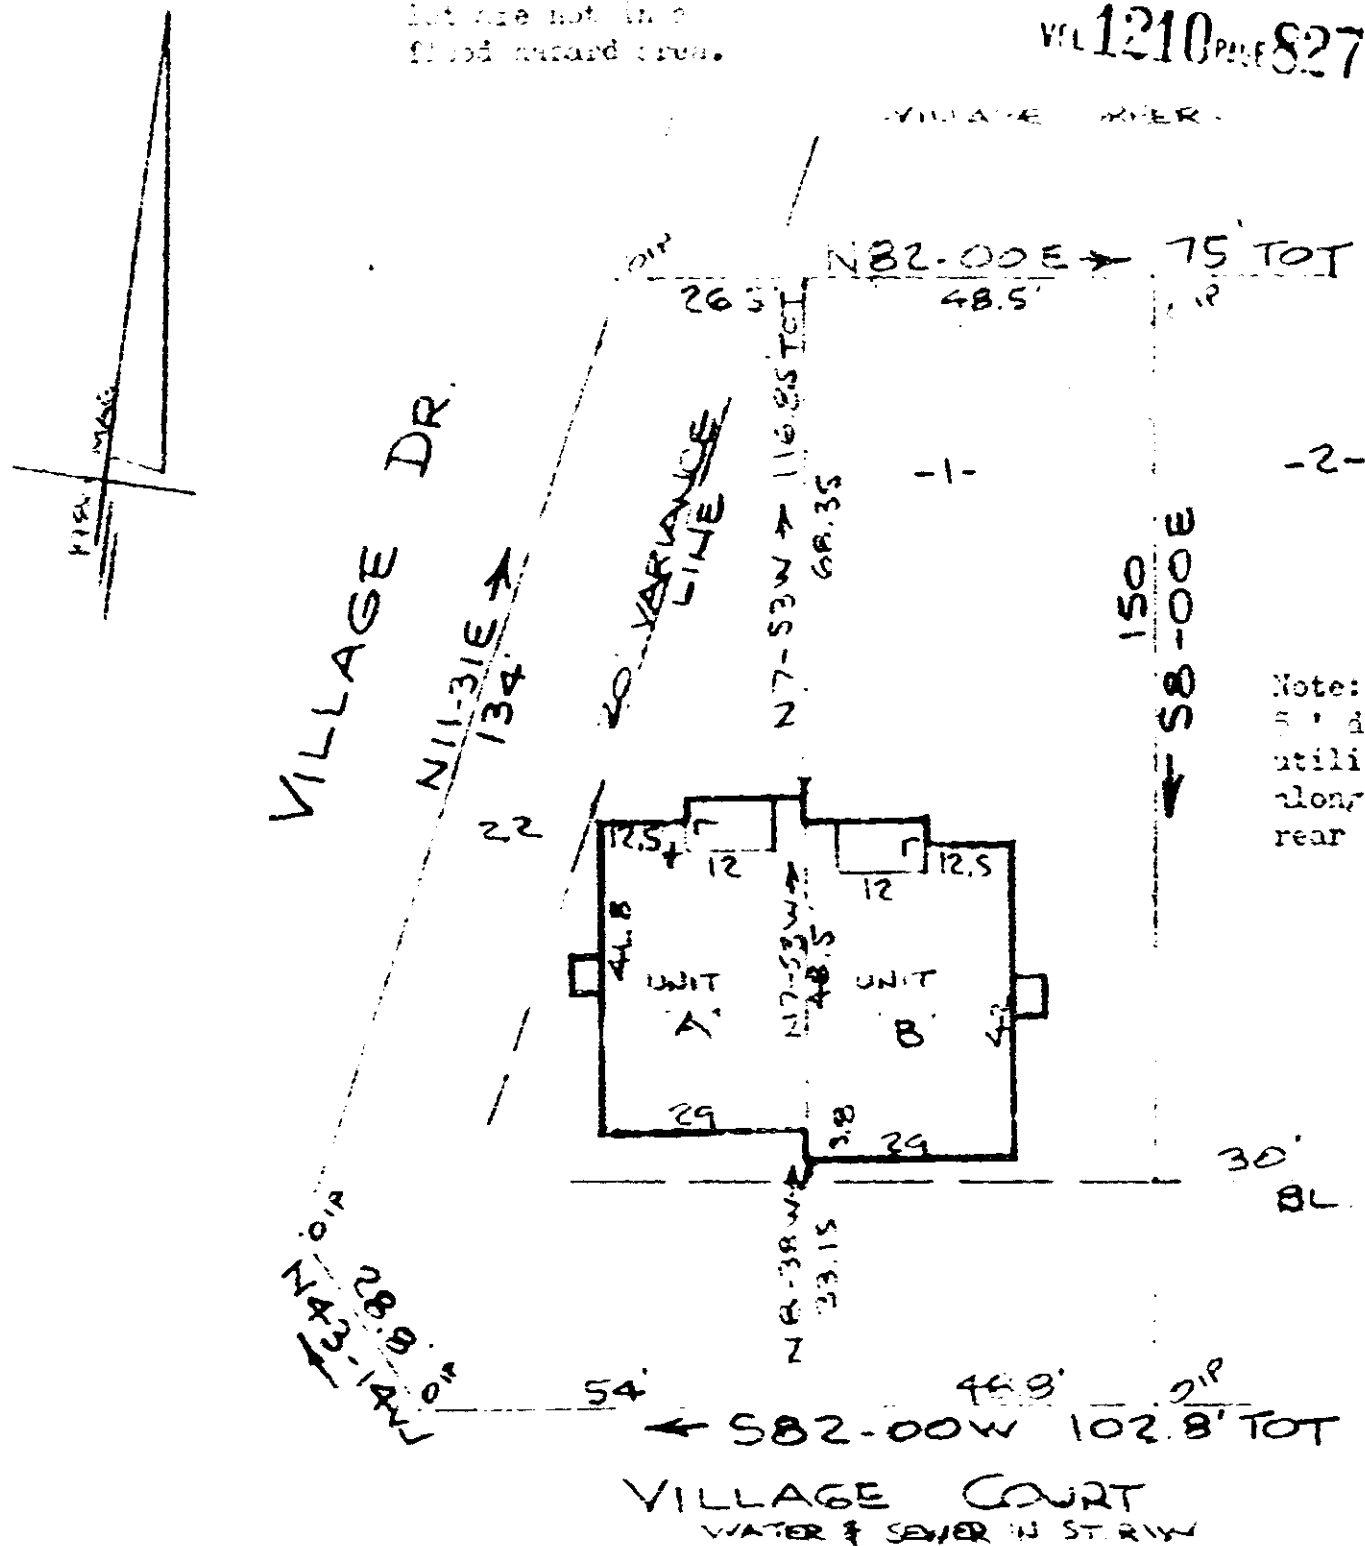

Note:
5' drainage &
utility easement
along all side &
rear lot lines.

LEGEND

BOUNDARY OF UNIT ———
LIMITED COMMON ELEMENTS

PLOT PLAN
HORIZONTAL PROPERTY REGIMES
THE VILLAGE TOWNHOUSES No 1
GREER, S.C. (GUILD CO.)
30 APR 1984

This is to certify that on the 1st day of April, 1984, a portion of the property shown on this plot, being known as Lot 1, a part of Village Court, and recorded in the office of the Greenville County, S.

[Handwritten signature]
J. J. [unclear]