


REC-55

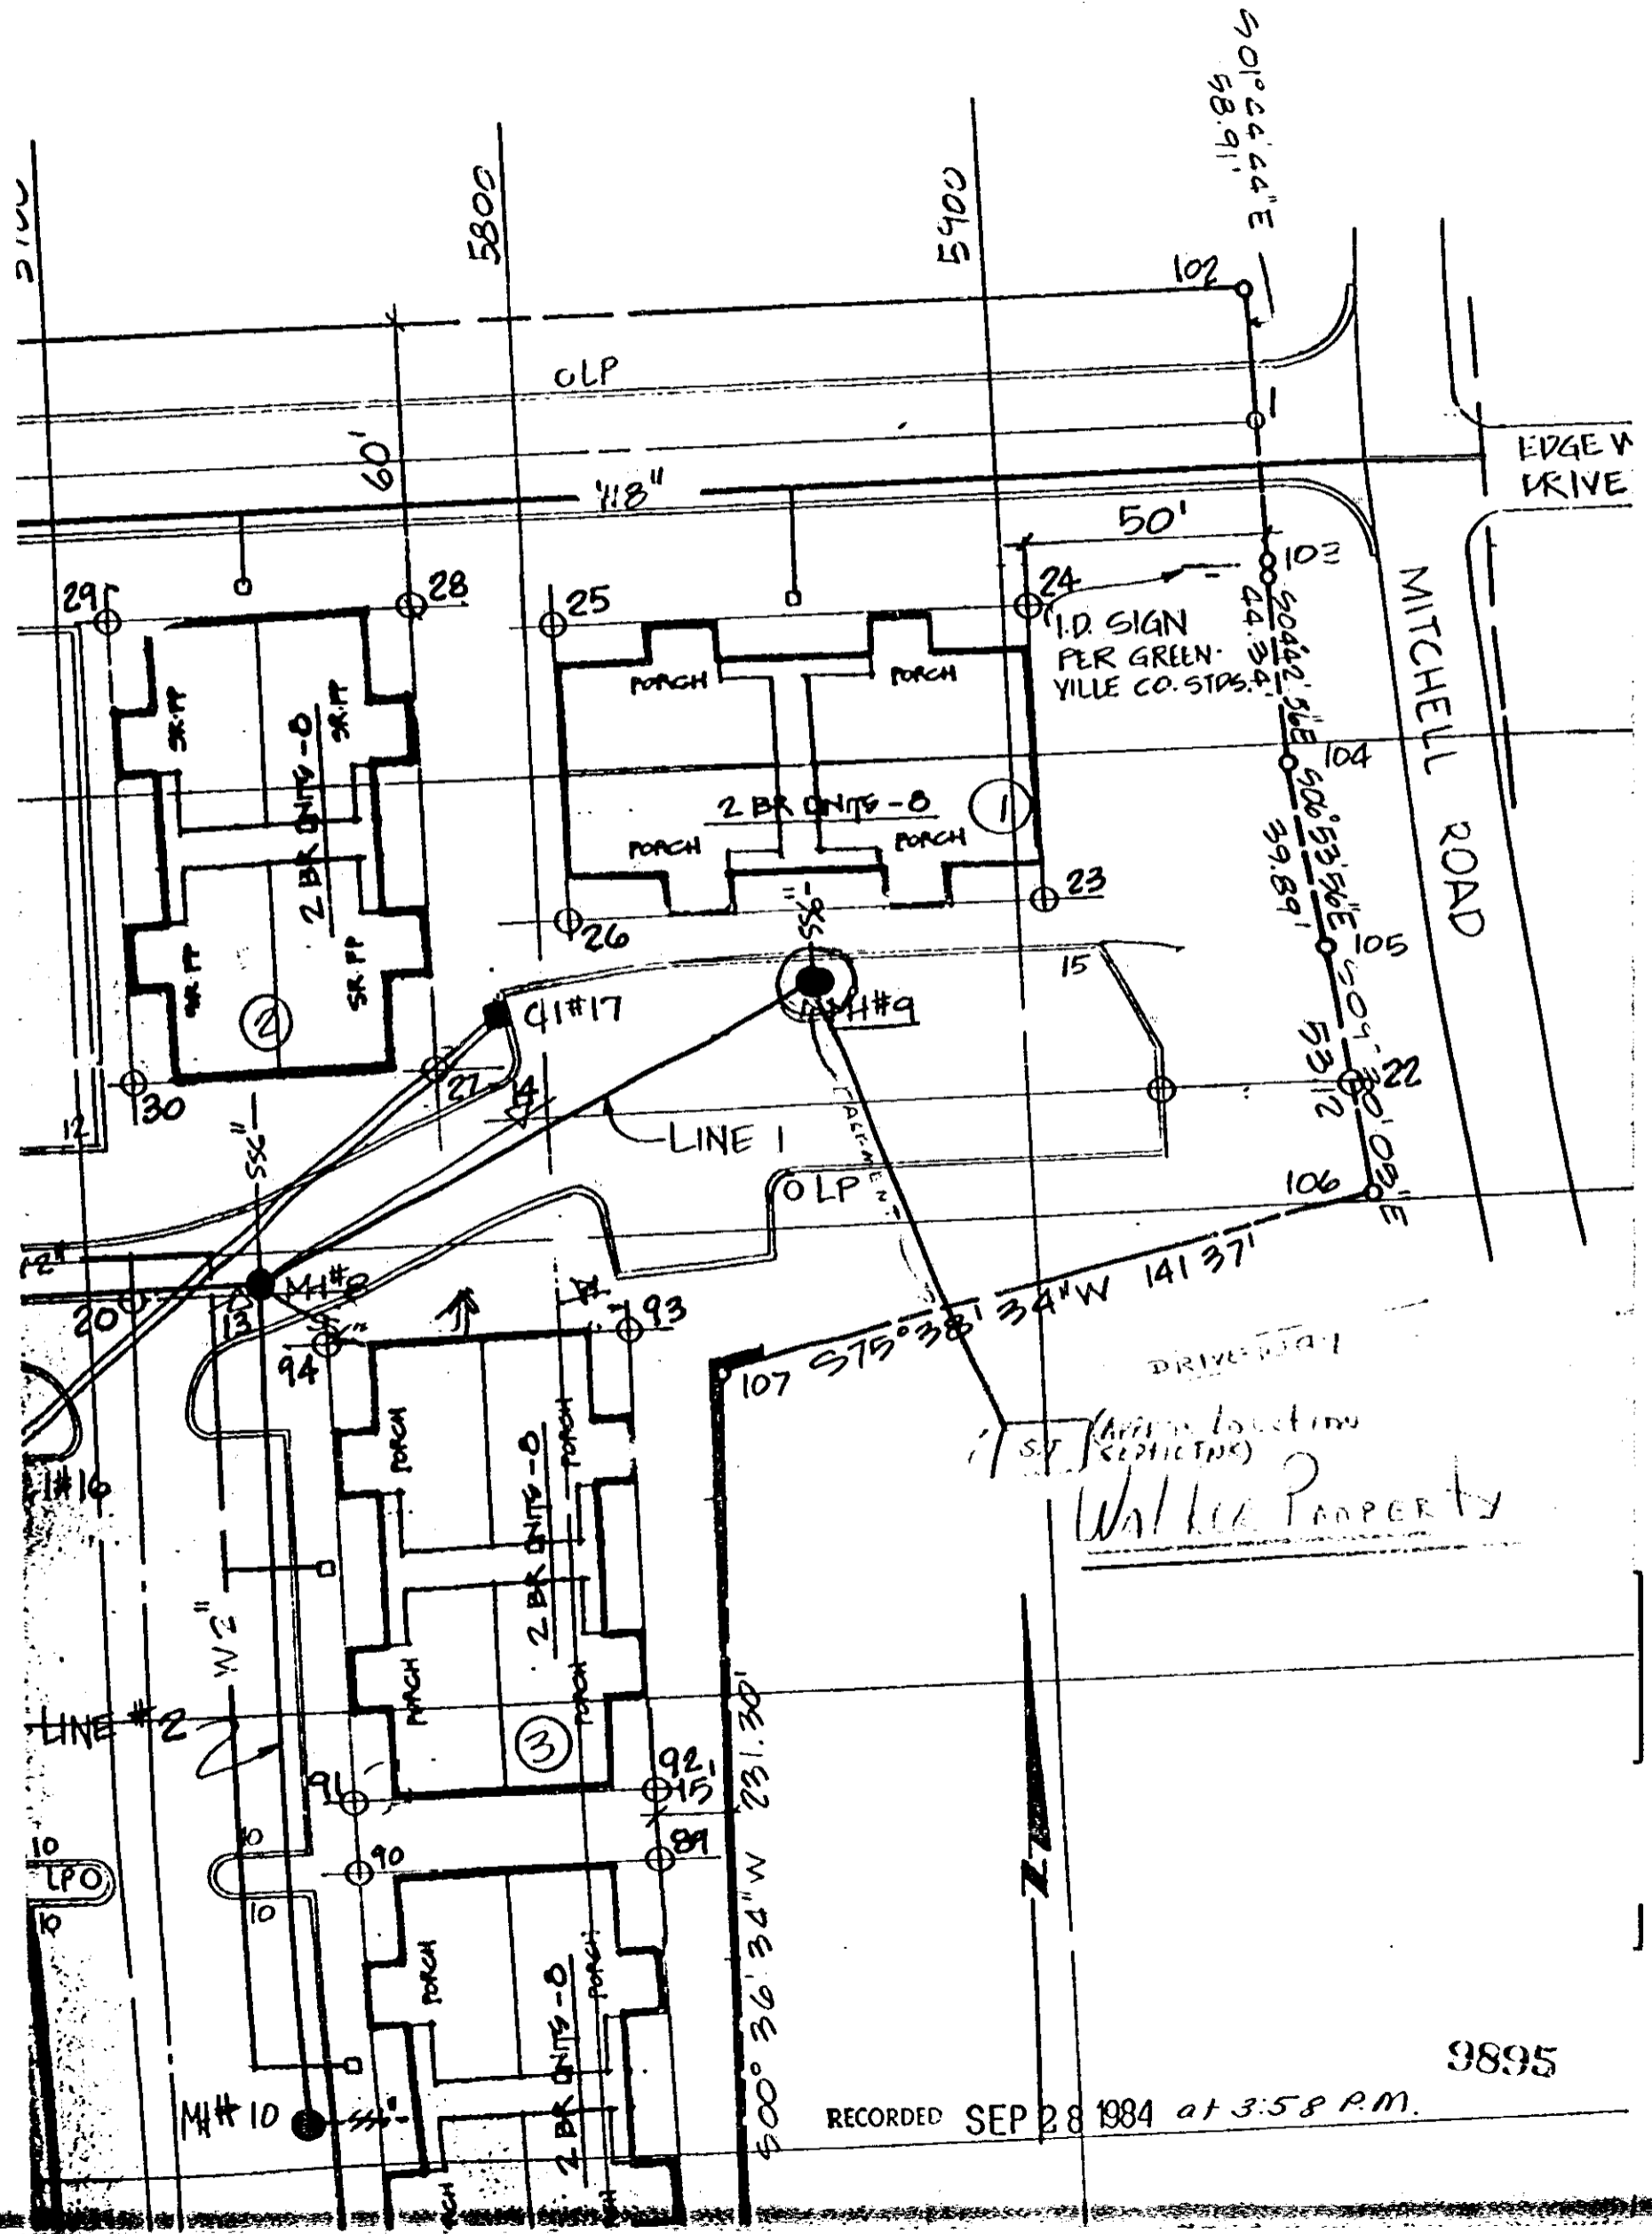

RECORDED SEP 28 1984 at 3:58 A.M.

9895

REC-55