


641
 his heirs & assigns all her interest & estate and also all her right
 & claims of Power of in and to all and singular the premises within
 mentioned & released. Given under my hand and seal this 29th of De-
 cember Anno Domini 1841
 Wm L. Pollard J. J. Mary P. Townsend
 Recorded for the 19th Jan'y 1842

Orig Deed delivered to

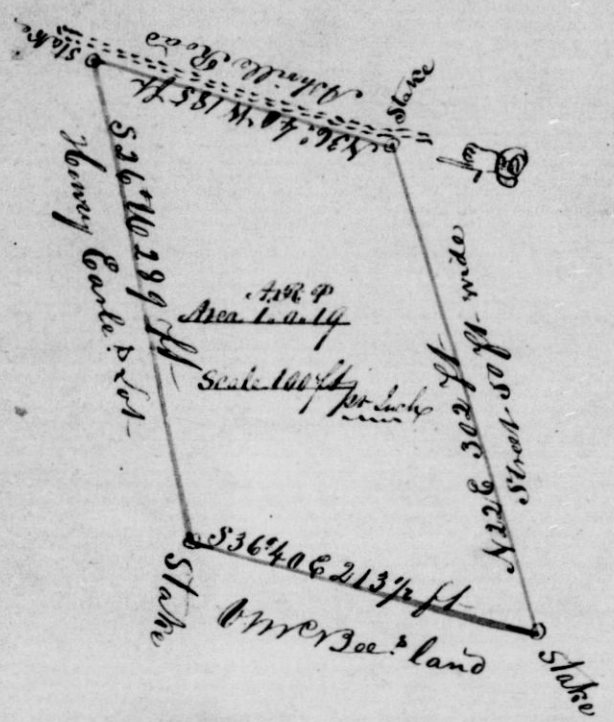

641
 South Carolina By request I have surveyed
 Greenville District and laid out a lot of land
 land sold by Vardry M. Orr Esq to Peter
 H. Gerard containing one acre and nine-tenths
 poles situate in the town of Greenville
 in said district on the Ashville or Bun-
 combe road and hath such shape-
 bounds &c as the above plat represents
 surveyed the 27 June 1838
 Jno Watson C.

Recorded for 20 Jan'y 1842. I For Records of Deeds see page 432 I
 Orig delivered to

641
 John H. Rosamond Deed of Sale for 500 Acres of Land

Thomas J. Gantt State of South Carolina Know all men by
 Greenville District these presents that
 I John H. Rosamond of Anderson District and State of South
 Carolina for and in consideration of Eight Hundred Dollars secu-
 red to be paid to me by Thomas John Gantt of the City of
 Charleston which is hereby acknowledged have given granted bar-
 gained and sold and by these presents doth give grant bargain
 and sell unto the said Thomas John Gantt his heirs and
 assigns all that tract of land situate in Greenville Dis-
 trict on the Waters of Saluda River being the tract of land
 formerly owned by John Gordon and containing five Hundred
 acres be the same more or less being part of a tract of
 land granted to Harris Mullen but surveyed for John Huger
 and conveyed to the said John Gordon (dec'd) by Waddy Thompson
 and hath such bounds mark'd &c as follows viz
 Beginning on a Dead Oak 37 running thence N. 80 to a P. Oak 34 thence
 E about 35 or 40 to the Road, thence along a perpendicular line (now
 Richard Gantt's) to the Old Original line. thence along the
 original line to the beginning. Together with all and singular
 rights members and appurtenances of every kind