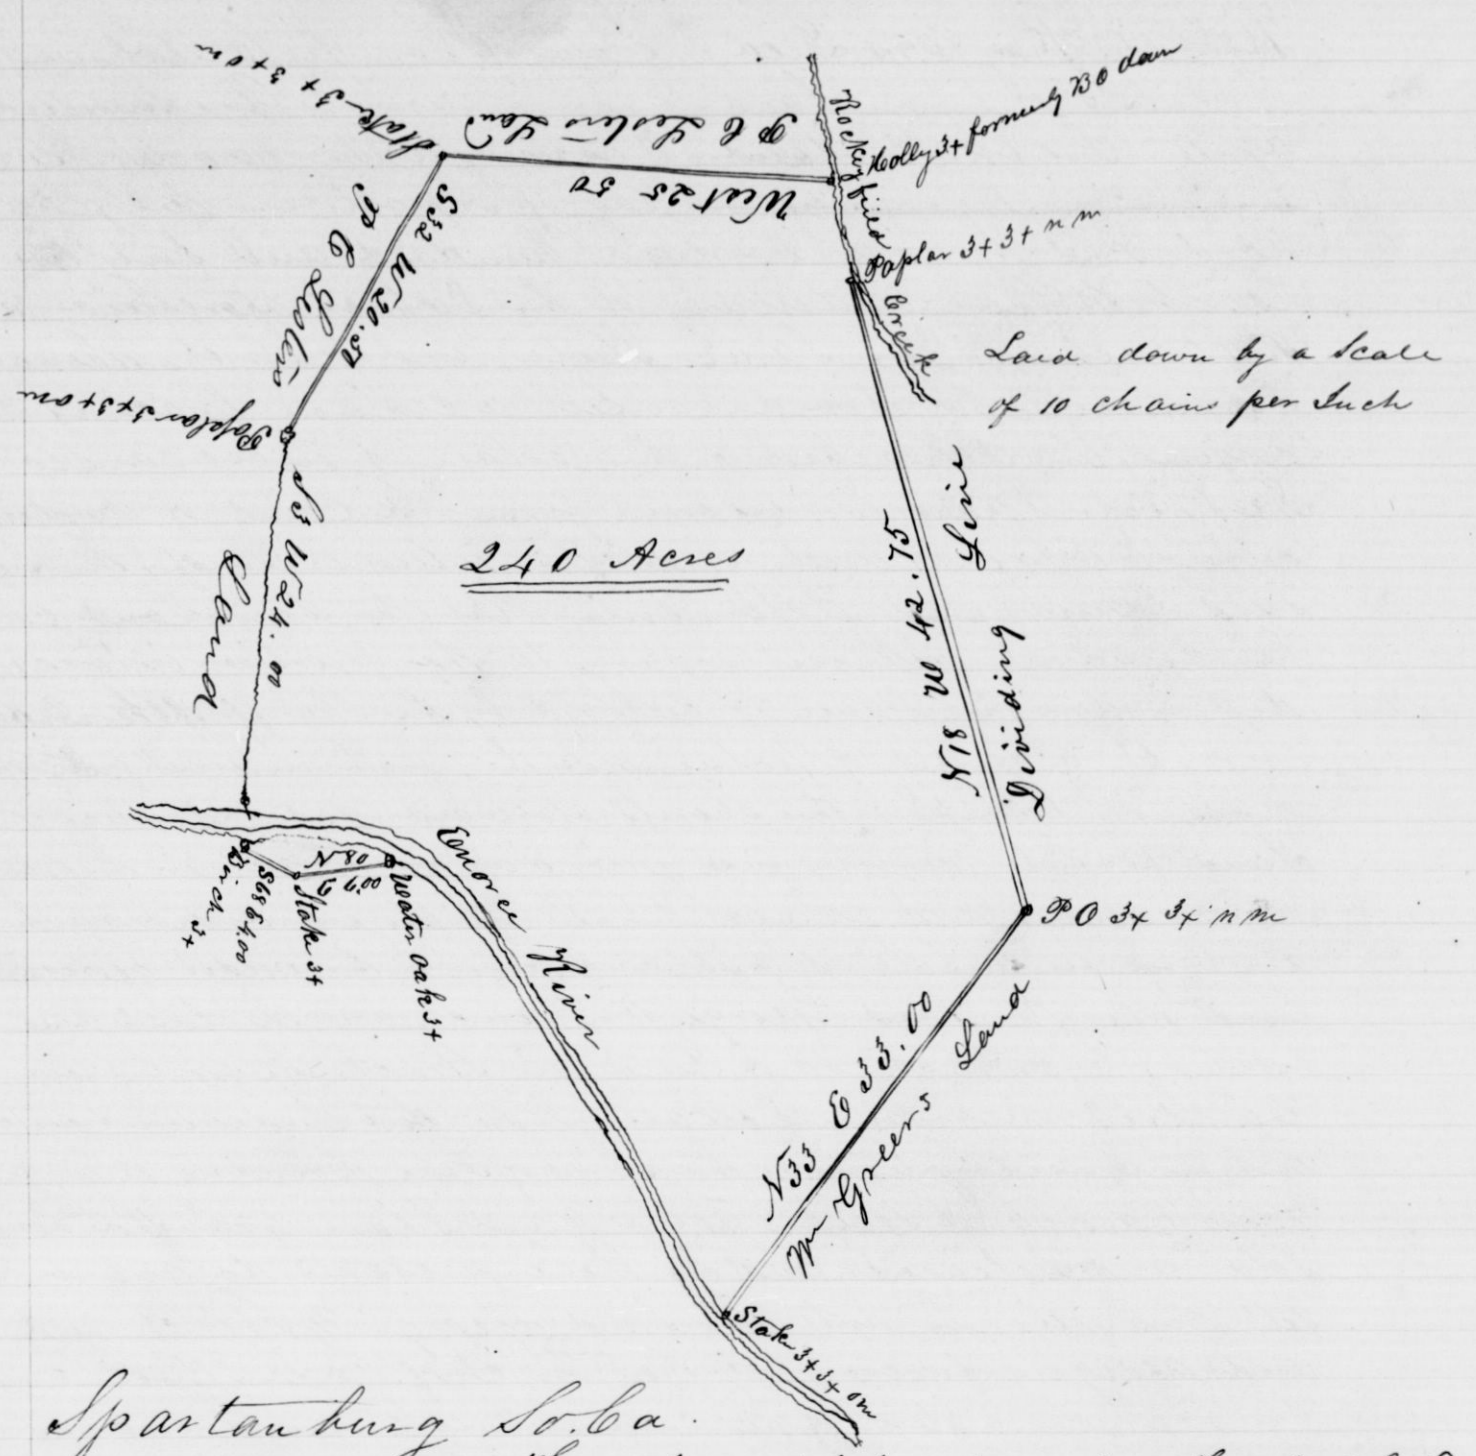

Spartanburg So. Ca.

The above plat represents a Tract of land laid of by the Executors of Josiah Kilgon Decd being a part of the Real Estate of said Deceased lying on Enoree River known as the Forge Tract Containing 240 Acres and hath such forms and marks as the above represents

Nov 1st 1860

J W Wood S.

H P Hammett