


#2204 PLAT 32 of Sept 10 69

And Recorded in Vol. 4C at 67 of 445 P. 27

Ollie Farnsworth

Register of Deeds, Greenville County, S. C.

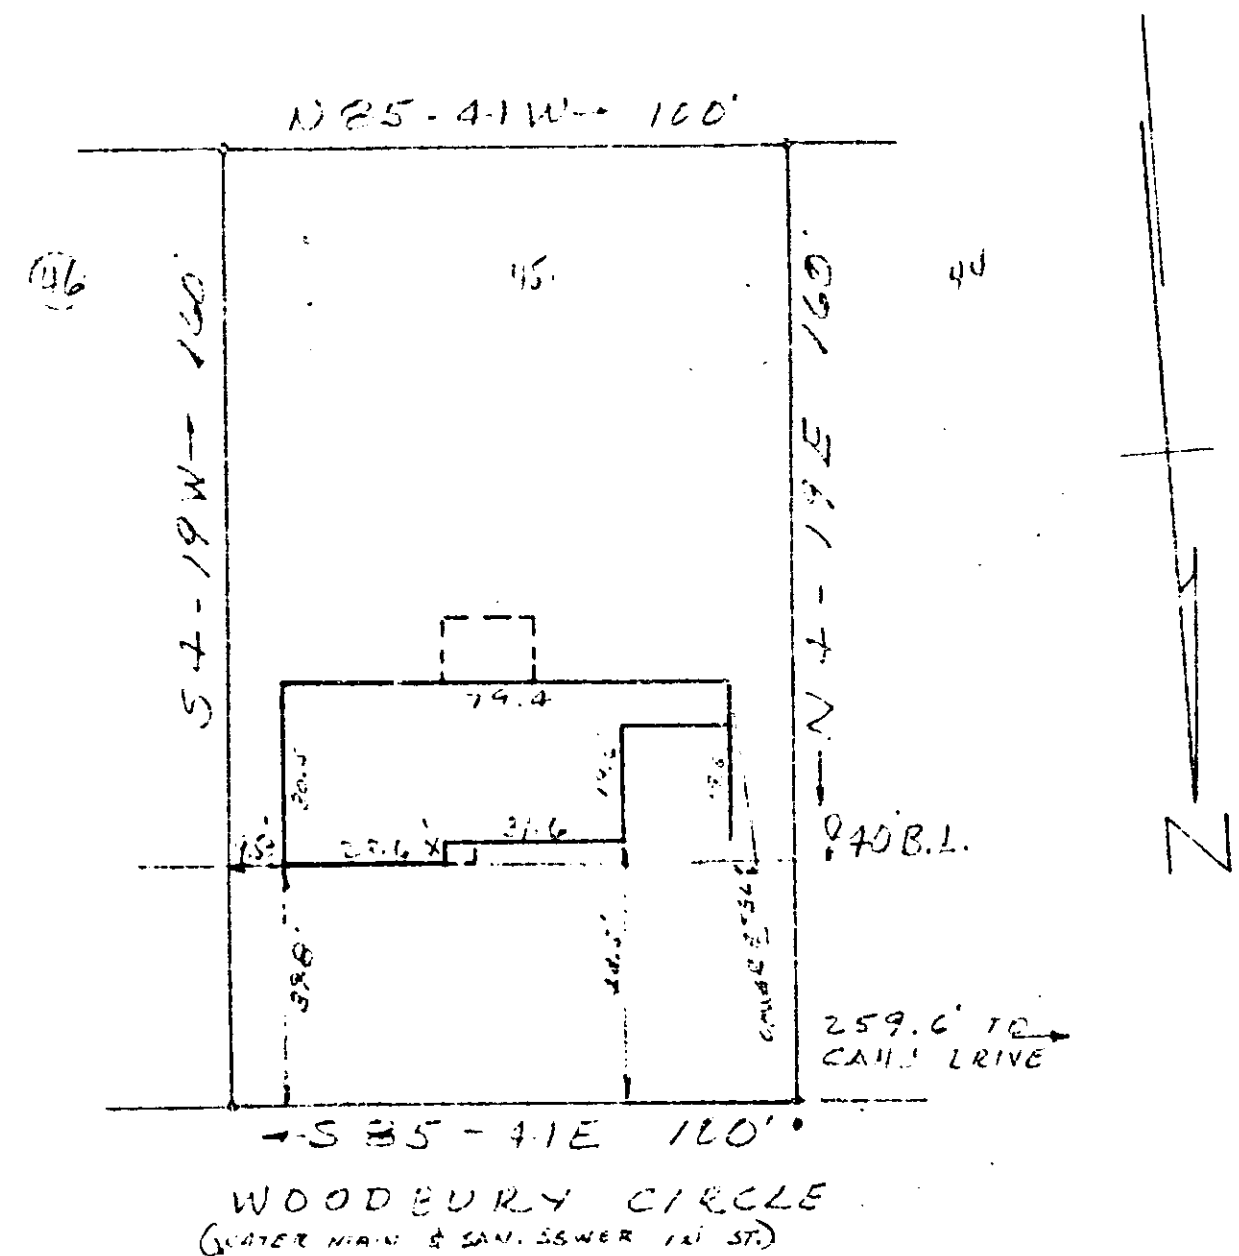

PROPERTY OF
 JAMES DRISCOLL NEAFSEY
 &
 ELIZABETH A. NEAFSEY
 NEAR GREENVILLE, S. C.
 SEPT. 25, 1969 SCALE 1"=40'

FILED
 GREENVILLE CO. S. C.
 SEP 20 4 45 PM '69
 OLLIE FARNSWORTH
 R.M.C.

This is to certify that on Sept. 25, 1969 I surveyed the property shown on this plat, known as lot No. 15 on plat of Broadmoor filed in the R.C. Office for Greenville Co. in Plat Book RR at page 117, and that the property lines, walls and buildings are as shown hereon, and that the building located on said lot does not project nor encroach on adjacent streets or property, and that no adjacent wells or buildings project nor encroach on said lot, and that no utility lines cross this lot except as shown hereon.

Survey by Campbell & Clarke
 Surveyors, Inc.

Handwritten signature
 S. C. No. 1539

4C-67
 507

7891

P16.2

