


11134 Filed This 12 day of Nov. 1969
And Recorded in Vol. 44 C Page 147 8:40 A.M.
Ollie Farnsworth
Register Mesne Conveyance Greenville County, S. C.

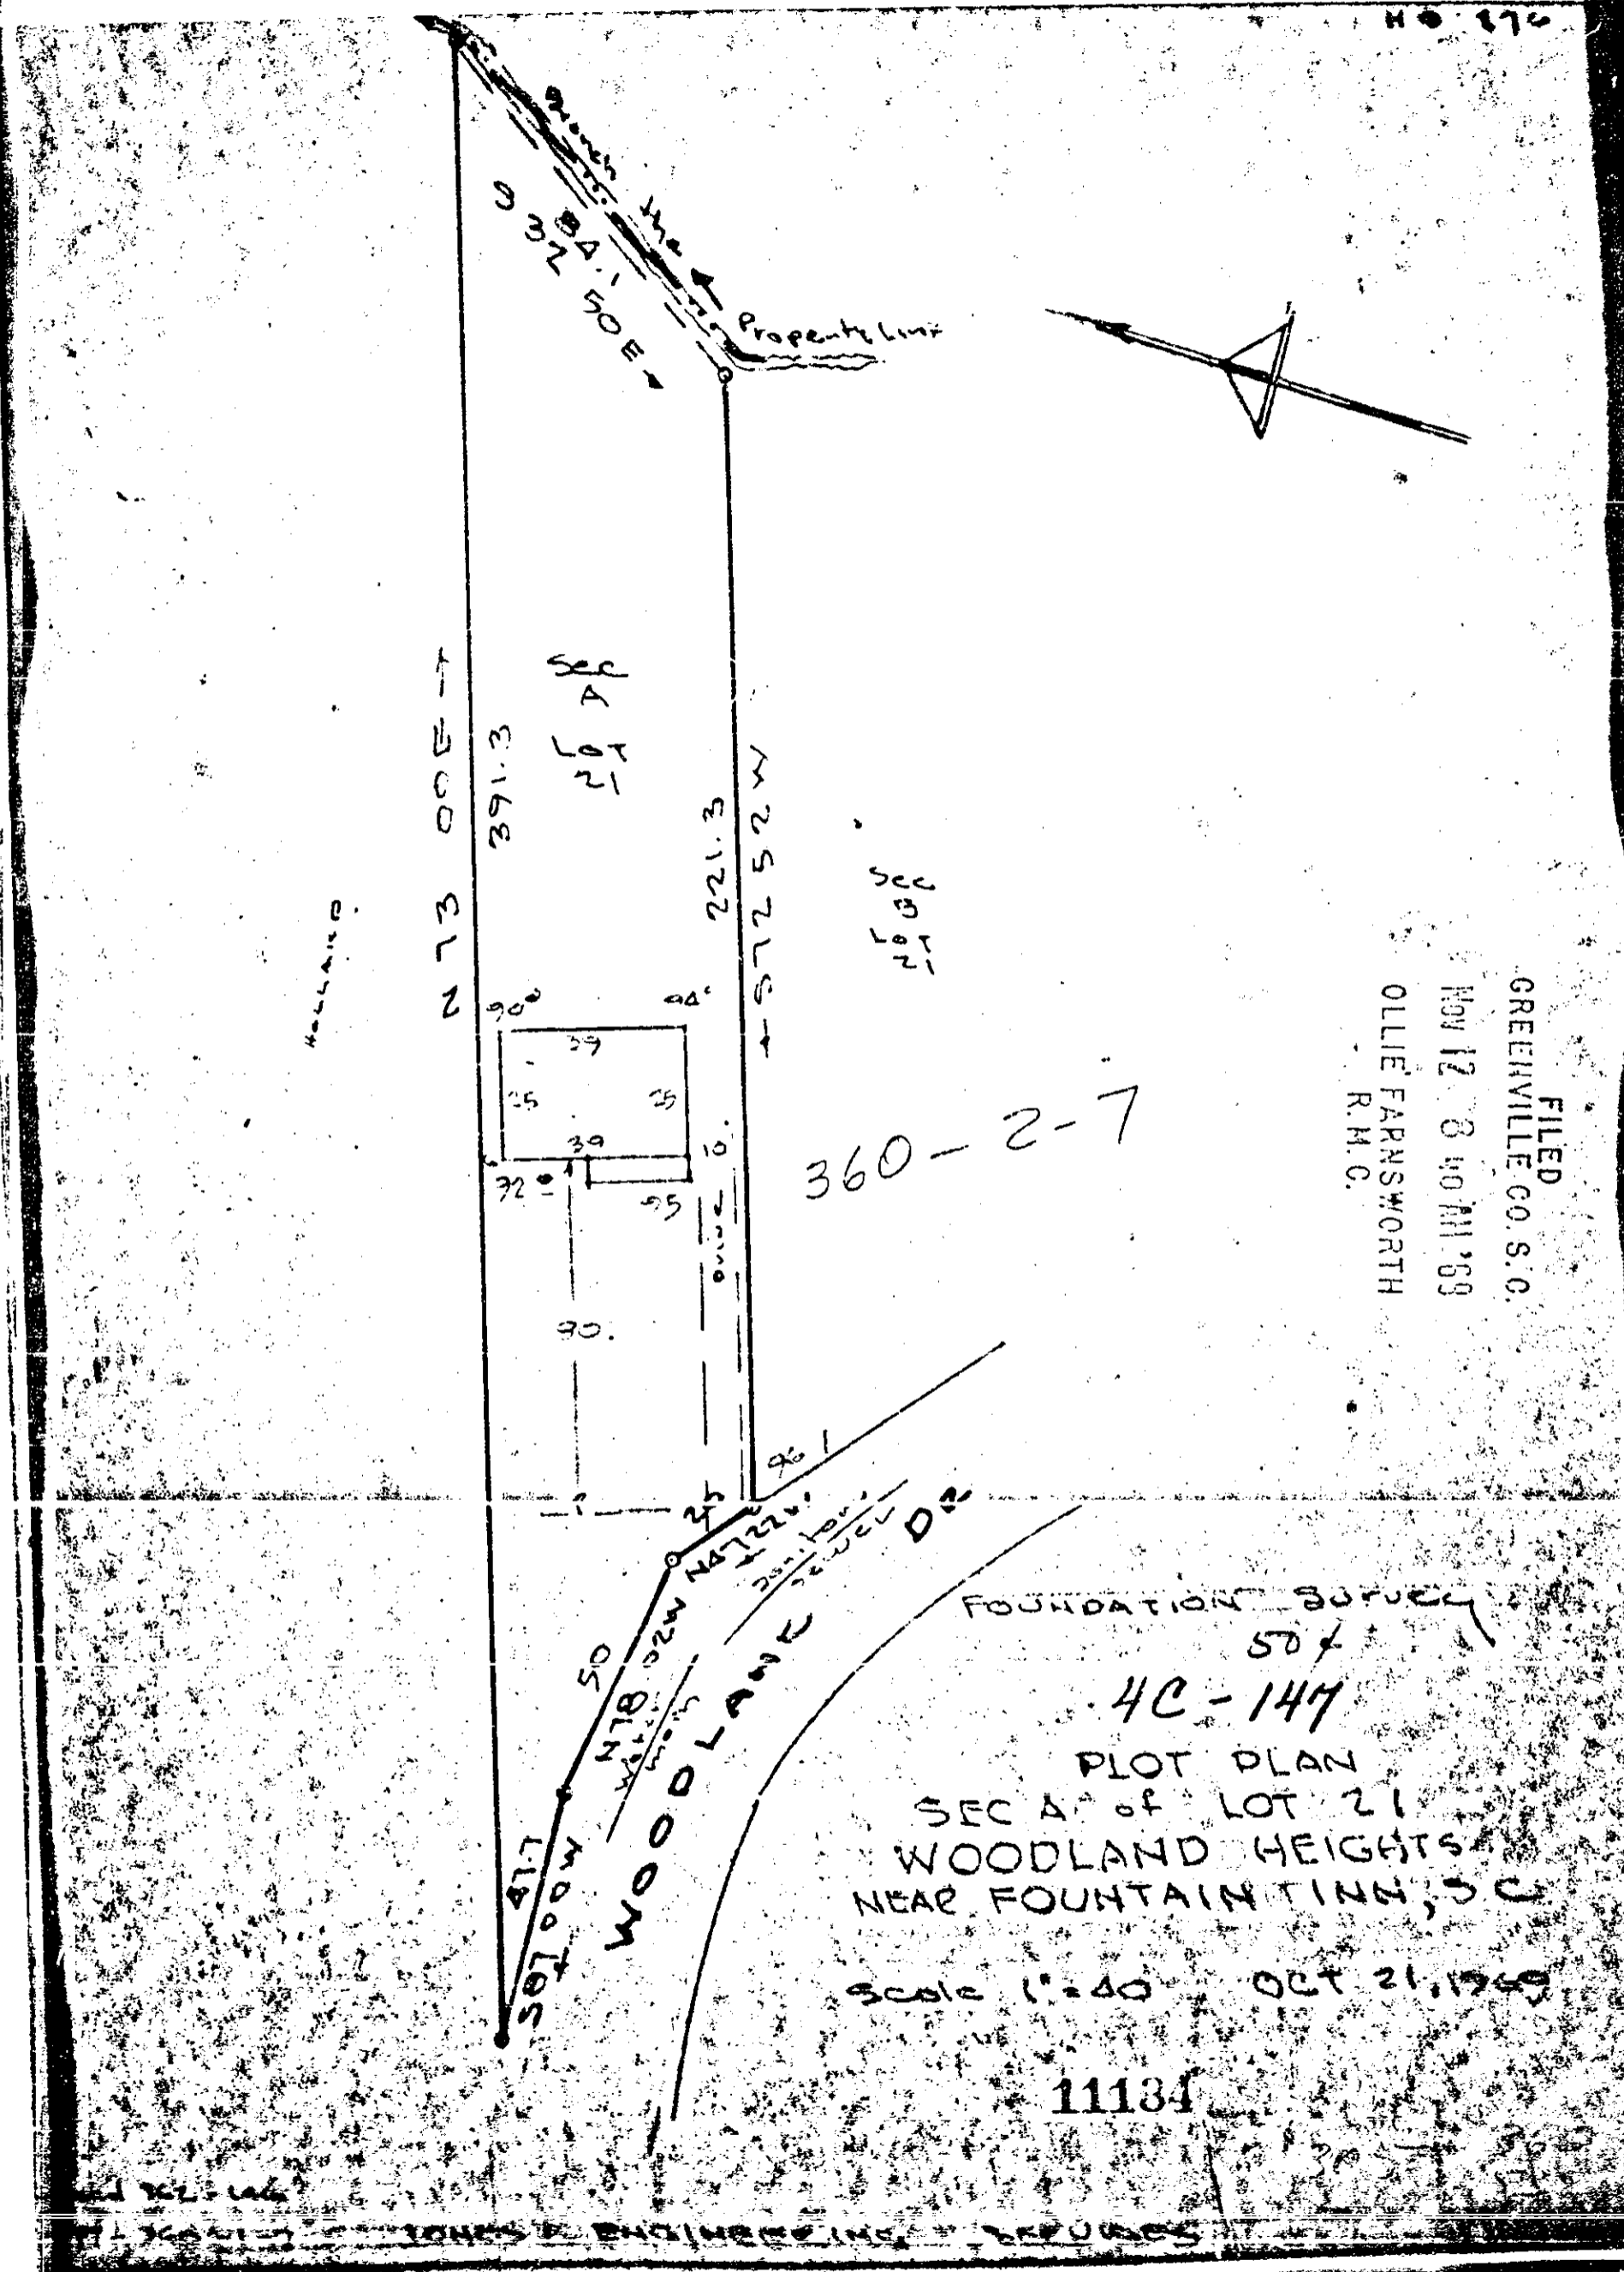

FILED
GREENVILLE CO. S. C.
NOV 12 3 40 AM '69
OLLIE FARNSWORTH
R.M.C.

360-2-7

FOUNDATION SURVEY
SD
4C-147
PLOT PLAN
SEC 4 of LOT 21
WOODLAND HEIGHTS
NEAR FOUNTAIN TOWN, S.C.
Scale 1"=40' OCT 21, 1969
11134

