


#12830 Filed This 3rd day of Dec 1969
And Recorded in Vol. 4C Page 189 5:01 P.
Ollie Eartsworth
Register of Deeds Greenville County, S. C.


Dec 8 5 01 PM '69
OLLIE EARTSWORTH
R.H.O.

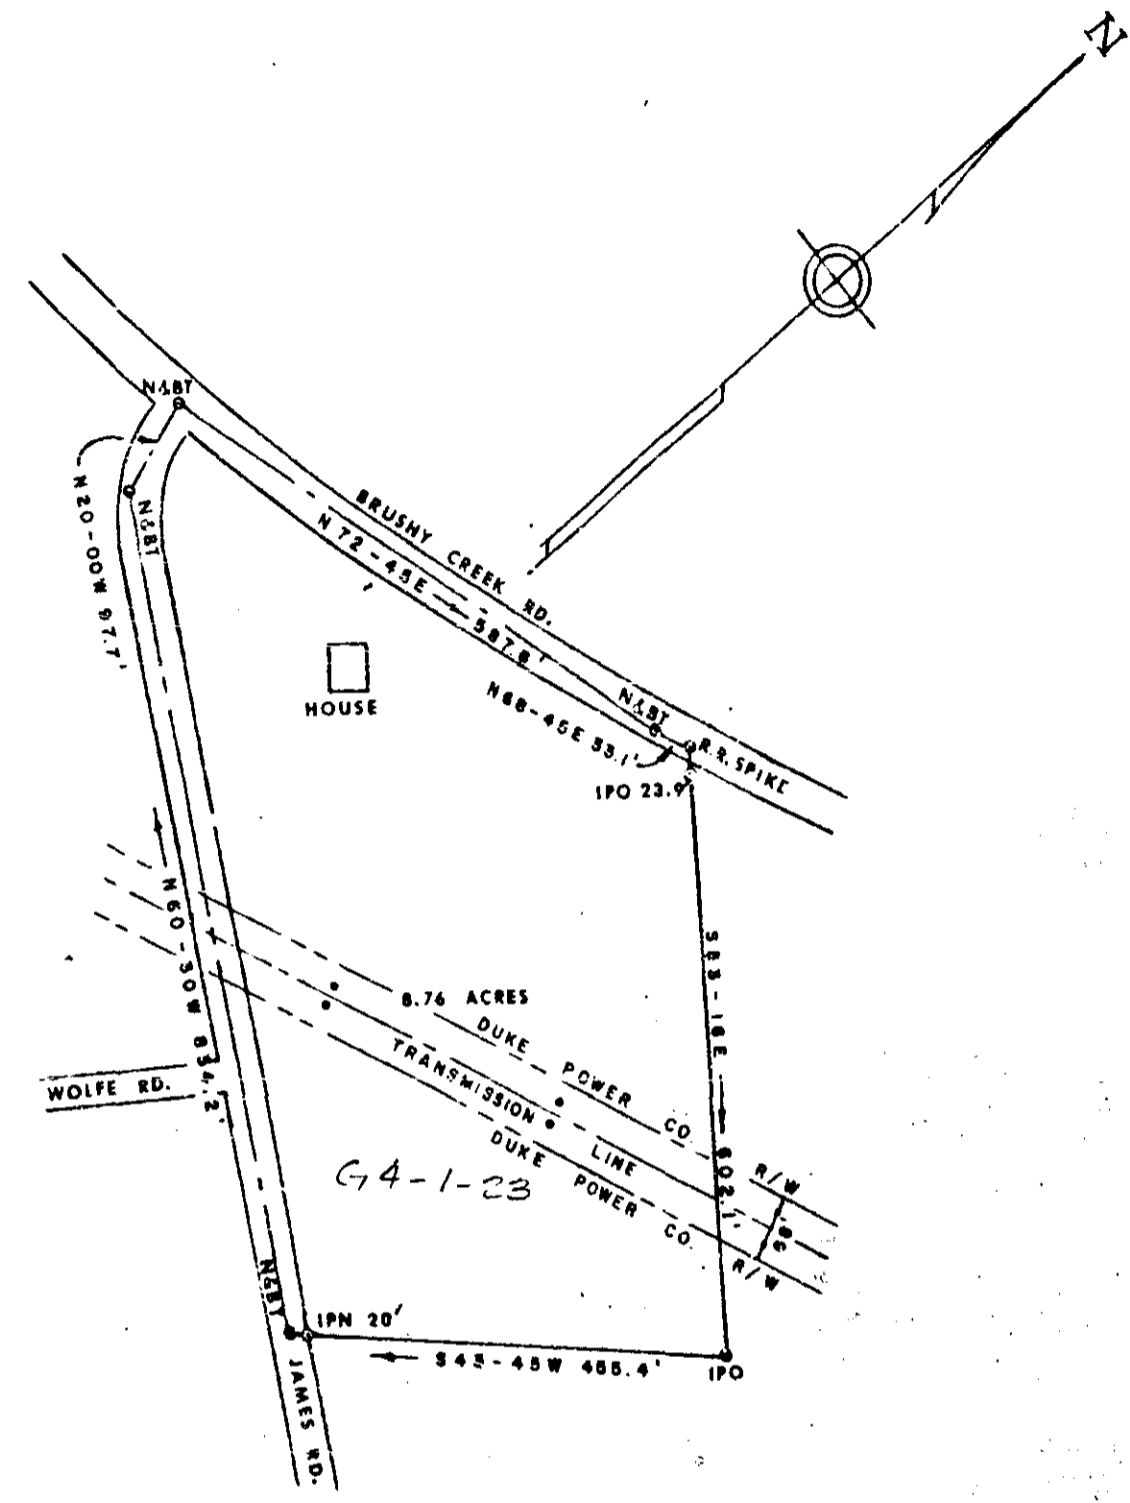

PROPERTY SURVEY
FOR
WILLIAM STRAUSS
GREENVILLE COUNTY
NEAR GREER, SOUTH CAROLINA

12830

Scale 1" = 200' October 28, 1969

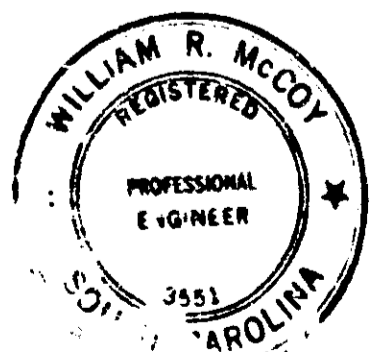

4C-189

REF GREENVILLE COUNTY BLOCK BOOK
PAGE G-4, BLOCK 1, TRACT 23.
DEED BOOK 39, PAGE 262.

This is to certify that on the above date
we surveyed the property shown on this plat
and that the lines are as shown hereon.

William R. McCoy

William R. McCoy
Reg. Engr. & L. S. #3551

enwright associates
GREENVILLE, S. C.

