


EDINBURGH COURT

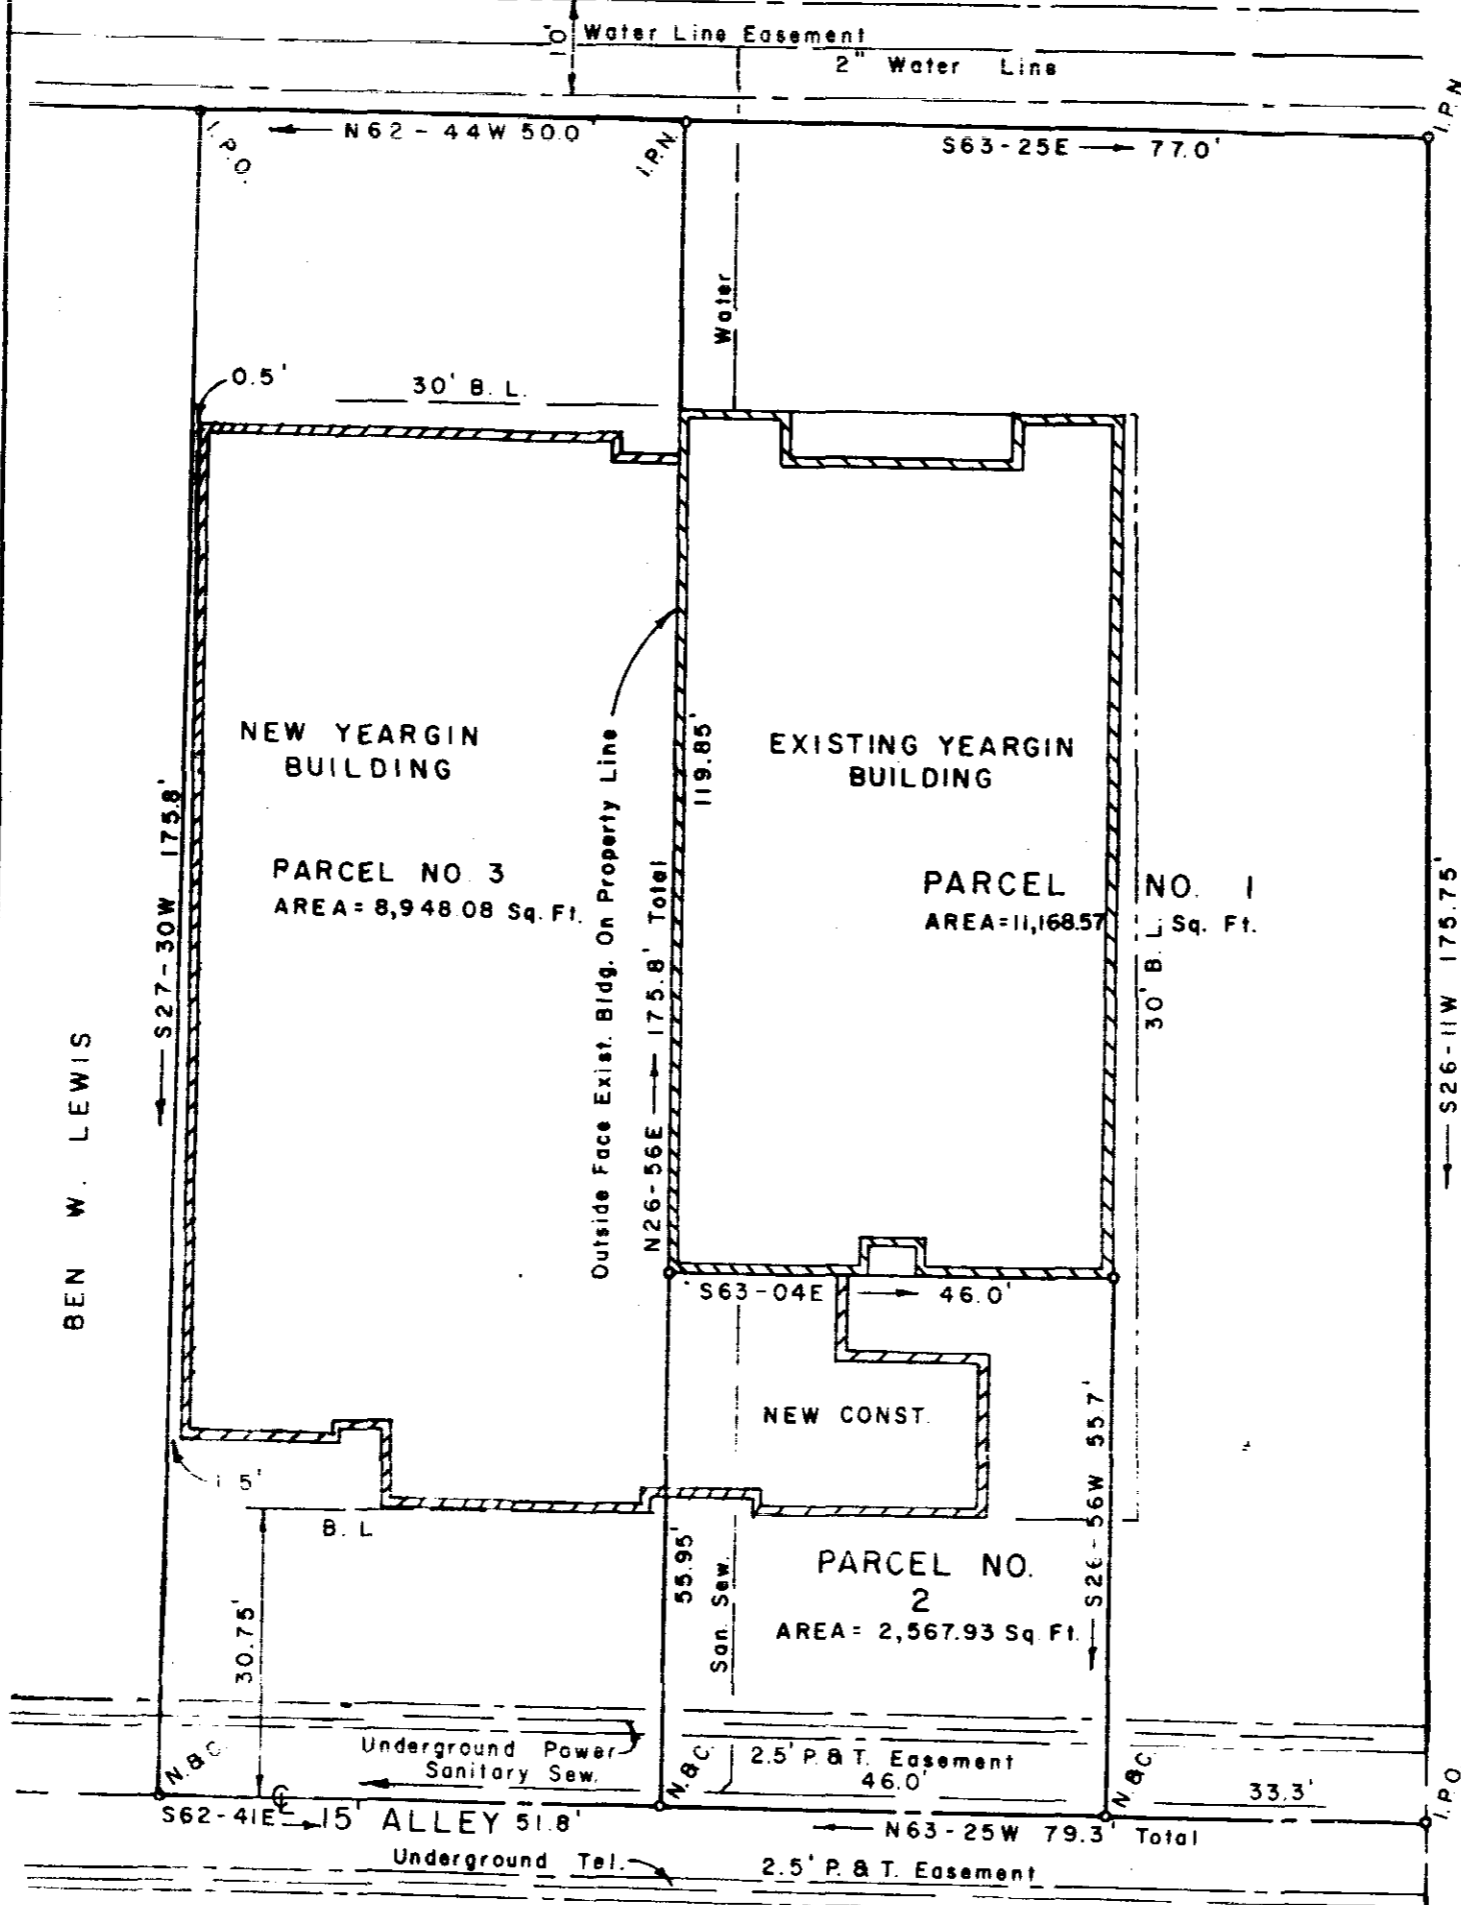

FREDERICK STREET

NOTE:
UNDERGROUND POWER & TEL. SERVICE
FROM ALLEY TO EXISTING BUILDING

PROPERTY OF
R. H. YEARGIN
GREENVILLE, S. C.

SCALE 1" = 20' MAY 22, 1970
REVISED JULY 24, 1970

This is to certify that on this date, the lot shown above was surveyed by me; and that property lines, walls, and buildings are as shown; that the buildings located on said property do not project or encroach on adjacent streets or property; and that no adjacent buildings or walls encroach or project on said premises. No utility lines cross this property except as shown.

101-97

8446 ✓
OCT 8 1970

FINAL PLAN APPROVED
GREENVILLE CITY PLANNING DEPARTMENT
DATE 10-8-70 BY [Signature]
SECRETARY OF COMMISSION

4/6/101
\$1.50



enwright associates
ENGINEERS
GREENVILLE, S.C.

JOHN E. WOODS
R.L.S. NO. 3980
OLIE FARNSWORTH
R.M.C.

FILED
GREENVILLE CO. S.C.