


NO.	DATE	REVISION	BY

PARCEL NO.	AREA
1	2.7± Ac.
2	1.7± "
2.1	0.1± "
3	3.5± "

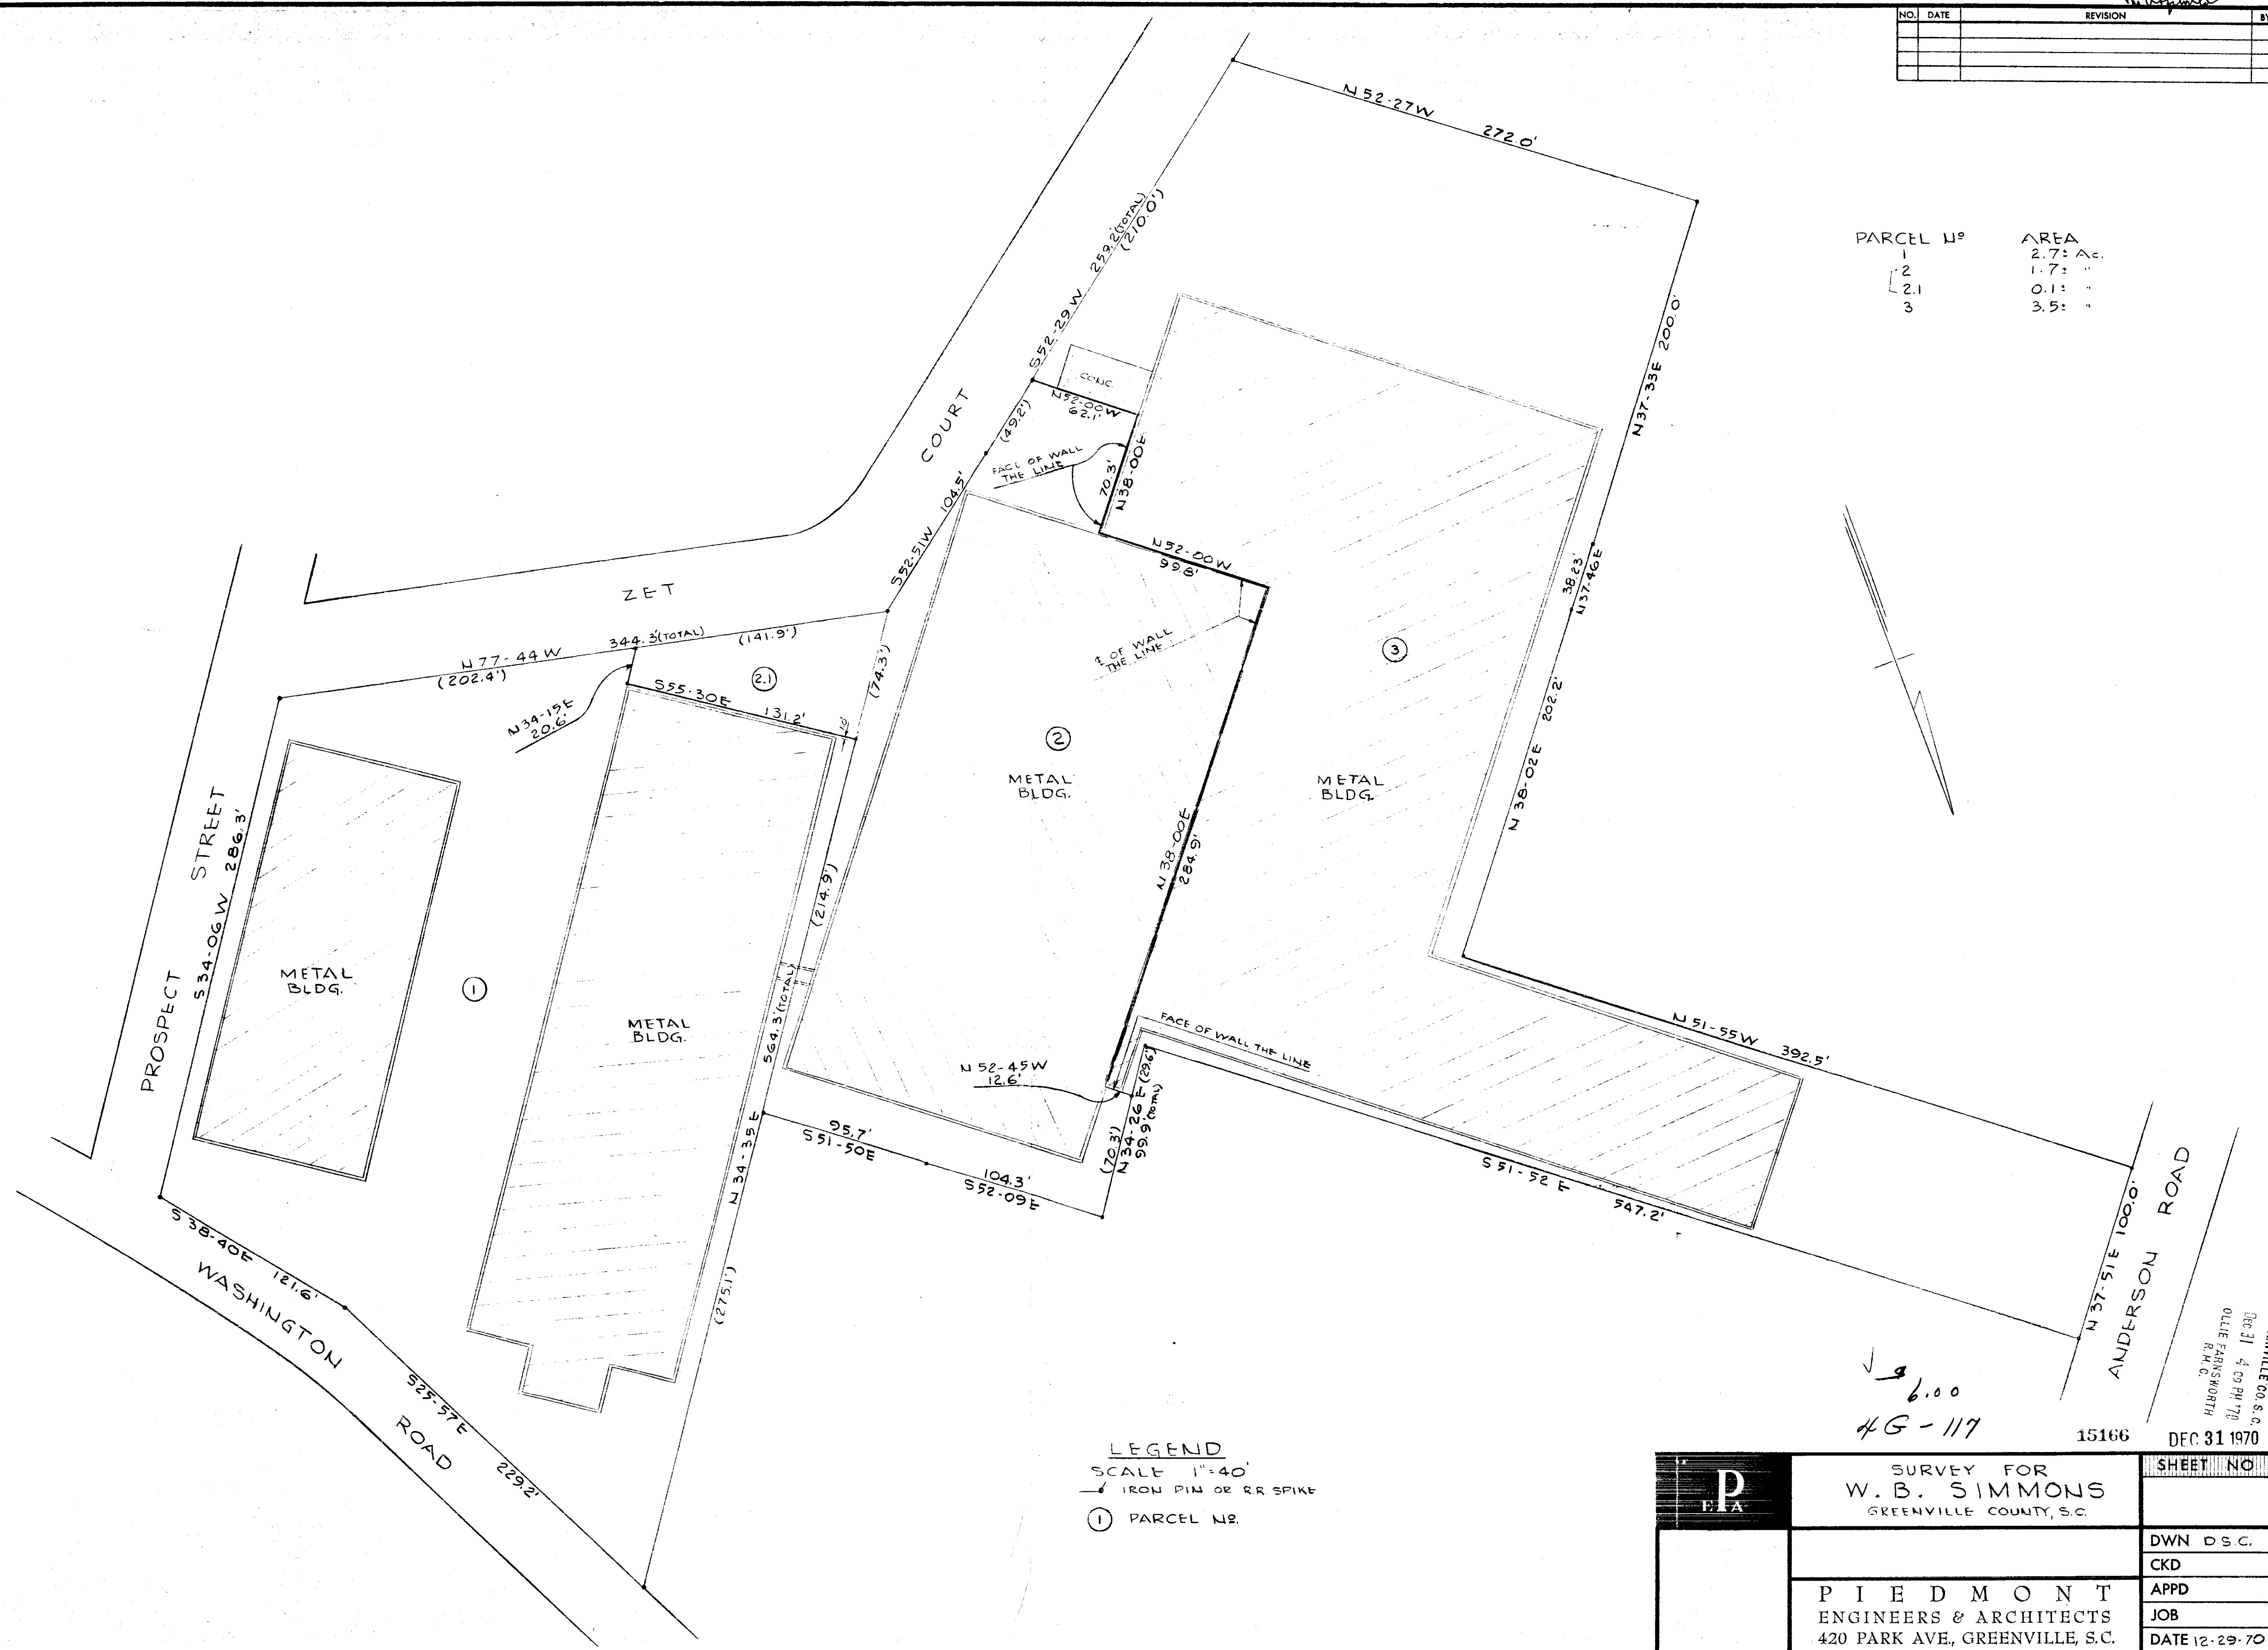

**LEGEND**  
 SCALE 1"=40'  
 IRON PIN OR RR SPIKE  
 ① PARCEL NO.

6.00  
 46-117

<b>P</b> FLA	SURVEY FOR <b>W. B. SIMMONS</b> GREENVILLE COUNTY, S.C.	SHEET NO.
	<b>PIEDMONT</b> ENGINEERS & ARCHITECTS 420 PARK AVE., GREENVILLE, S.C.	DWN D.S.C. CKD APPD JOB DATE 12-29-70

GREENVILLE CO., S.C.  
 DEC 31 4 09 PM '70  
 OLLE FARNSWORTH  
 R.M.C.

15166 DEC 31 1970