


7157 Filed This 7 day of Sept 1971
And Recorded in Vol. 49 Page 71 9:30 A.M.
Ollie Starnworth
Register Mesne Conveyance Greenville County, S. C.

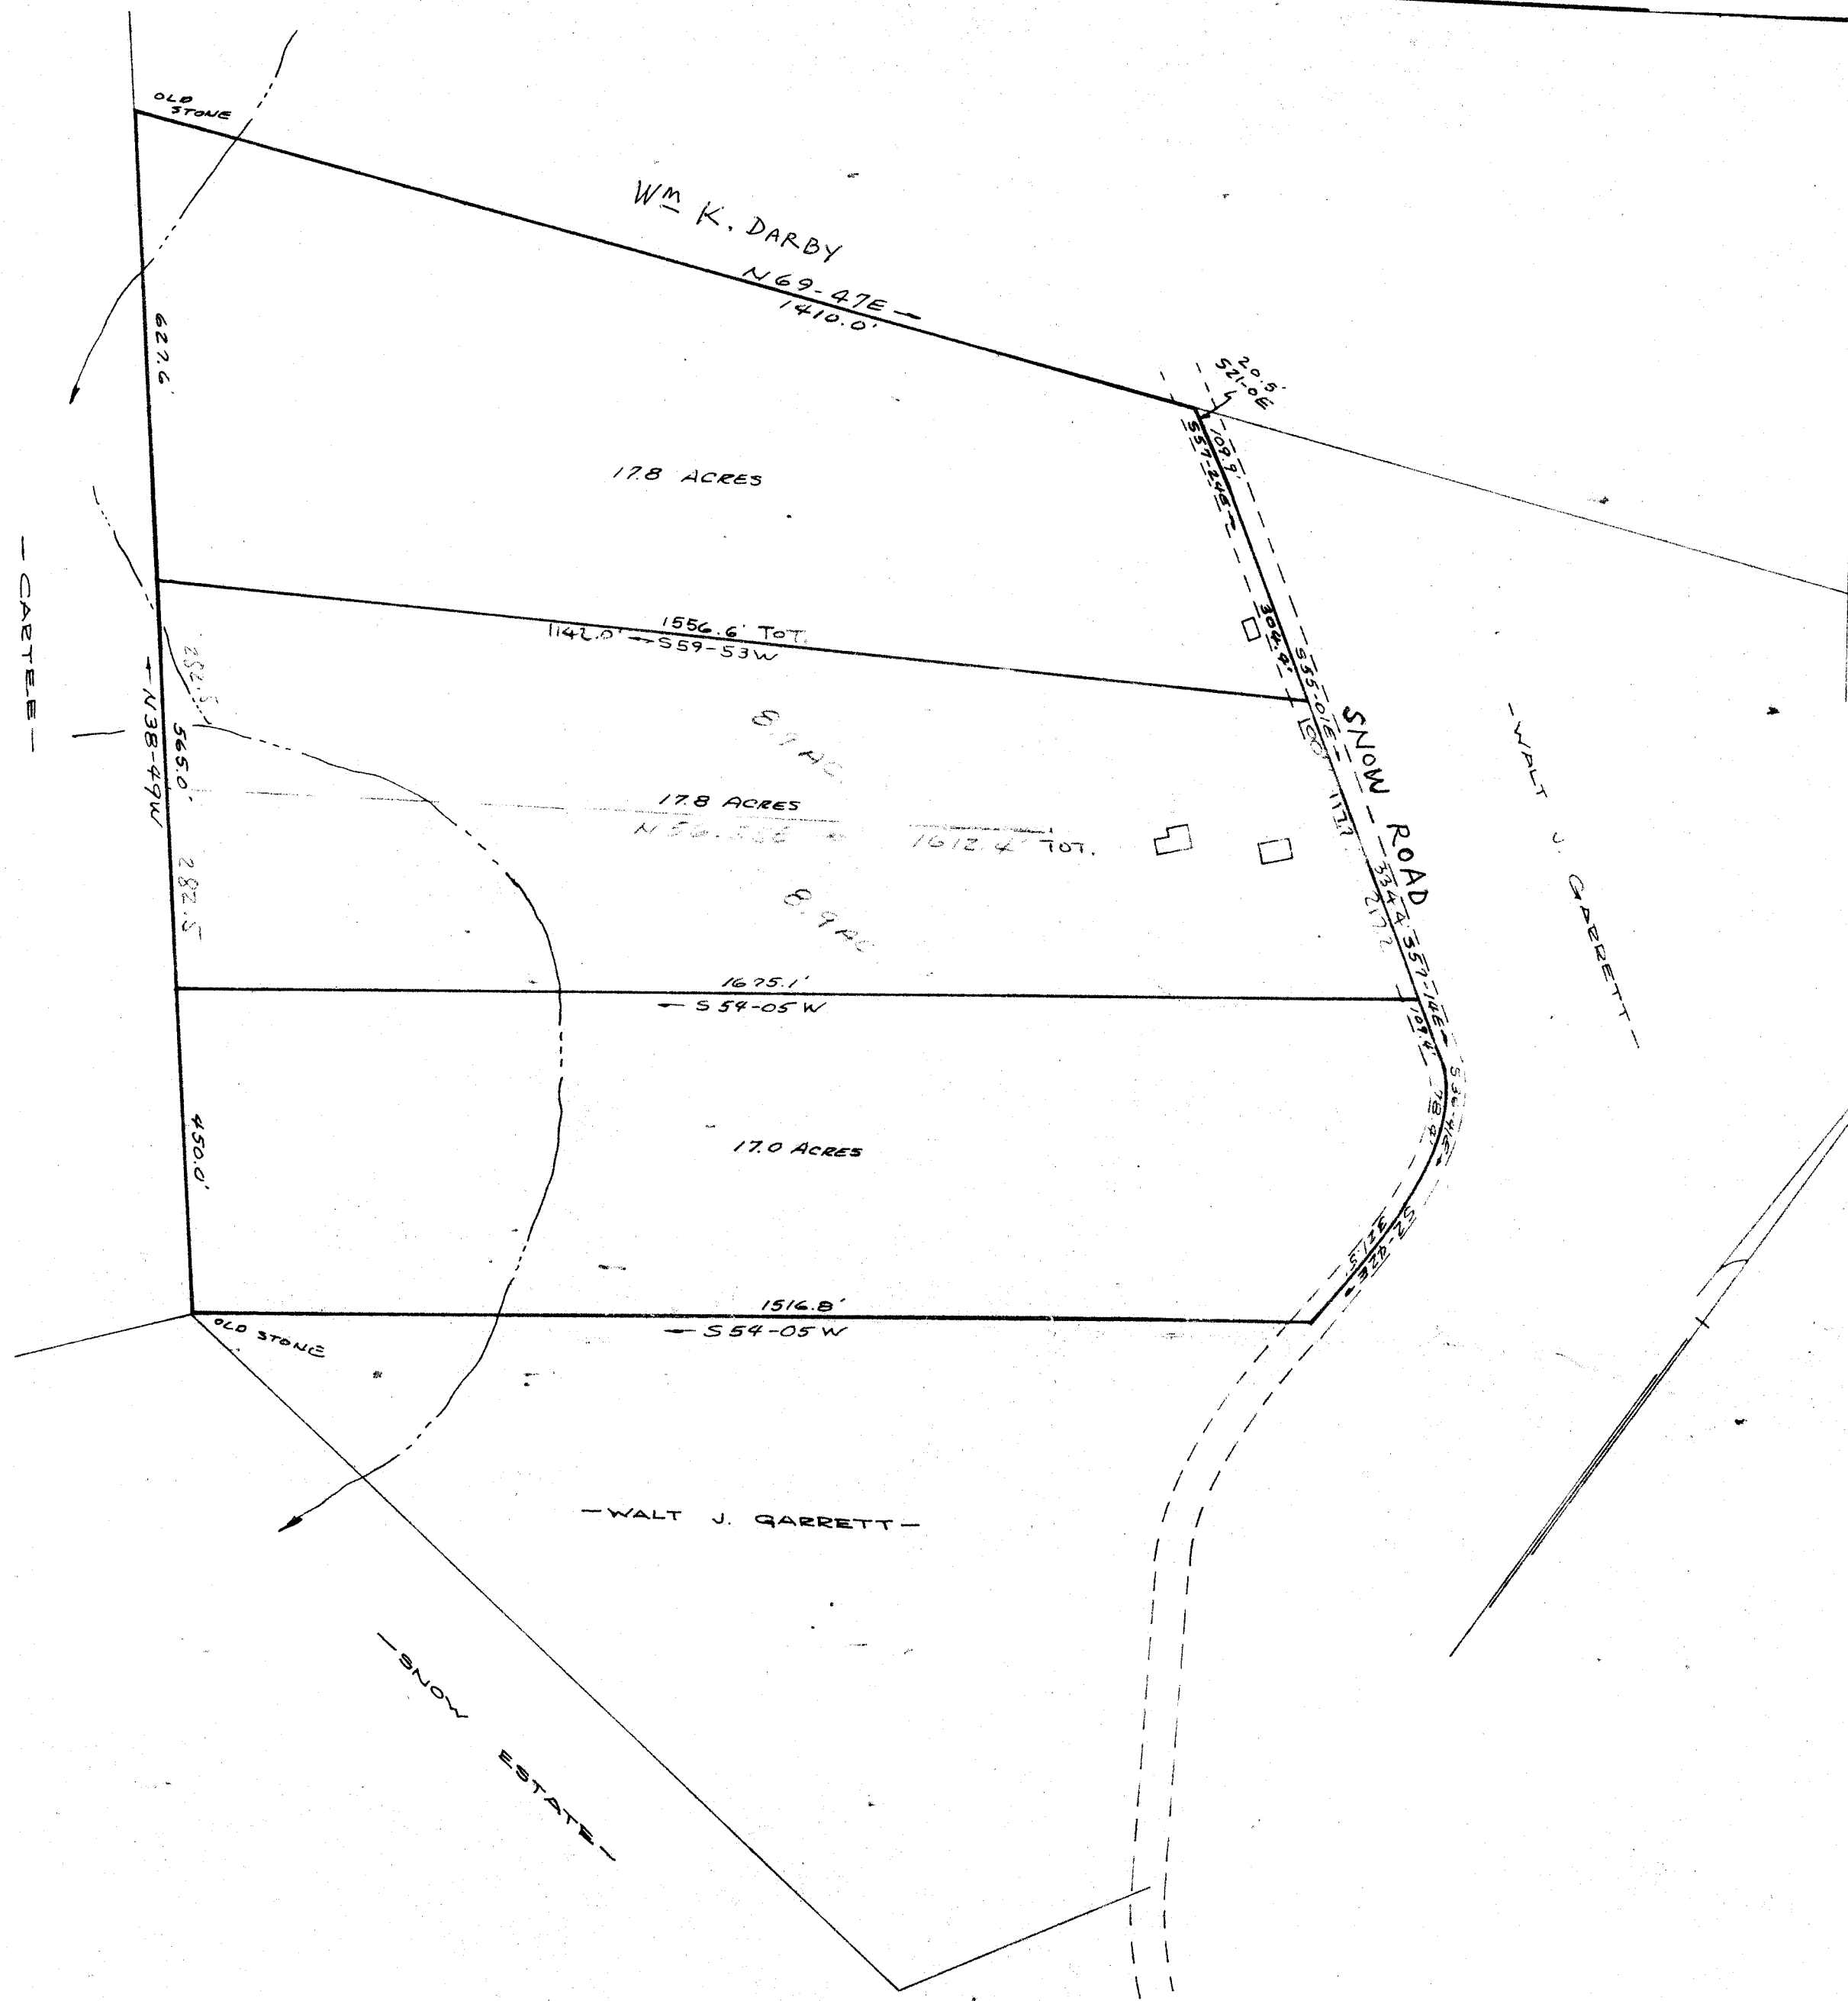

PROPERTY OF
JACK K. TAYLOR
GREENVILLE COUNTY, S.C.
SCALE 1"=200' 19 JUNE 1965
REVISED 11 FEB 1968

49-71
2.50
SEP 7 1971
7157

CAROLINA ENGINEERING & SURVEYING Co.
GREENVILLE, S.C.