


8318 Filed This 20 Sept. 1971
 and Recorded 42 21 3:52 P.
 Ollie Farnsworth
 Registrar

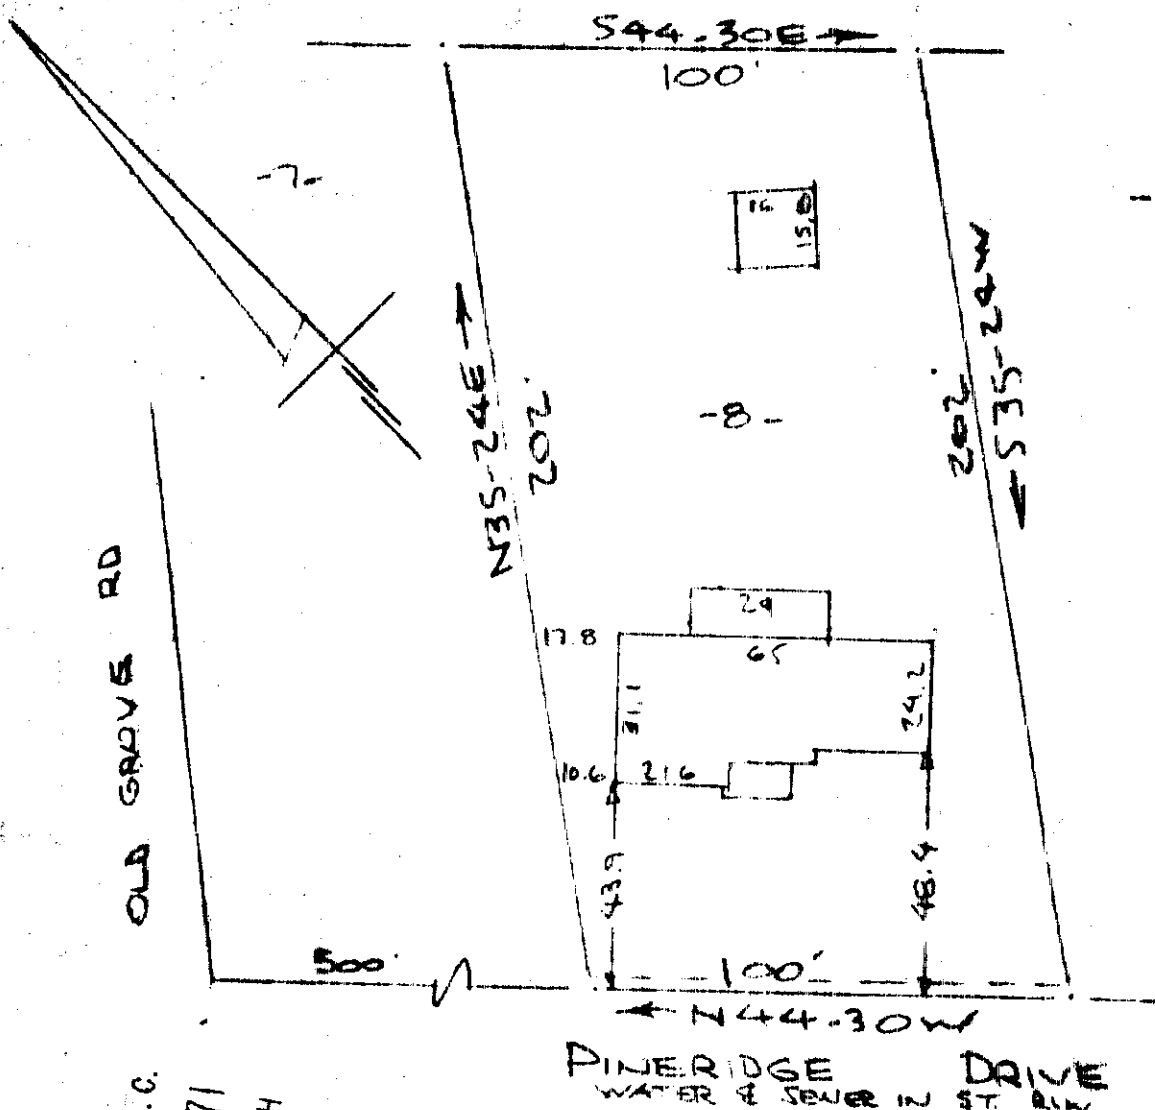

FILED
 GREENVILLE CO. S.C.
 SEP 20 9 52 PM '71
 OLLIE FARNSWORTH
 R.M.C.

PINERIDGE DRIVE
 WATER & SEWER IN ST. ROW

SEP 20 1971
 8318

PROPERTY OF
 M. FREEMAN & DOROTHY F. FREEMAN
 NEAR GREENVILLE, S.C.
 SCALE: 1" = 40'
 11 SEPT 1971

RECORDING FE
 PAID \$ 50

This is to certify that on the 11th day of September 1971, I surveyed the property shown on this plat, being known as lot 8 & portion of adjoining property on plat of JAMES M. FREEMAN & DOROTHY F. FREEMAN and recorded in the RMC Office Greenville County, S.C., in Plat Book 4-L at Page 21; and that the property lines, walls and buildings are as shown hereon, and that the walls and buildings located on said lot do not encroach or project on adjacent street or property, and that no adjacent walls or buildings encroach or project on said premises, and no power lines cross this property except as shown hereon.

R. B. Bruce
 R. B. Bruce, RLS #1952

CAROLINA SURVEYING COMPANY