8755 23 Sept. 1971

And Recorded 4 L 31 4:27 P.M.

Ollie Farnsworth

Register Mesne Conveyances Greenville County, S. C.

RECORDING FEE PAID $ 50¢

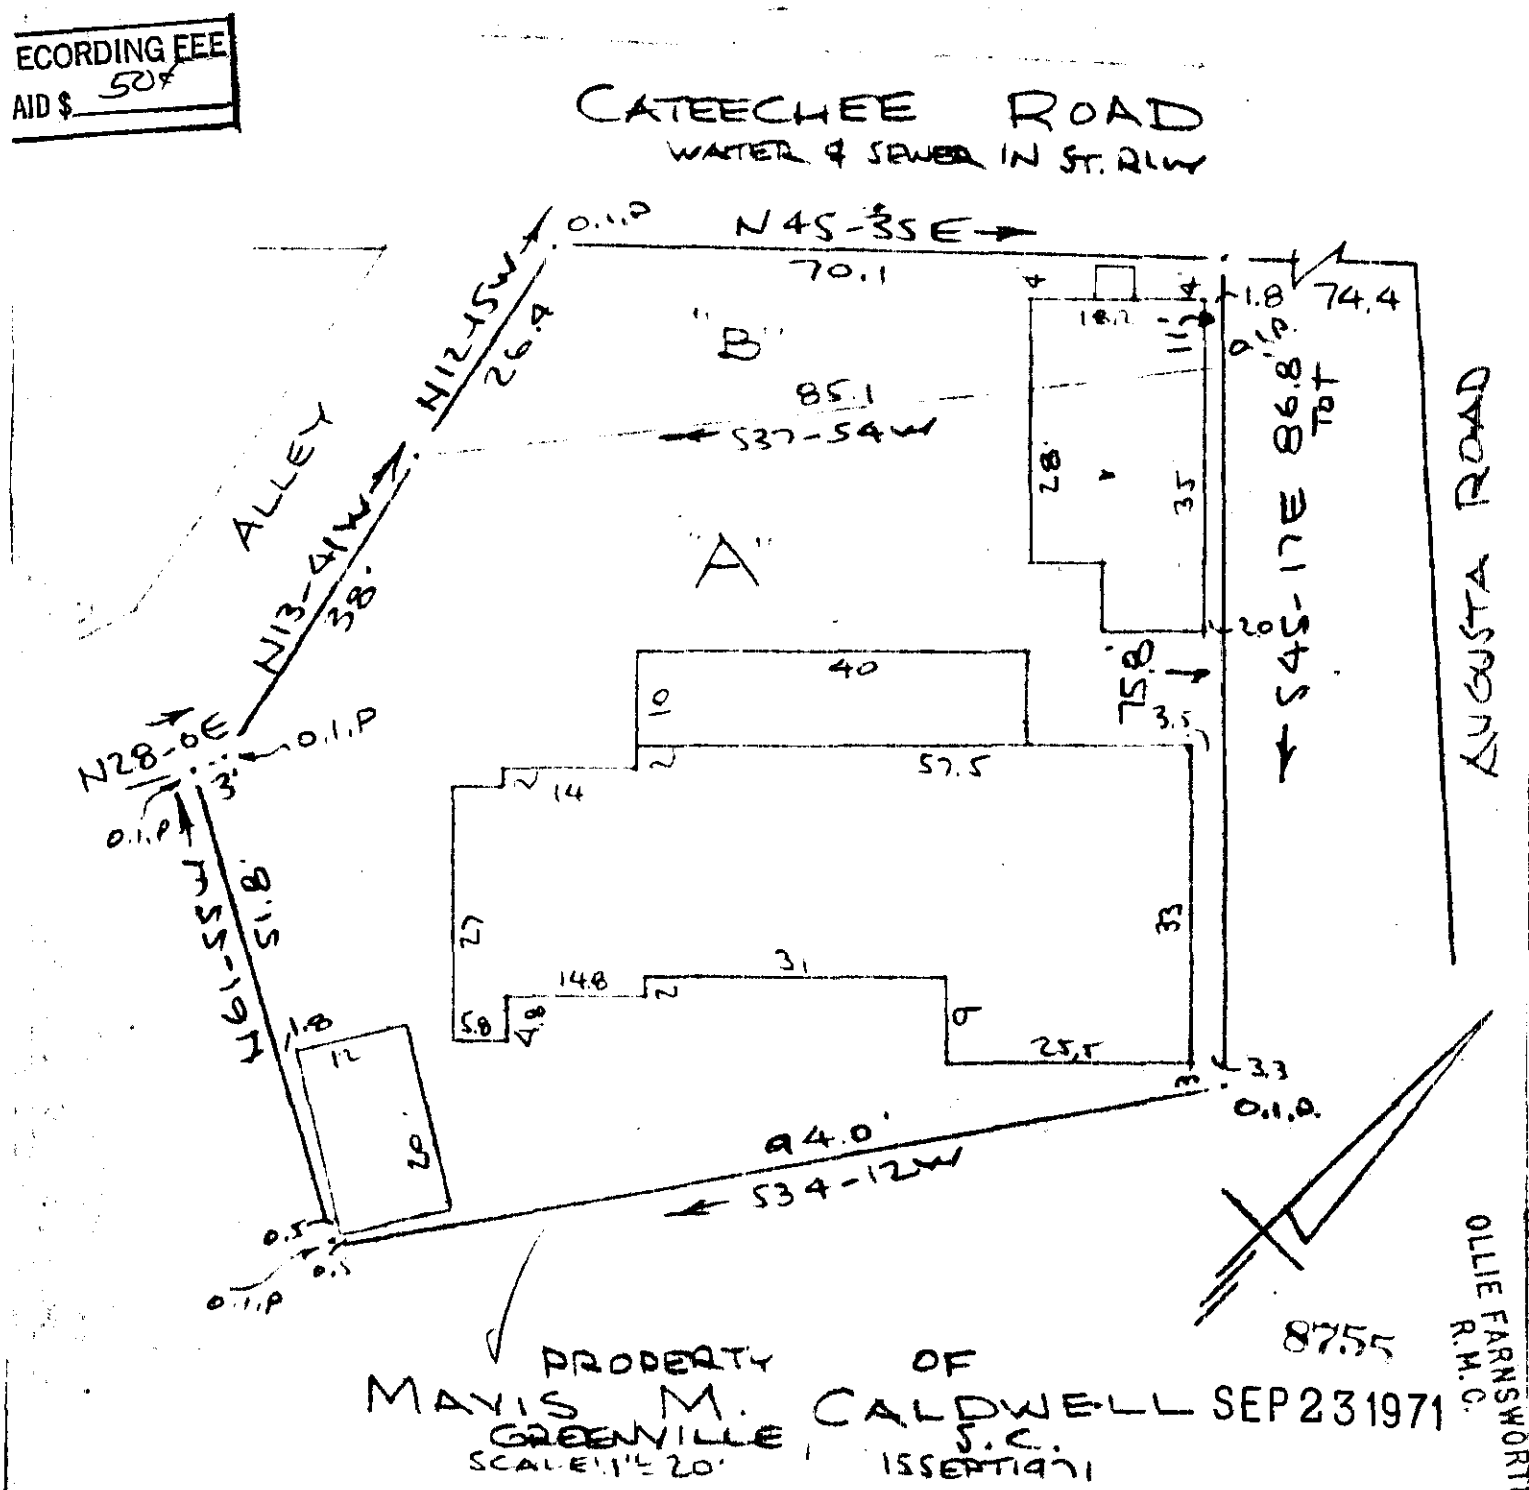

SEP 23 1971

This is to certify that on 15th day of September 1971, I surveyed the property shown on this property, being known as PROPERTY OF MAVIS M. CALDWELL and recorded in the RMC Office Greenville County, S.C., in Plat Book at Page ; and that the property lines, walls and buildings are as shown hereon, and that the walls and buildings located on said lot do not encroach or project on adjacent street or property, and that no adjacent walls or buildings encroach or project on said premises, and no power lines cross this property except as shown hereon.

4 L - 31

R. B. Bruce, RLS #1952

CAROLINA SURVEYING COMPANY

Greenville, S. C.

103/20