


7560 Filed This 10 day of Sept 1971
 And Recorded in Vol. 44 p. 67 of 1876 R.
Ollie Farnsworth
 Registrar Marine Conveyance Greenville County, S. C.

RECORDING FEE
 PAID \$ - 50¢

WESTFIELD AVENUE
 (MAUD ST)
 WATER & SEWER IN ST. ROW

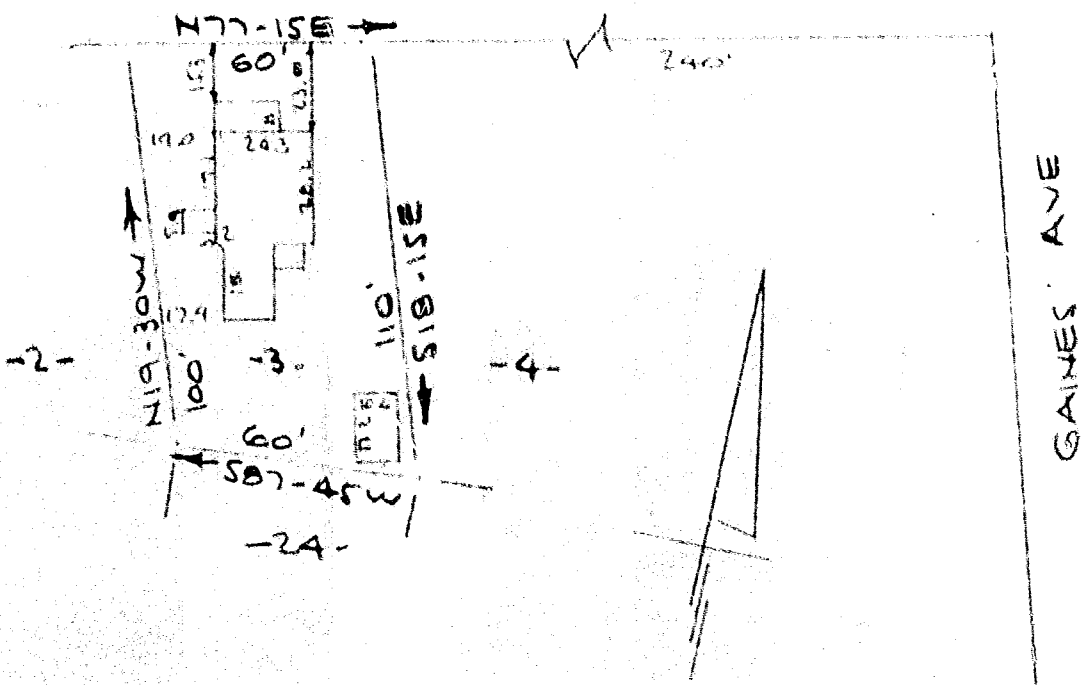

PROPERTY OF
HAYWARD L. NELSON
 GREER, S.C. - GREENVILLE CO
 SCALE: 1" = 40' (AUG 71)

This is to certify that on the 6th day of August 1971, I surveyed the property shown on this plat, being known as lot 3 on plat of M. T. GAINES PROPERTY and recorded in the RMC Office Greenville County, S.C., in Plat Book "D" at Page 260; and that the property lines, walls and buildings are as shown hereon, and that the walls and buildings located on said lot do not encroach or project on adjacent street or property, and that no adjacent walls or buildings encroach or project on said premises, and no power lines cross this property except as shown hereon.

SEP 10 1971
 7560

R. B. Bruce
 R. B. Bruce, RLS #1952

4L-67

CAROLINA SURVEYING COMPANY
 Greenville, S. C.

FILED
 GREENVILLE CO. S.C.
 SEP 10 10 46 AM '71
 OLLIE FARNSWORTH
 R.M.C.