

9296 FILED 29 Sept. 1971
 And Recorded in Vol. 42 Page 73 at 3:55 P.M.
 Ollie Farnsworth
 Registrar of Deeds - Greenville County, S. C.


GREENVILLE CO. S. C.

SEP 29 3 55 PM '71

OLLIE FARNSWORTH
 R.M.C.

LAKECREST
 DRIVE

LOTUS COURT

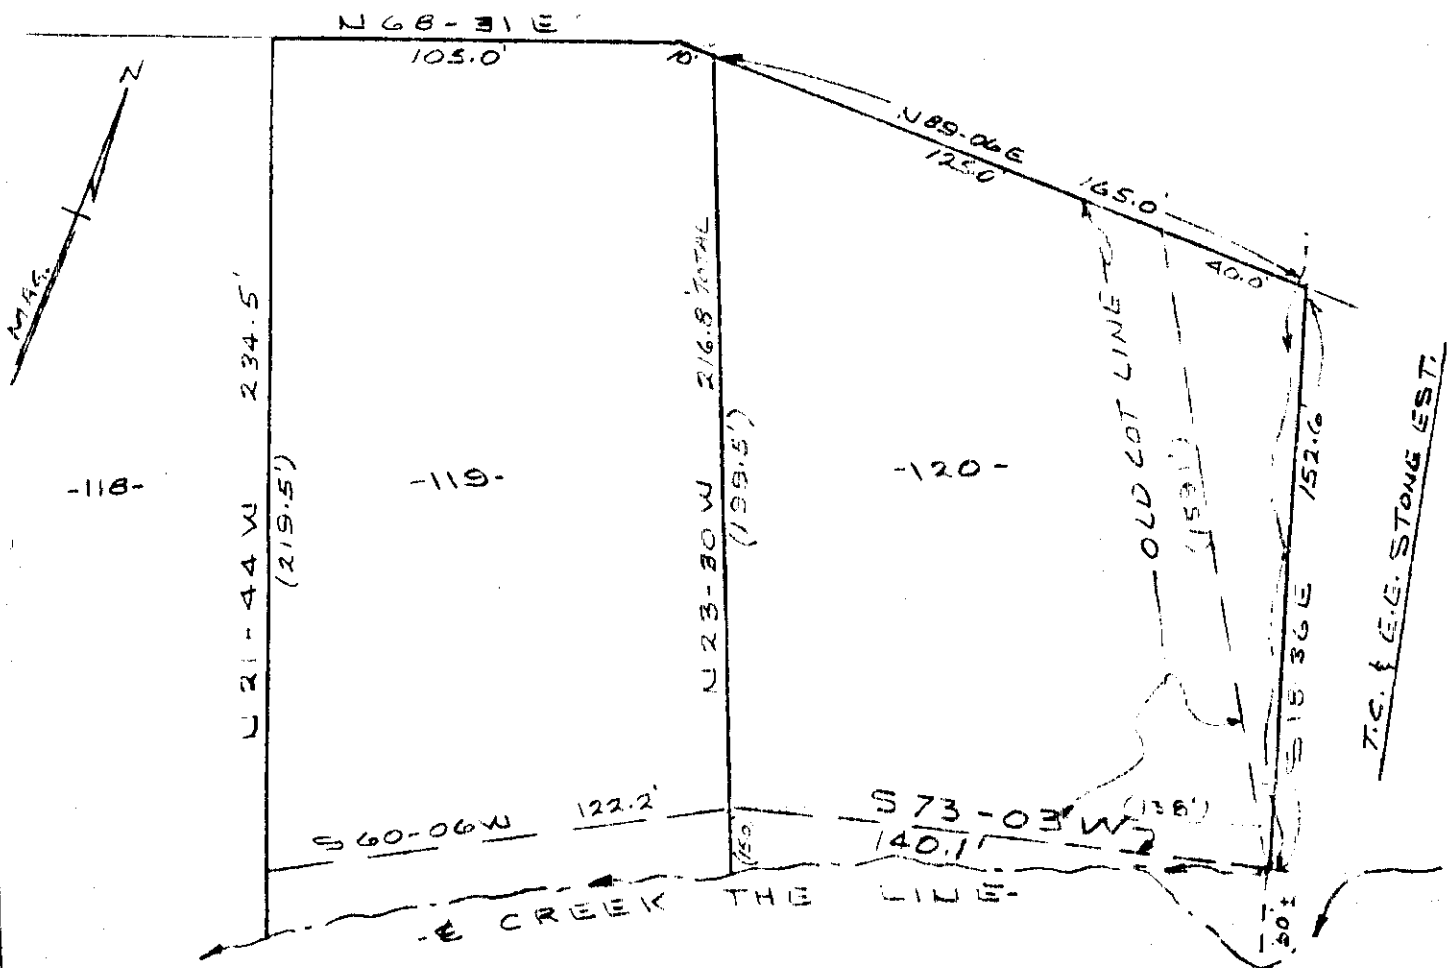

REVISION LOTS NO. 120
 STONE LAKE HEIGHTS SECT. NO. 1
 GREENVILLE, SOUTH CAROLINA
 SCALE 1" = 50' AUG. 18, 1971

SEP 29 1971

RECORDING FEE
 PAID \$ 50⁰⁰

9296

4L-73

PIEDMONT ENGINEERS AND ARCHITECTS
 GREENVILLE, S. C.

87