
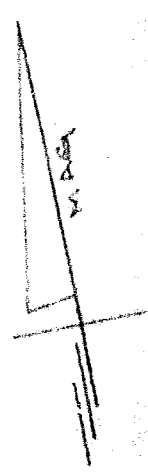


11103 Filed The 18 day of Oct. 1971
 And Received 46 97 11:23 AM.
 Ollie Farnsworth
 Registrar

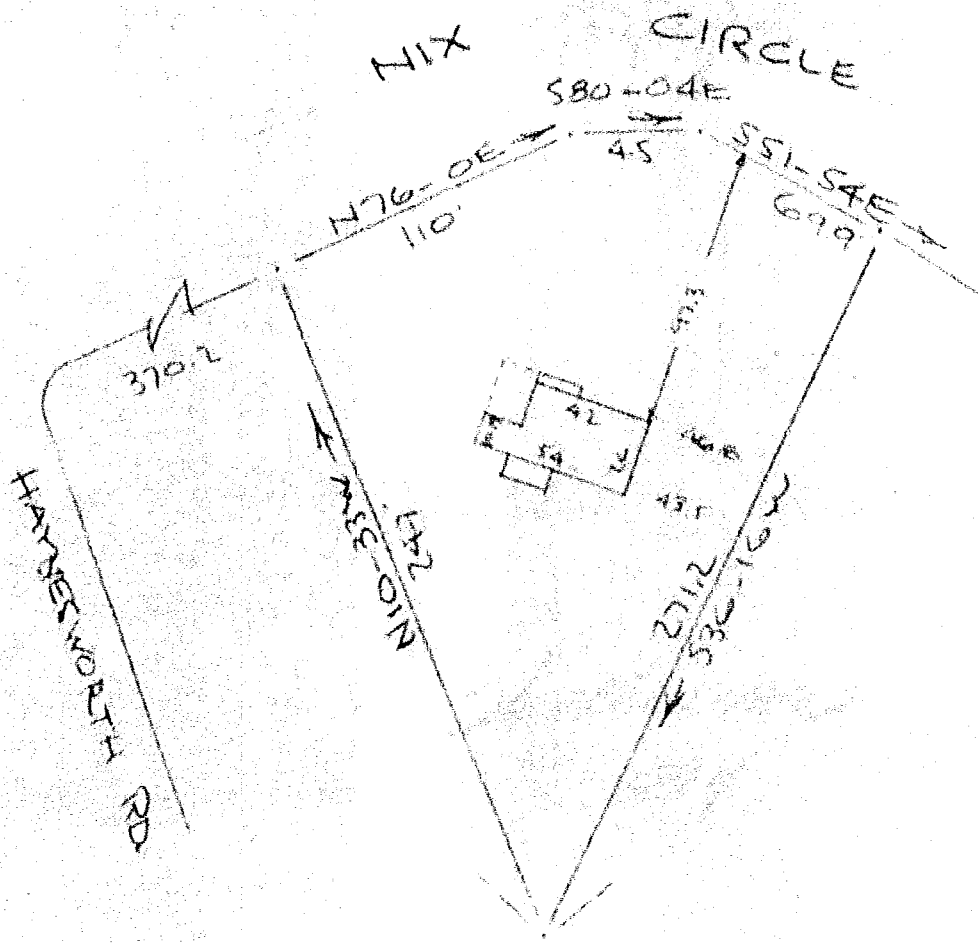

FILED
 GREENVILLE CO. S.C.
 OCT 18 11 23 AM '71
 OLLIE FARNSWORTH
 R.M.C.

SURVEY FOR WILLIAMS
 FRANK
 NEAR GREENVILLE, S.C.
 SCALE: 1"=60'
 24 SEPT 1971

OCT 18 1971
 11103

4L-97

CAROLINA SURVEYING CO
 GREENVILLE, S.C.

504

