


#15043 Filed This 29th day of Nov 1971
 And Recorded in Vol 4L 179, 311
Ollie Farmworth

38 506

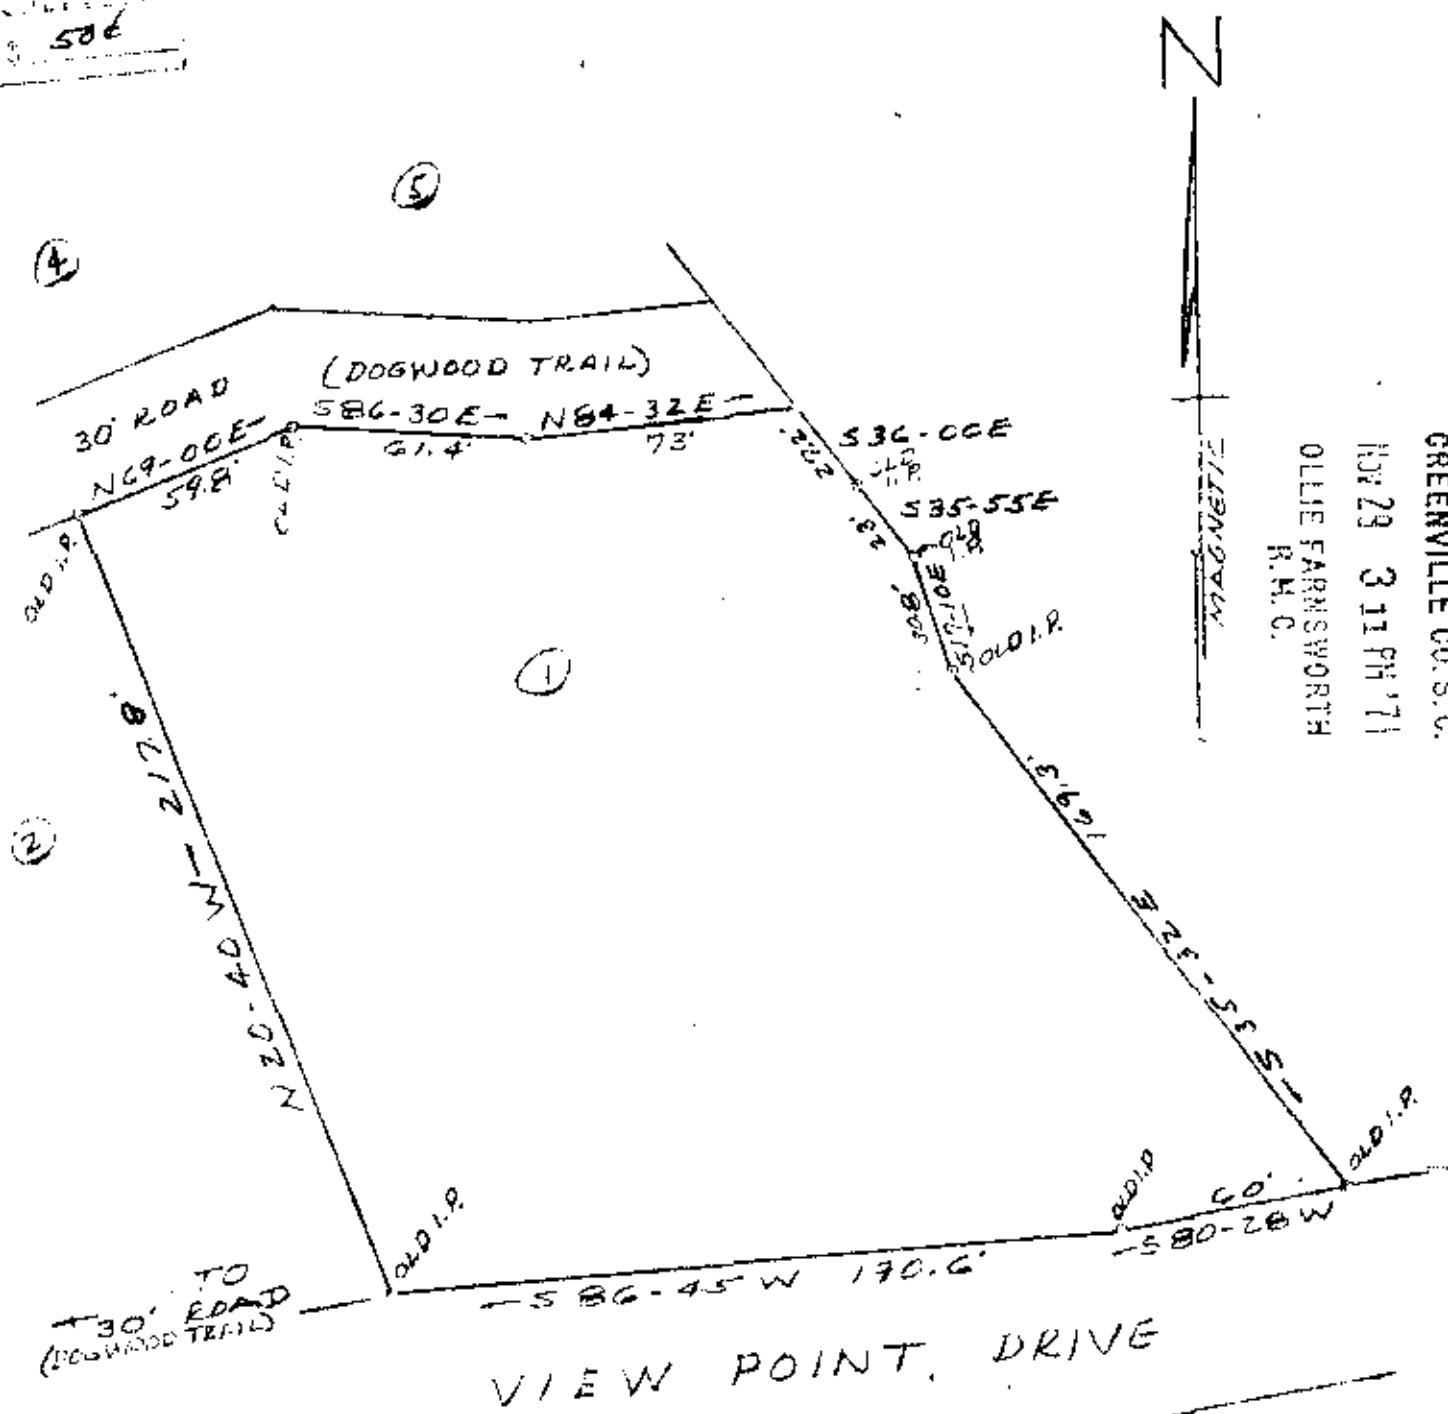

FILED
 GREENVILLE CO. S. C.
 NOV 29 3 11 PM '71
 OLLIE FARMWORTH
 R.M.C.

PROPERTY OF
 RONALD LEROY KING and MARJORIE J. KING
 NEAR GREENVILLE, S.C.
 NOV. 26, 1971 SCALE: 1"=50'

4L-179

SURVEY BY: CAMPBELL & CLARKSON
 SURVEYERS, INC.
 Rt. 3, Clarksville,
 S.C. Route 5, NR 2589

15043
 NOV 29 1971

REFERENCE
 PLAT OF PROPERTY OF
 JULIA BELLE SINGLETON
 RECORDED IN PLAT BOOK 48 PAGE 65

179