


16878 12-20-71 Dec. 71  
 HM 19 10:01 A  
 Ollie Farnsworth  
 Farnsworth, Ollie Farnsworth, Greenville, S.C.

12-20-71  
 EX 10.  
 John D. + Etta J. Foyette.  
 Resurveyed

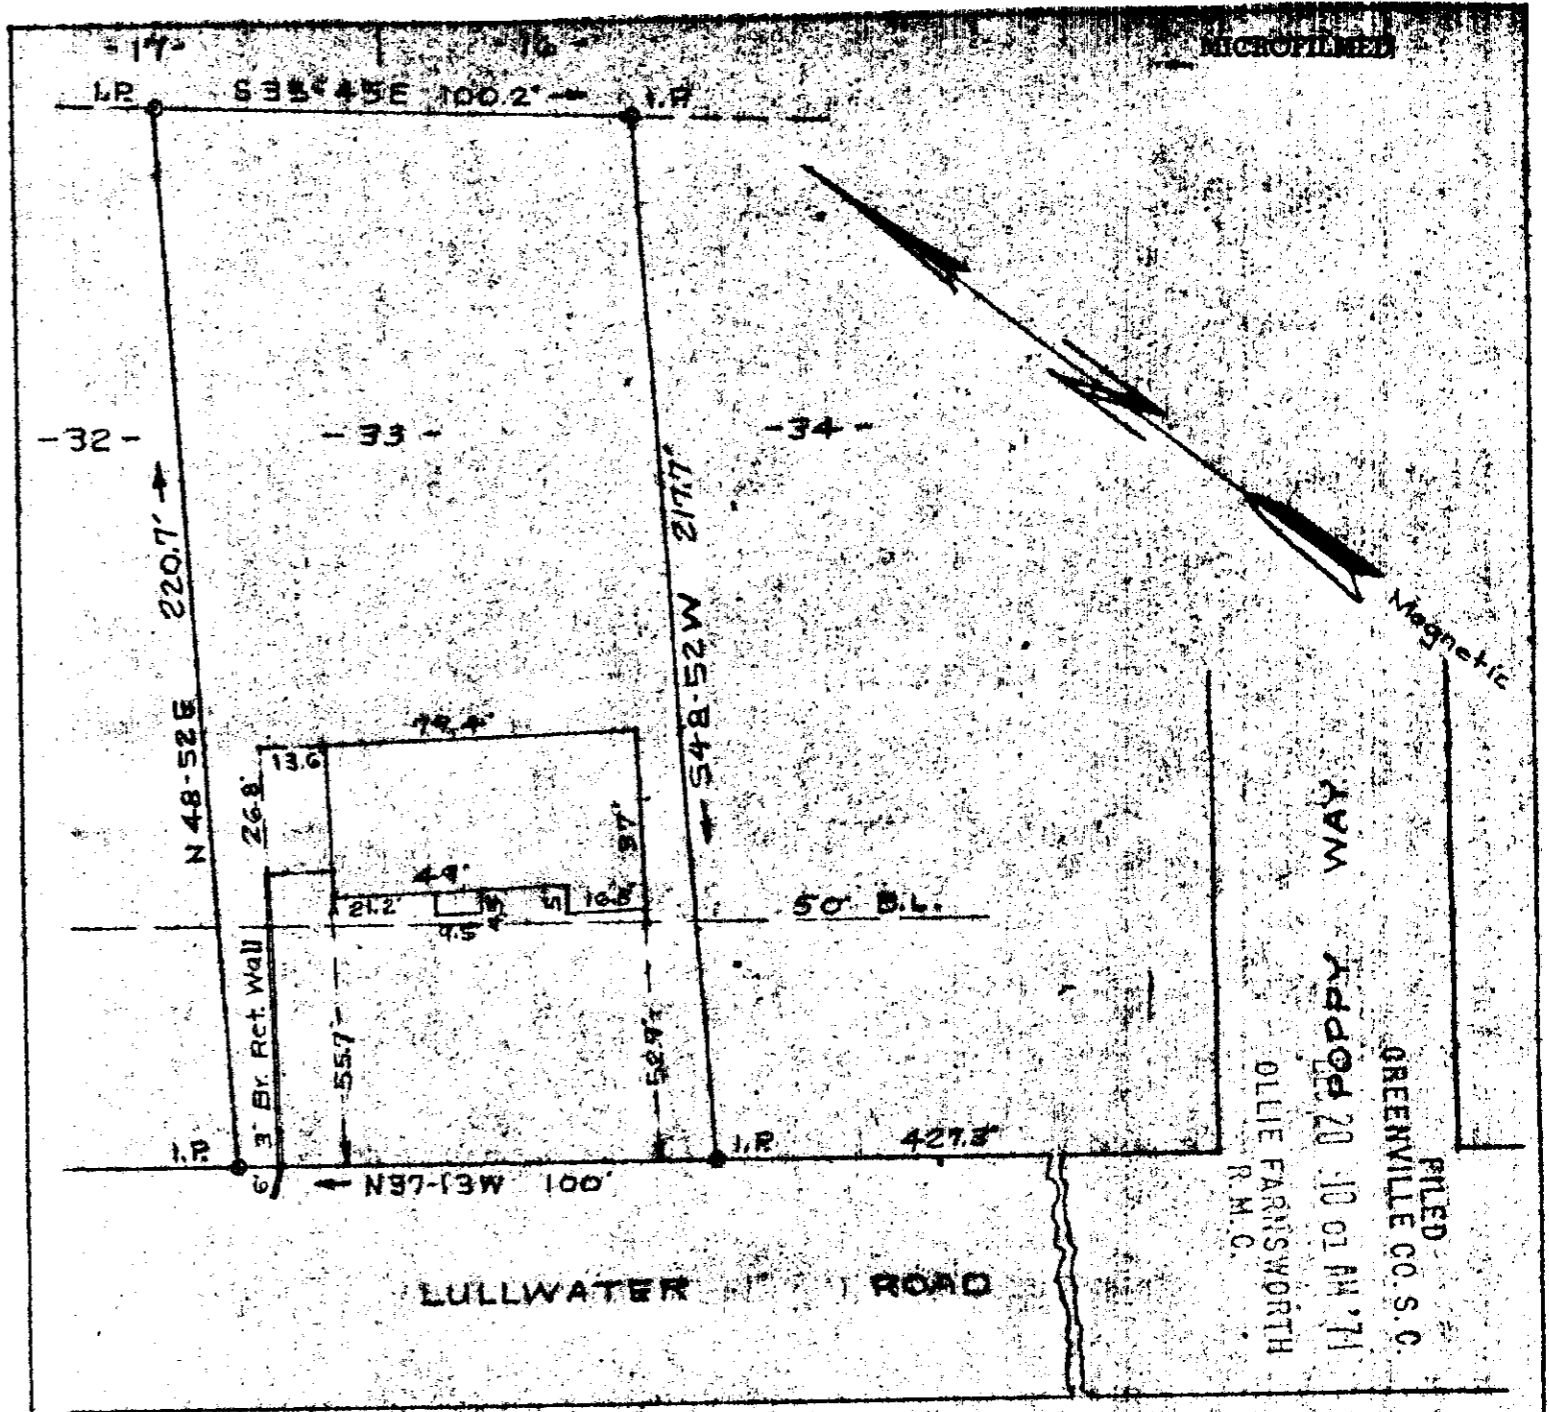

PROPERTY OF  
 DONALD PARSON JR.  
 GREENVILLE CO. S. C.

Scale 1"=40' Dec. 17, 1971

This is to certify that on the 17th day of May of December, 1971, I surveyed the property shown on this plat being known as Lot 33 on plat of MOUNTSIDE GARDENS recorded in plat book 8 at page 17 in the R.M.C. Office of Greenville Co., S. C. and that the property lines, walls and buildings are as shown hereon, and that the buildings located on said lot do not encroach or project onto adjacent streets or property and that no adjacent buildings or walls encroach or project onto said premises, and that no utility lines cross this property.

16878 ✓  
 HM-19  
 T. H. Walker Jr.  
 T.H. Walker Jr., R.L.S. # 3182  
 300 Maple Drive  
 Mauldin, S. C. 29662

RECORDING FEE  
 PAID \$ 506