


18714 Filed This 10 day of Jan 1972
And Recorded in Vol. 4M Page 59 5:03 P.

Ollie Farnsworth
Register Mesne Conveyance Greenville County, S. C.

MICROFILMED

HUDSON ROAD

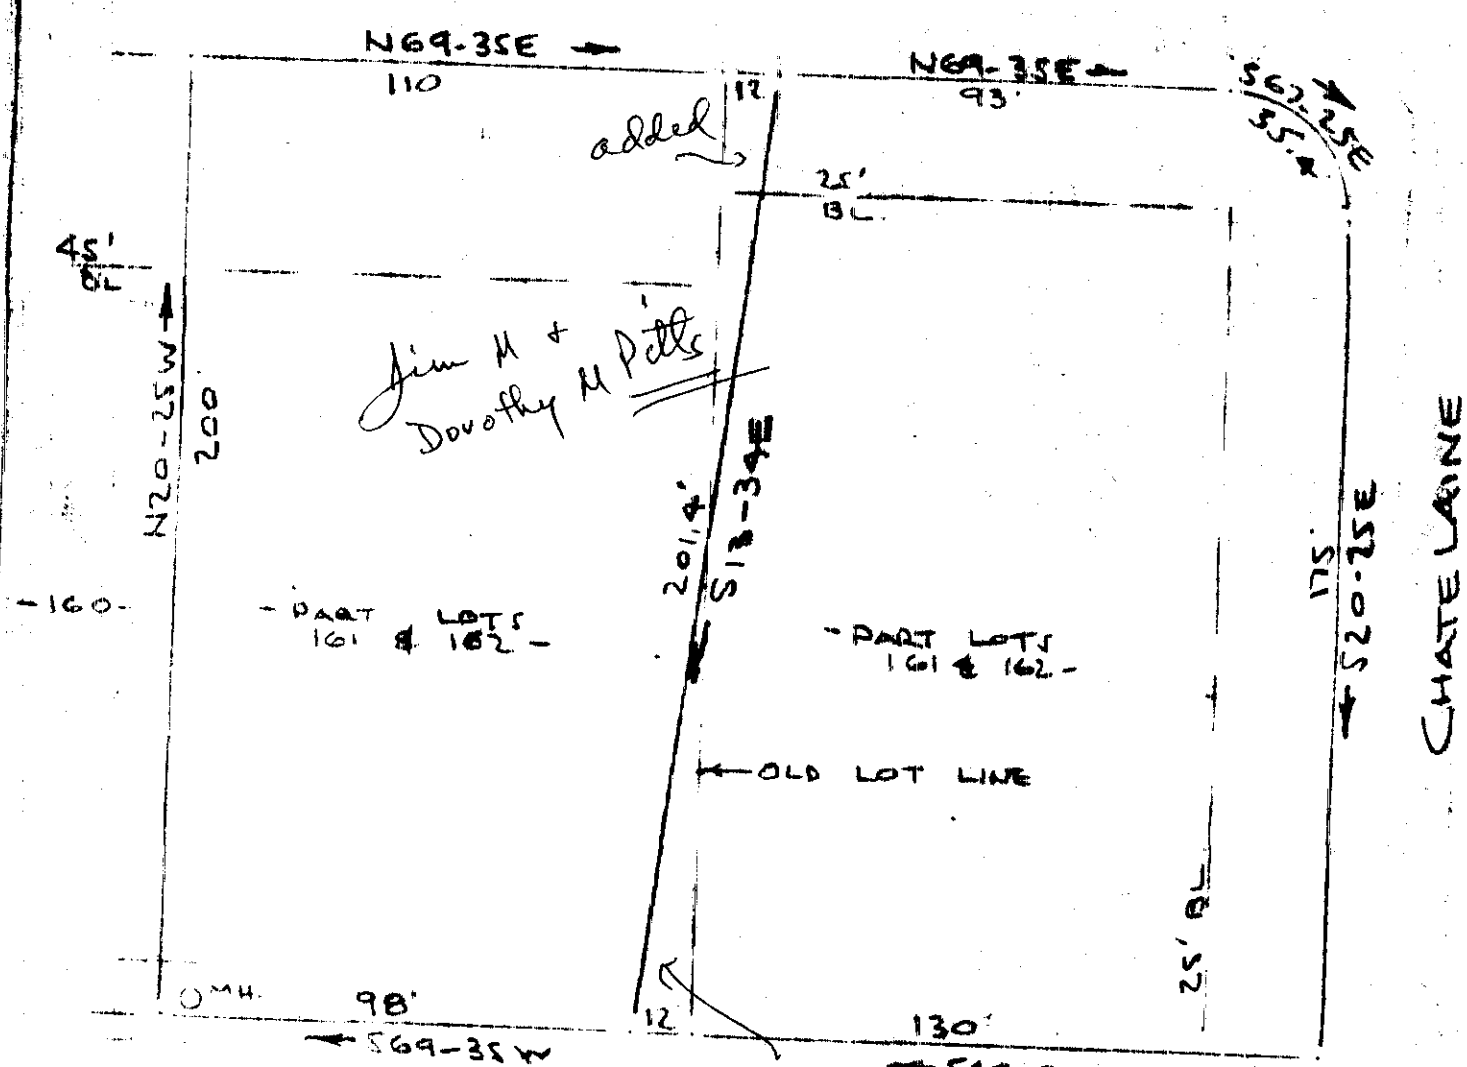

FILED
GREENVILLE CO. S. C.
JAN 10 5 03 PM '72
OLLIE FARNSWORTH
R.H.C.

REVISION OF LOTS 161 & 162
MERRIFIELD PARK
NEAR GREENVILLE, S. C.
SCALE: 1" = 40'
2 NOV 1971

JAN 10 1972
18714
4M-59

CAROLINA SURVEYING CO
GREENVILLE, S. C.

RECORDING FEE
PAID \$ 504