


19465 18 Jan 1972  
And 4M page 65 of 1972 P.

Ollie Farnsworth

MICROFILMED

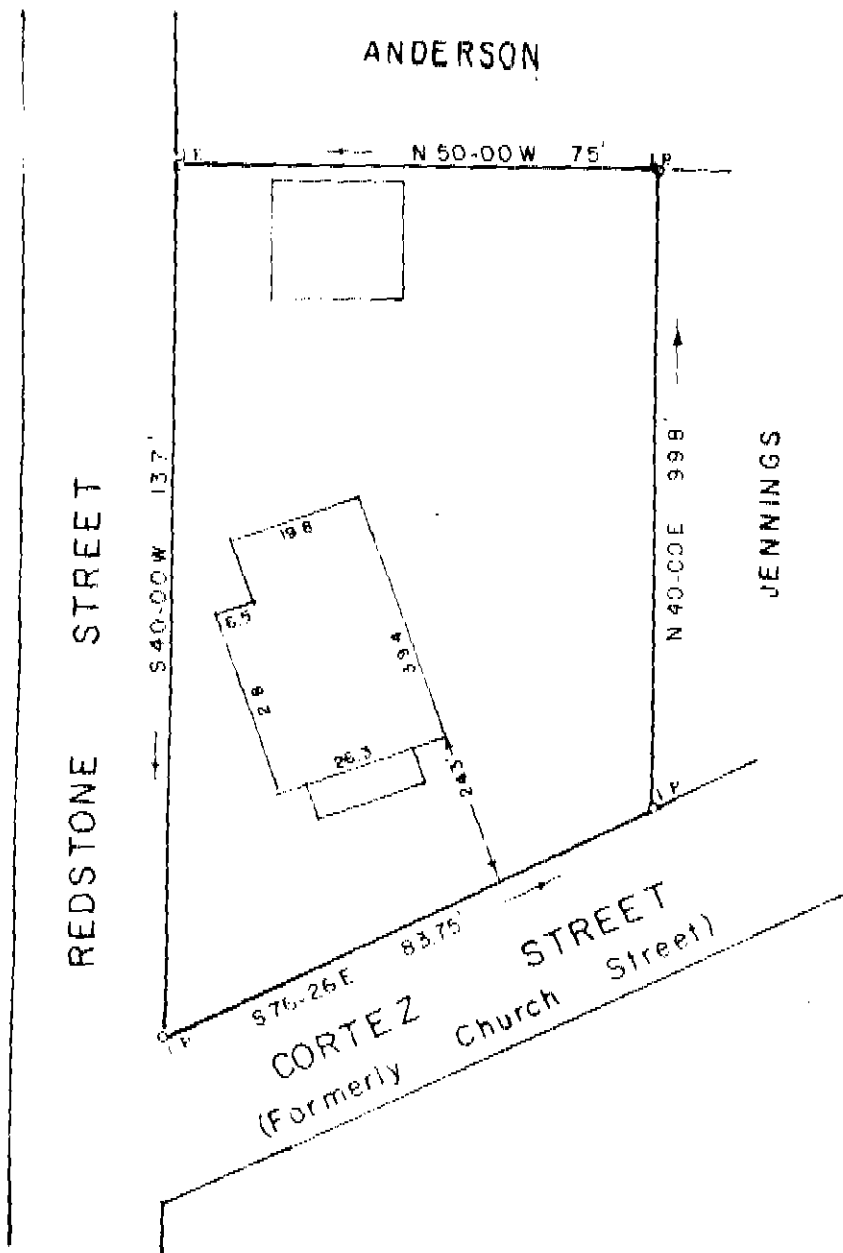

PROPERTY OF  
 RANDALL HOWARD BALLEW  
 GREENVILLE CO, S. C.

Scale 1" = 30' Jan, 1972

This is to certify that on the 18th day of January, 1972, We surveyed the property shown on this plat; being shown on plat of Randall Howard Ballew, Recorded in Plat Book 4M, page 65 Office of S. N. C. Greenville Co., S. C.; and that the property lines, walls and buildings are as shown hereon; that the buildings located on said plat do not encroach or project on adjacent streets or property; and that no adjacent buildings or walls encroach or project on said premises.

FILED  
 GREENVILLE CO. S. C.  
 JAN 18 2 22 PM '72  
 OLLIE FARNSWORTH  
 R.M.C.

19465

JAN 18 1972

*R. W. Dalton*  
 Dalton & Neves Co., Engineers

4M-65

PAID \$ 50<sup>+</sup>