


21730

4M


Feb 11 2:48 P.

MICROFILMED

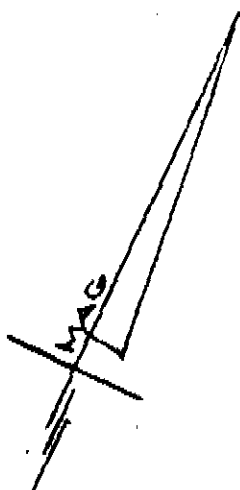

508

CAREN DR.  
WATER IN ST. ROW

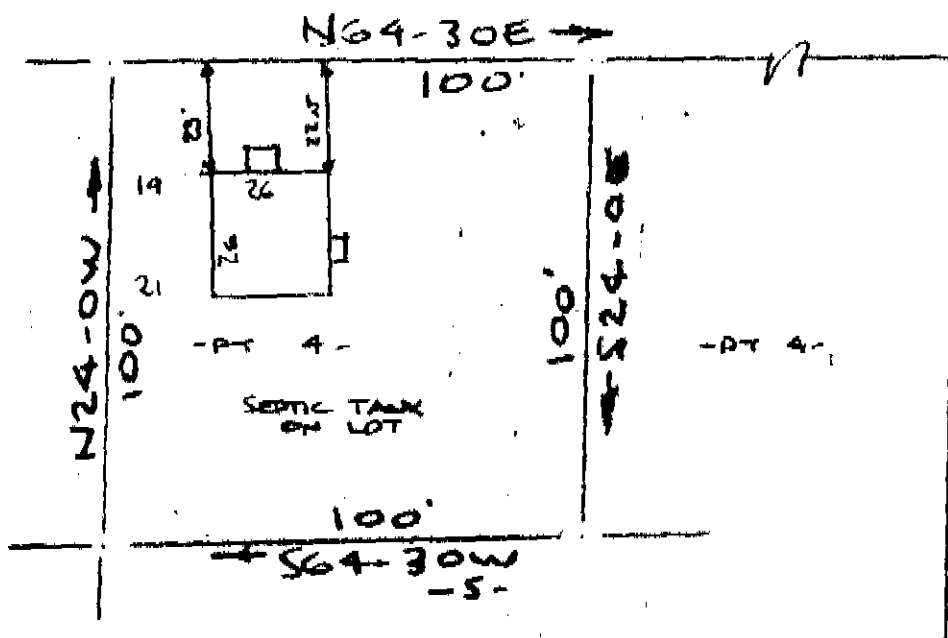

BRADLEY ST.

FILED  
GREENVILLE CO. S.C.  
FEB 11 2 48 PM '72  
OLLIE FARNSWORTH  
R.M.C.

PROPERTY OF  
**JOHN DAVID KEITH**  
NEAR GREENVILLE, S. C.  
SCALE: 1" = 40' 9 FEB 1972

This is to certify that on the 9th day of February 1972, I surveyed the property shown on this plat, being known as part of lot 4 on plat of FALLIS ANNEX and recorded in the RMC Office Greenville County, S.C., in Plat Book "C" at Page 101 and also being known as PROPERTY OF JOHN DAVID KEITH and recorded in the RMC Office Greenville County, S.C., in Plat Book 4M at Page 113; and that the property lines, walls and buildings are as shown hereon, and that the walls and buildings located on said lot do not encroach or project on adjacent street or property, and that no adjacent walls or buildings encroach or project on said premises, and no power lines cross this property except as shown hereon.

*R. E. Bruce*  
R. E. Bruce, RLS #1952

FEB 11 1972

21730

4M-113

CAROLINA SURVEYING COMPANY  
112 Manly Street  
Greenville, S. C.