


222 HENRIETTA
HORIZONTAL PROPERTY REGIME
GREENVILLE, SOUTH CAROLINA

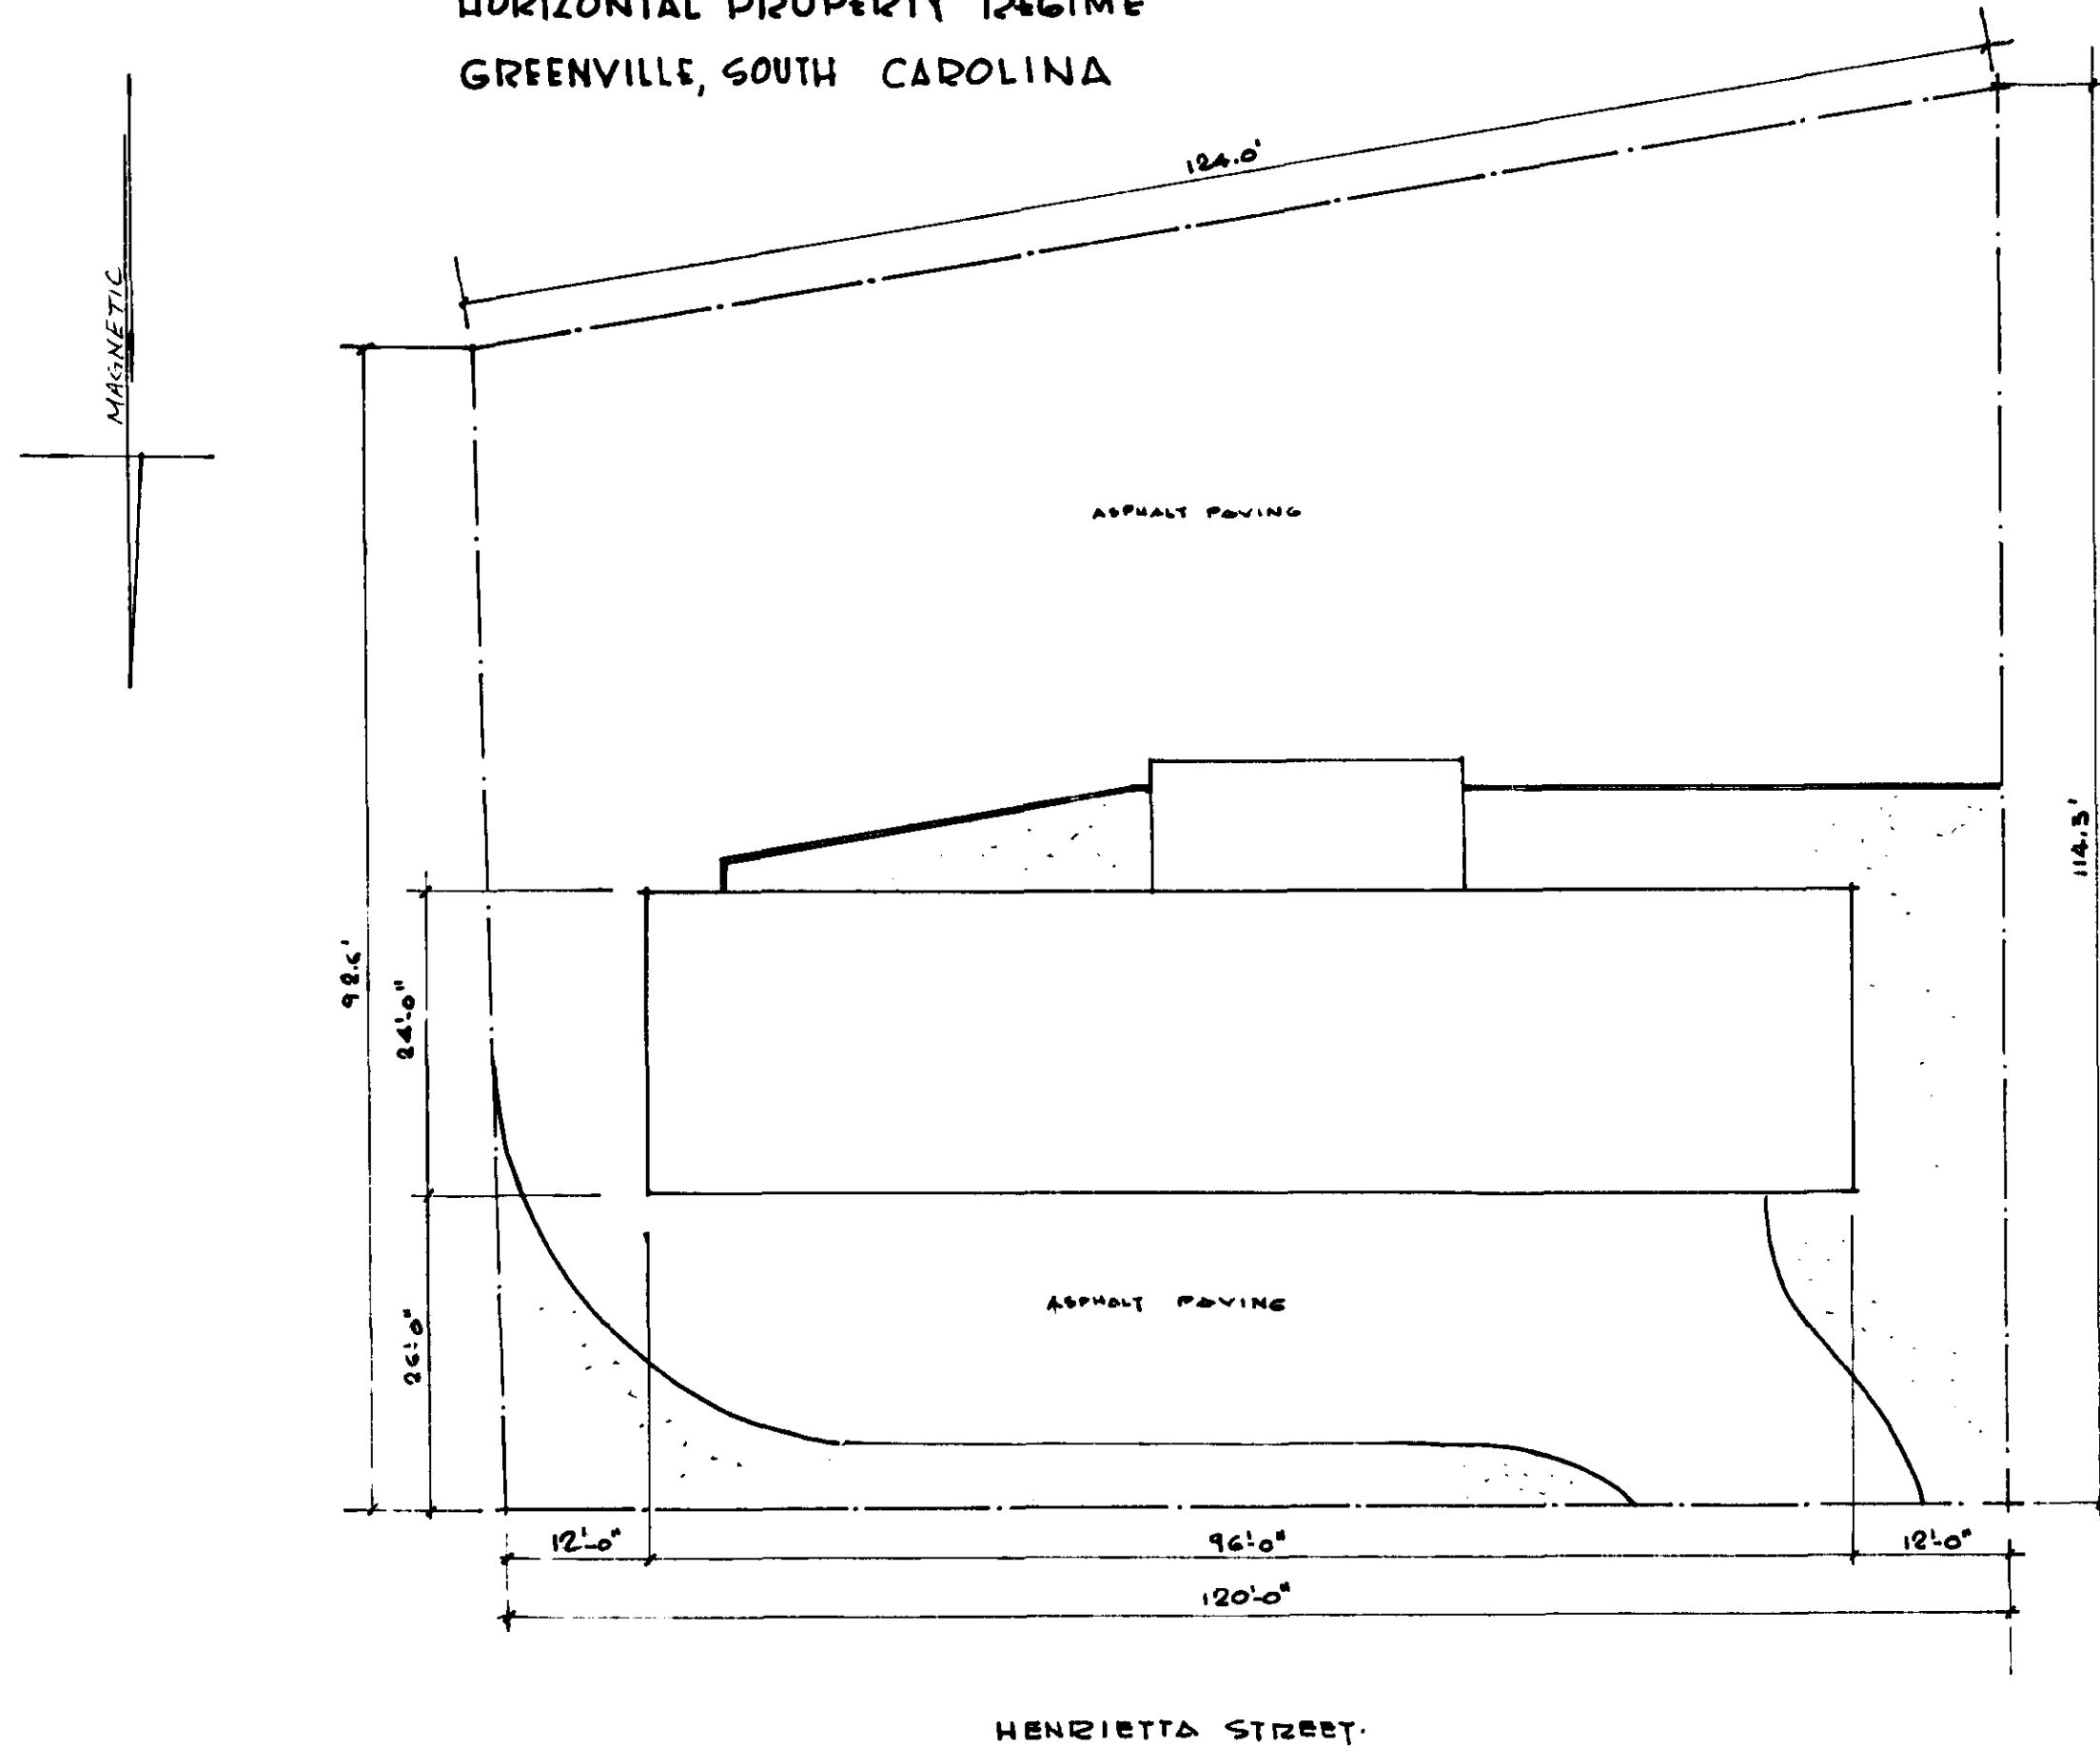


PLOT PLAN
EXHIBIT "A"
SHEET #1 of 4

HENRIETTA STREET

ARCHITECT CERTIFICATE

I, GUSTAVO MORENO, HEREBY CERTIFY THAT THIS PLOT PLAN SHOWS THE LOCATION OF THE BUILDING AND IS TRUE AND IS CORRECT TO THE BEST OF MY KNOWLEDGE.

DATED THIS FOURTEENTH DAY OF DECEMBER OF THE YEAR NINETEEN HUNDRED AND SEVENTY TWO


 GUSTAVO MORENO, REG. ARCHITECT #7194
 GREENVILLE, SOUTH CAROLINA.

FILED
 GREENVILLE CO. S.C.
 FEB 15 4 19 PM '73
 DONNIE S. TANKERSLEY
 R.M.C.

FEB 15 1973

45-87 ✓

\$ 3.00

23186

RECORDING FEE
 PAID \$ 3.00