



PLAN	DATE	BY
REVISED	11-30-25	J.A.L.
PLATED		
NOTE BOOK		
NO. 411		

PROFILE	DATE	BY
REVISED		J.A.L.
PLATED		
NOTE BOOK		
NO. 411		

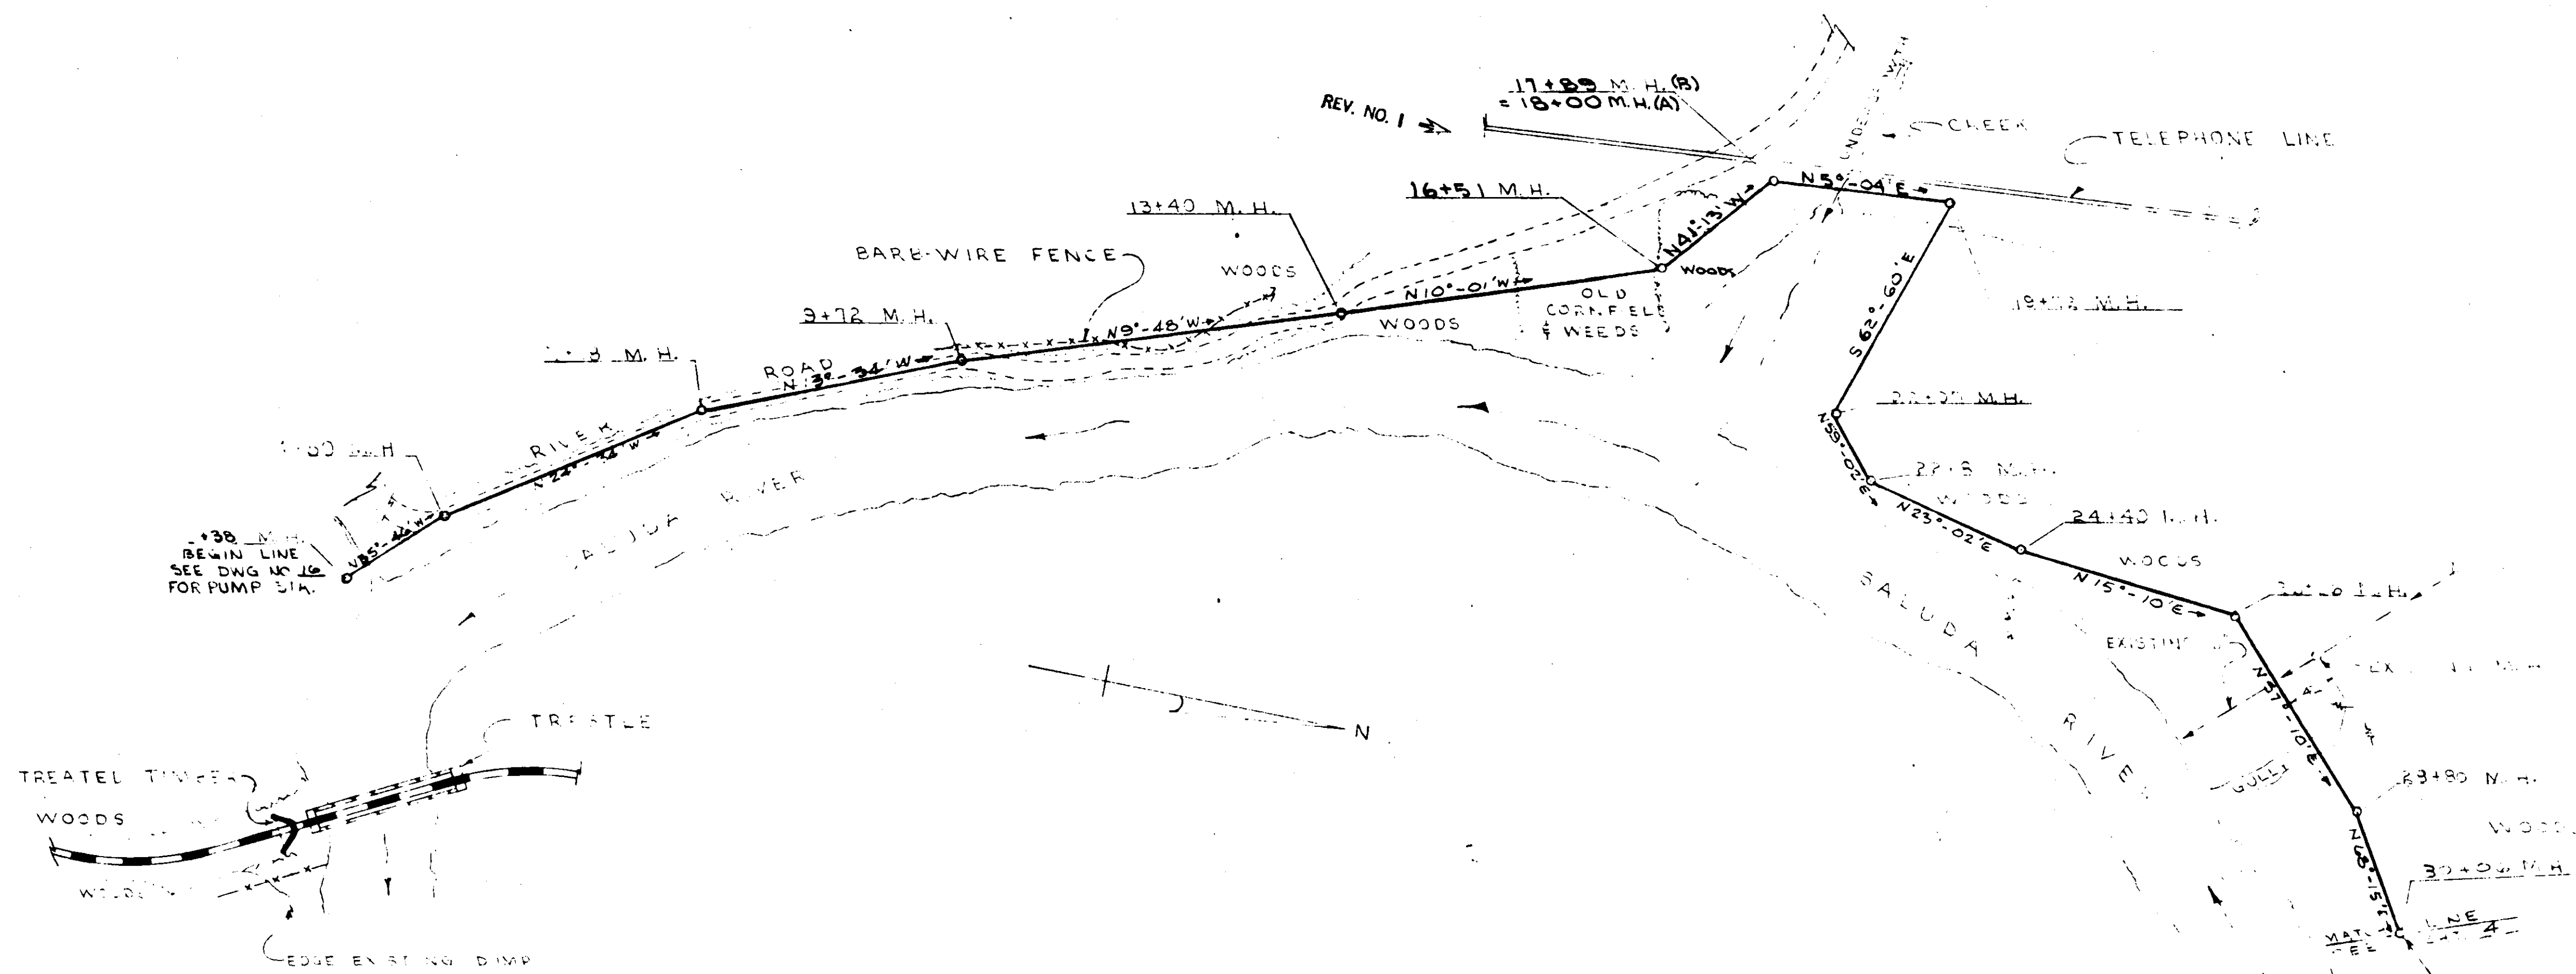

BOOK 4 V PAGE 14

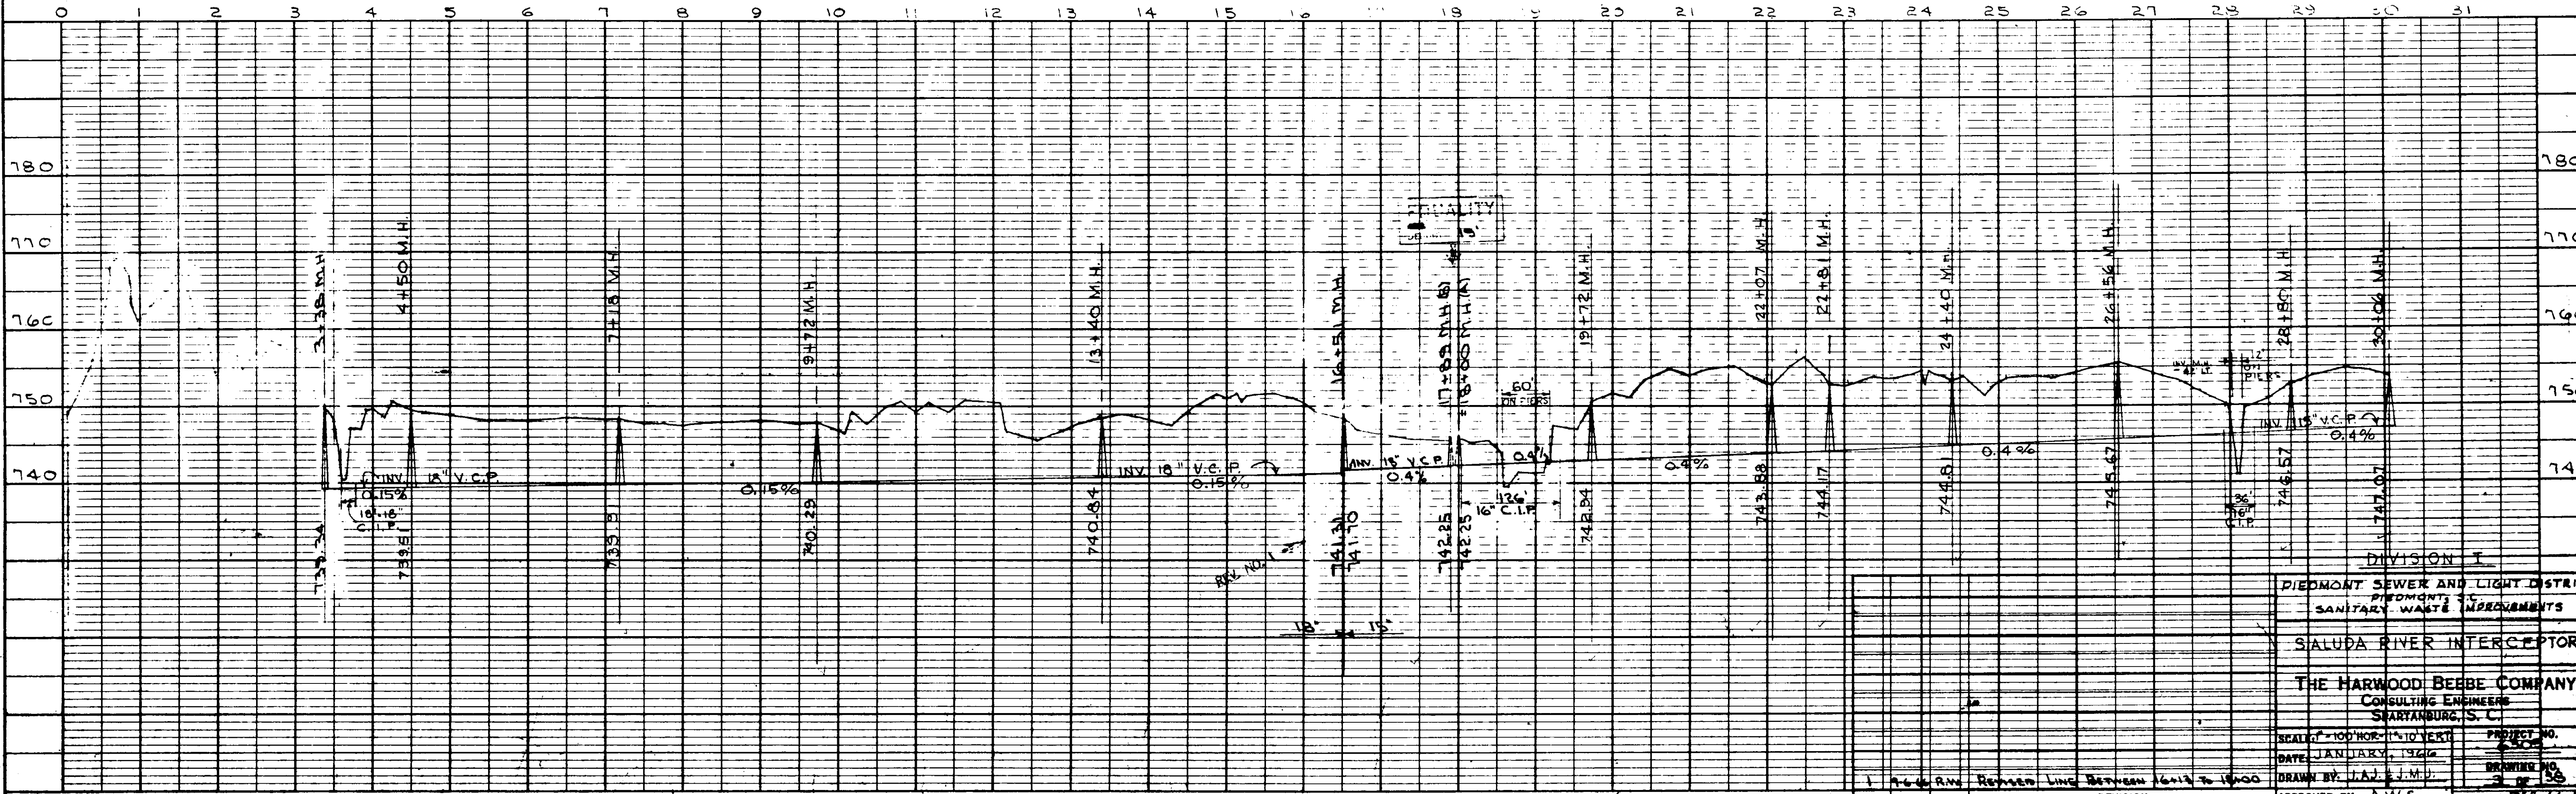

DIVISION I

PIEDMONT SEWER AND LIGHT DISTRICT  
PIEDMONT, S.C.  
SANITARY WASTE IMPROVEMENTS

SALUDA RIVER INTERCEPTOR

THE HARWOOD BEEBE COMPANY  
CONSULTING ENGINEERS  
SPARTANBURG, S.C.

DRAWN BY: J.A.L. (J.M.H.)  

NO. DATE BY REVISION APPROVED BY: A.W.S. FILE NO. 25-44-3