

DATE	
BY	
REVISIONS	
NO. 1	
NO. 2	
DATE	
BY	
REVISIONS	
NO. 1	
NO. 2	
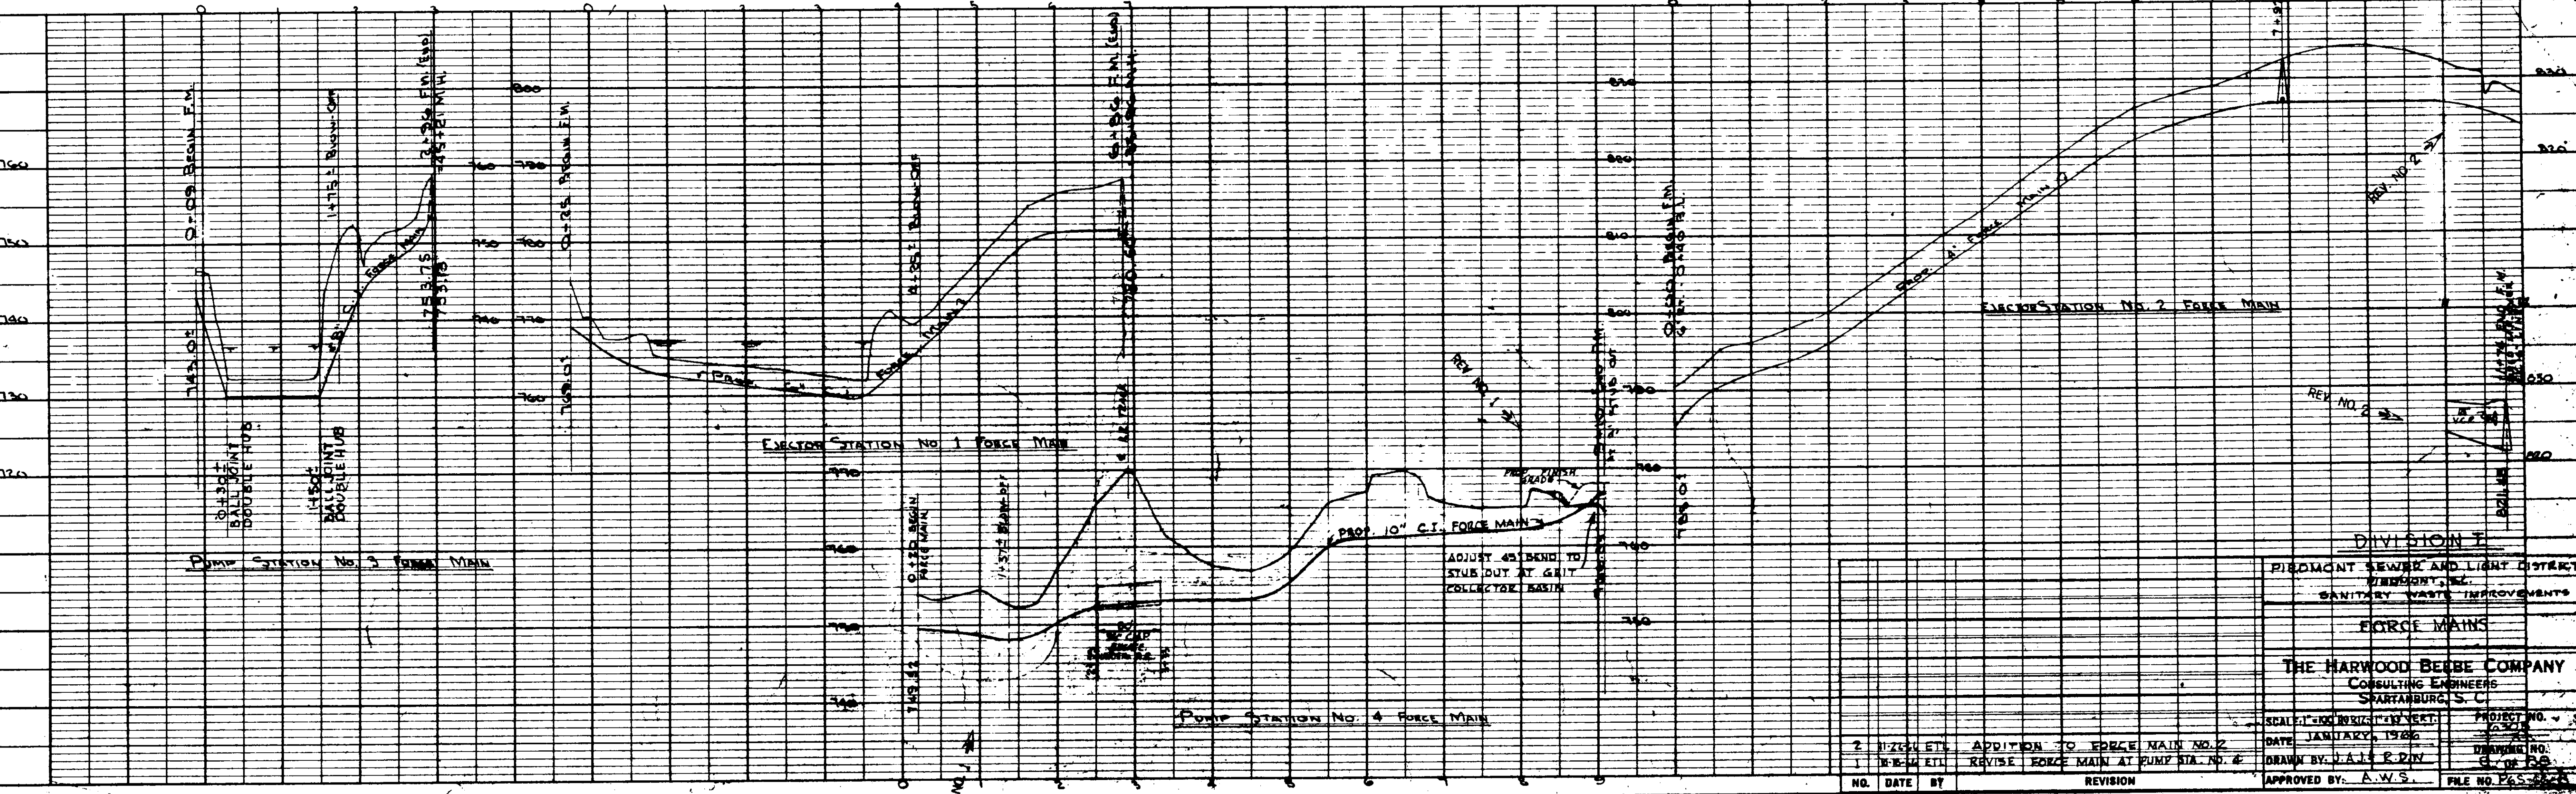
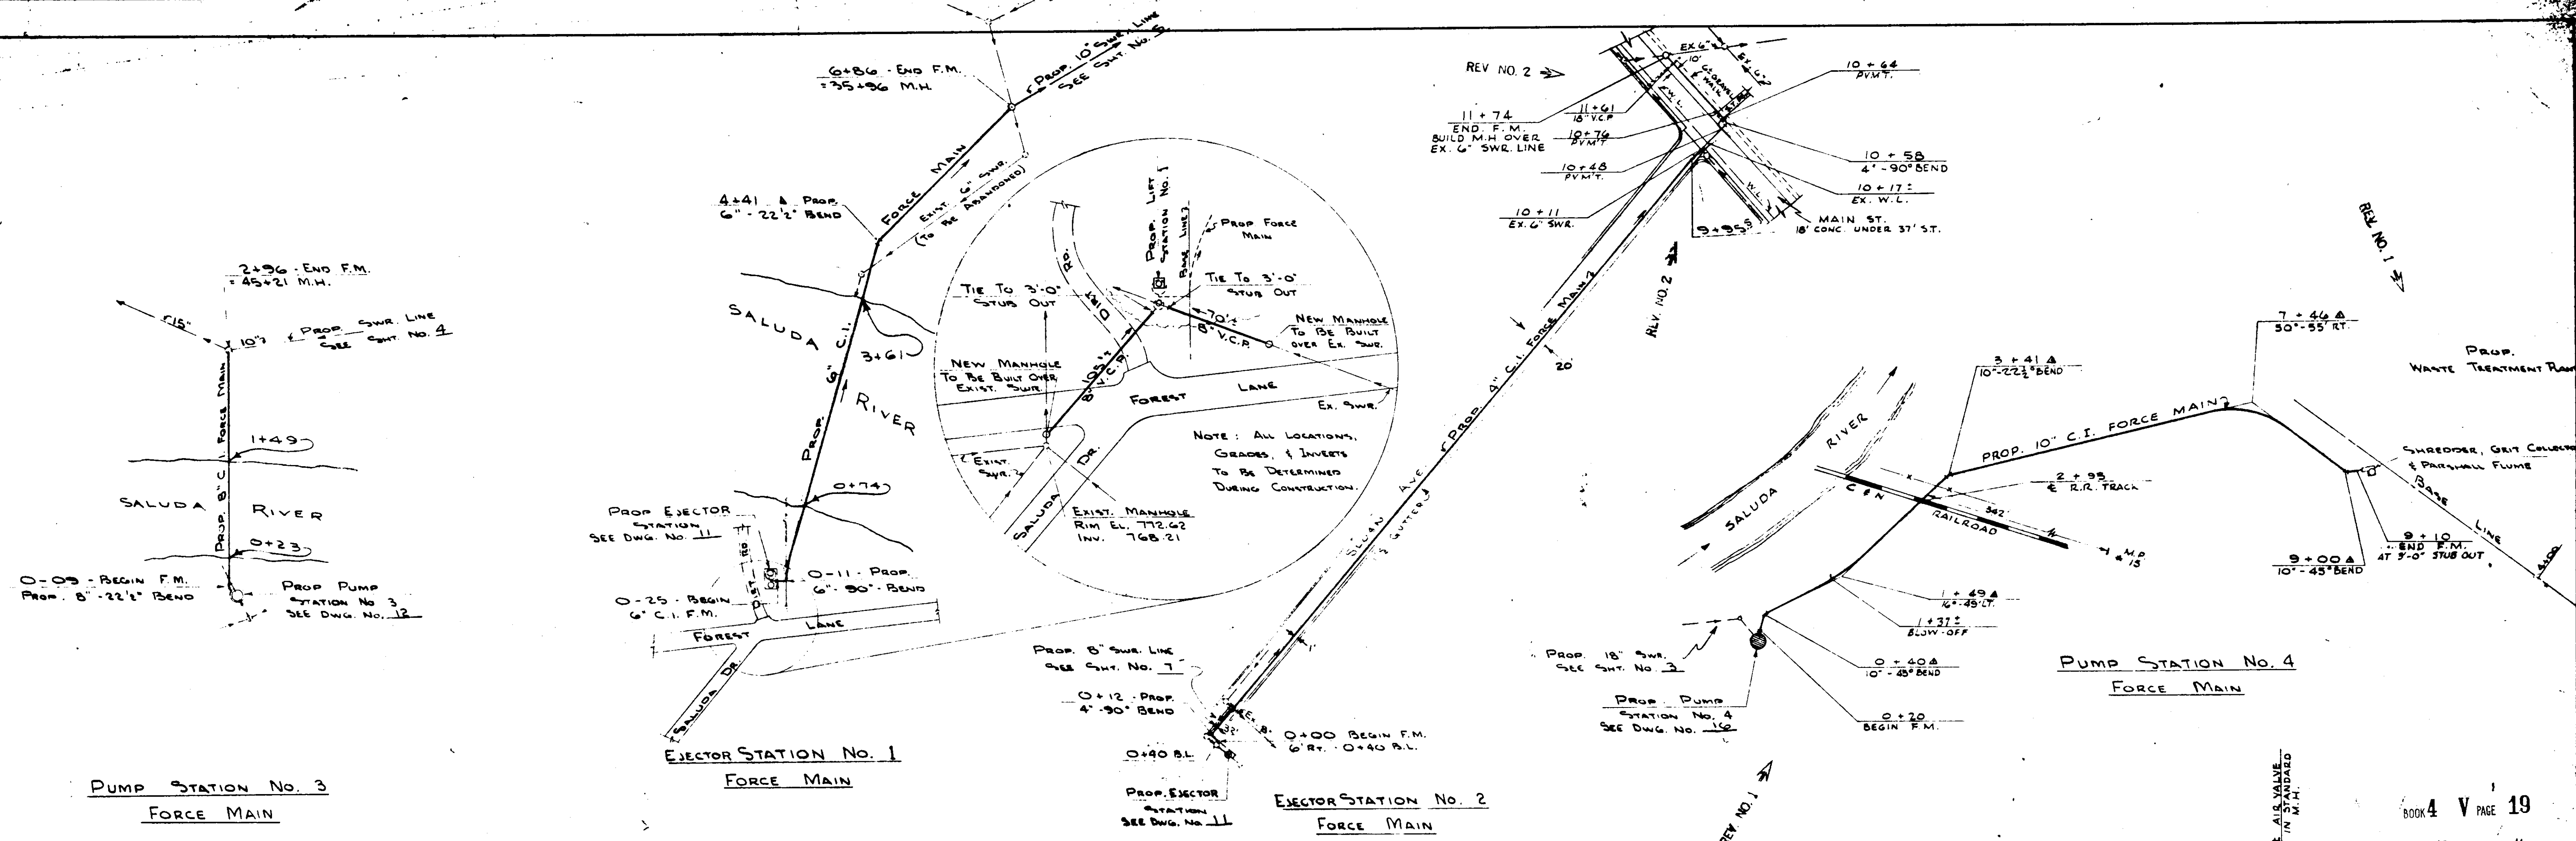


PLATE 1-PLAN-PROFILE D.P.S.R.E. STANDARD  
100% RAS PAPER-MADE AND PRINTED IN U. S. A.  
EUBENE DIETZEN CO.

DIVISION I			
PIEDMONT SEWER AND LIGHT DISTRICT			
SANITARY WASTE IMPROVEMENTS			
FORCE MAINS			
THE HARWOOD BEBE COMPANY			
CONSULTING ENGINEERS			
SPARTANBURG, S. C.			
NO. DATE BY	REVISION	APPROVED BY: A. W. S.	FILE NO. P.S. 2824