Microfilmed

FED. ROAD DIST. No.	STATE	FEDERAL PROJ. NO.	FISCAL YEAR	SHEET No.	TOTAL SHEETS

PLAN — SURVEYED, PLOTTED, ALIGNMENT CHECKED, R/E OF WAY CHECKED — NOTE BOOK NO. — BY — DATE

PROFILE — SURVEYED, PLOTTED, GRADES CHECKED, R/E OF WAY CHECKED — NOTE BOOK NO. — STRUCTURE NOTATNS CHKD — BY — DATE

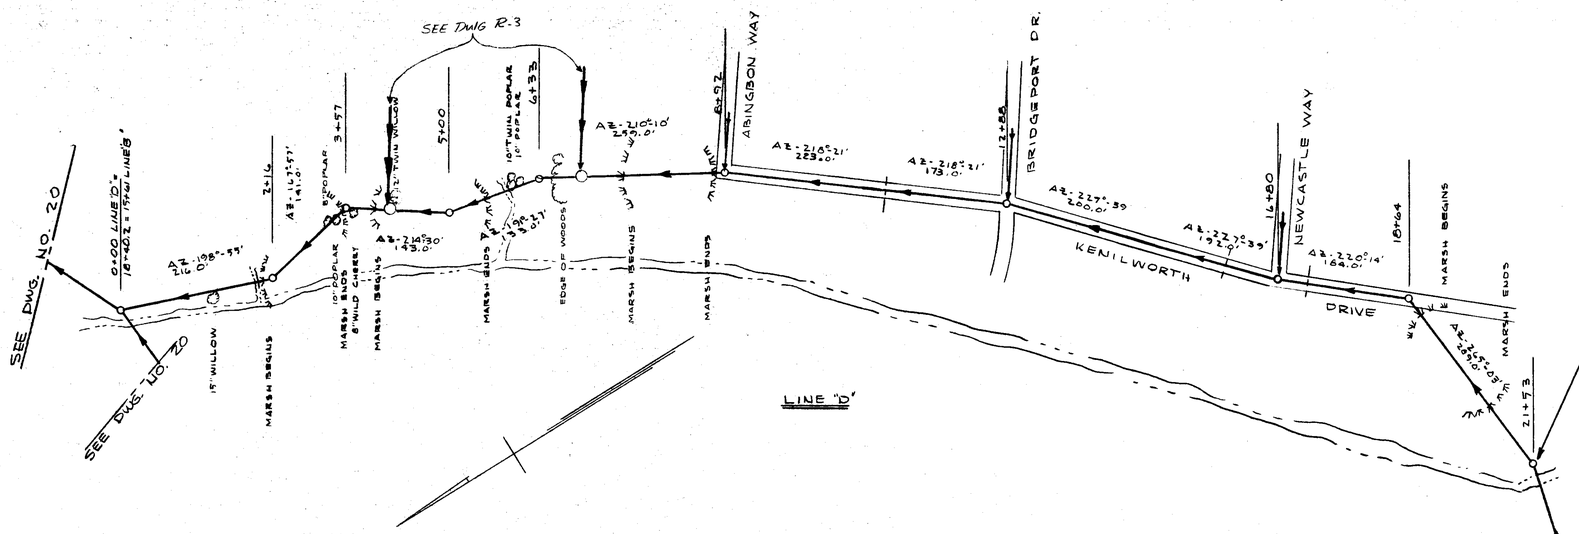

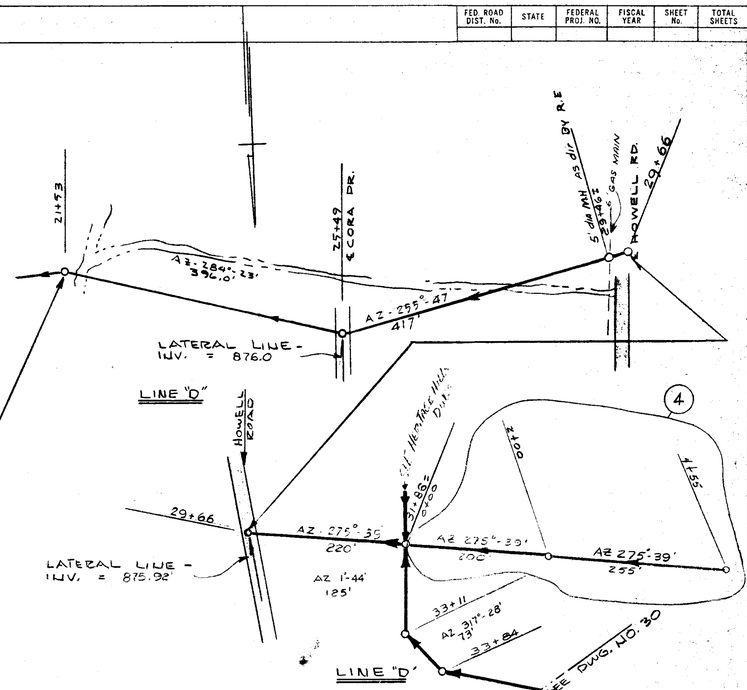

NO.	DATE	BY	REVISIONS
3	9/3/68	RLC	ADDED LINE
2	1-7-66	RE D	REVISED PLAN & PROFILE
1	9-23-65	P C	GENERAL

WADE HAMPTON WATER AND SEWER DISTRICT
GREENVILLE COUNTY, S. C.

PLAN AND PROFILE TRUNK SYSTEM

PIEDMONT ENGINEERING SERVICE
GREENVILLE, S. C.

DRAWN BY | CHECKED BY | DATE OCT 1963 | DWG. NO. 29

SCALE
HOR. 1" = 100'
VERT. 1" = 10'

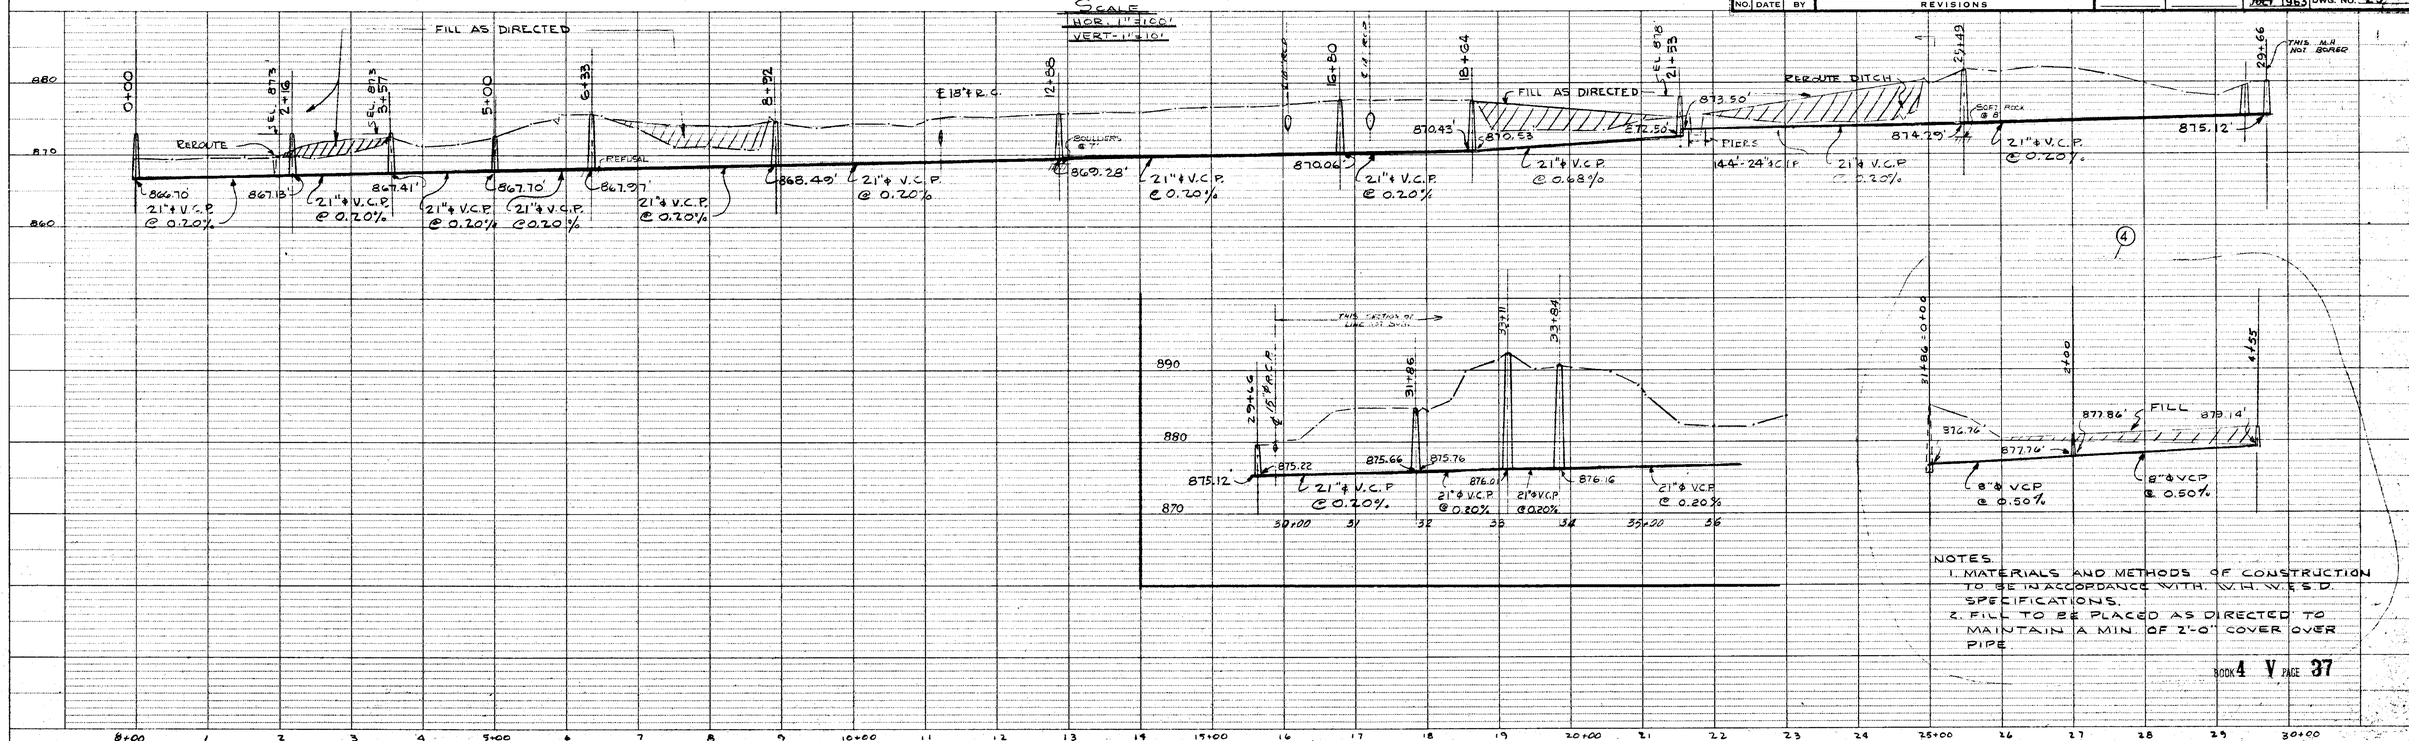

NOTES.
1. MATERIALS AND METHODS OF CONSTRUCTION TO BE IN ACCORDANCE WITH W.H.W.&S.D. SPECIFICATIONS.
2. FILL TO BE PLACED AS DIRECTED TO MAINTAIN A MIN. OF 2'-0" COVER OVER PIPE.

BOOK 4 V PAGE 37

SINGLE PLAN AND PROFILE — DOTTED
H. A. ROGERS CO. - MINNEAPOLIS - ST. PAUL - DULUTH

State Proj. No. ..... Sheet No. ..... of ..... Sheets