Microfilmed

PROFILES
EAST LAGOON DRAINAGE AREA

FINAL SURVEY — SURVEYED / PLOTTED / TEMPLATE / AREAS / AREAS CHECKED — NOTE BOOK No. 8-22 — BY — DATE

ORIGINAL SURVEY — SURVEYED / PLOTTED / TEMPLATE / AREAS / AREAS CHECKED — NOTE BOOK — NO. — BY — DATE

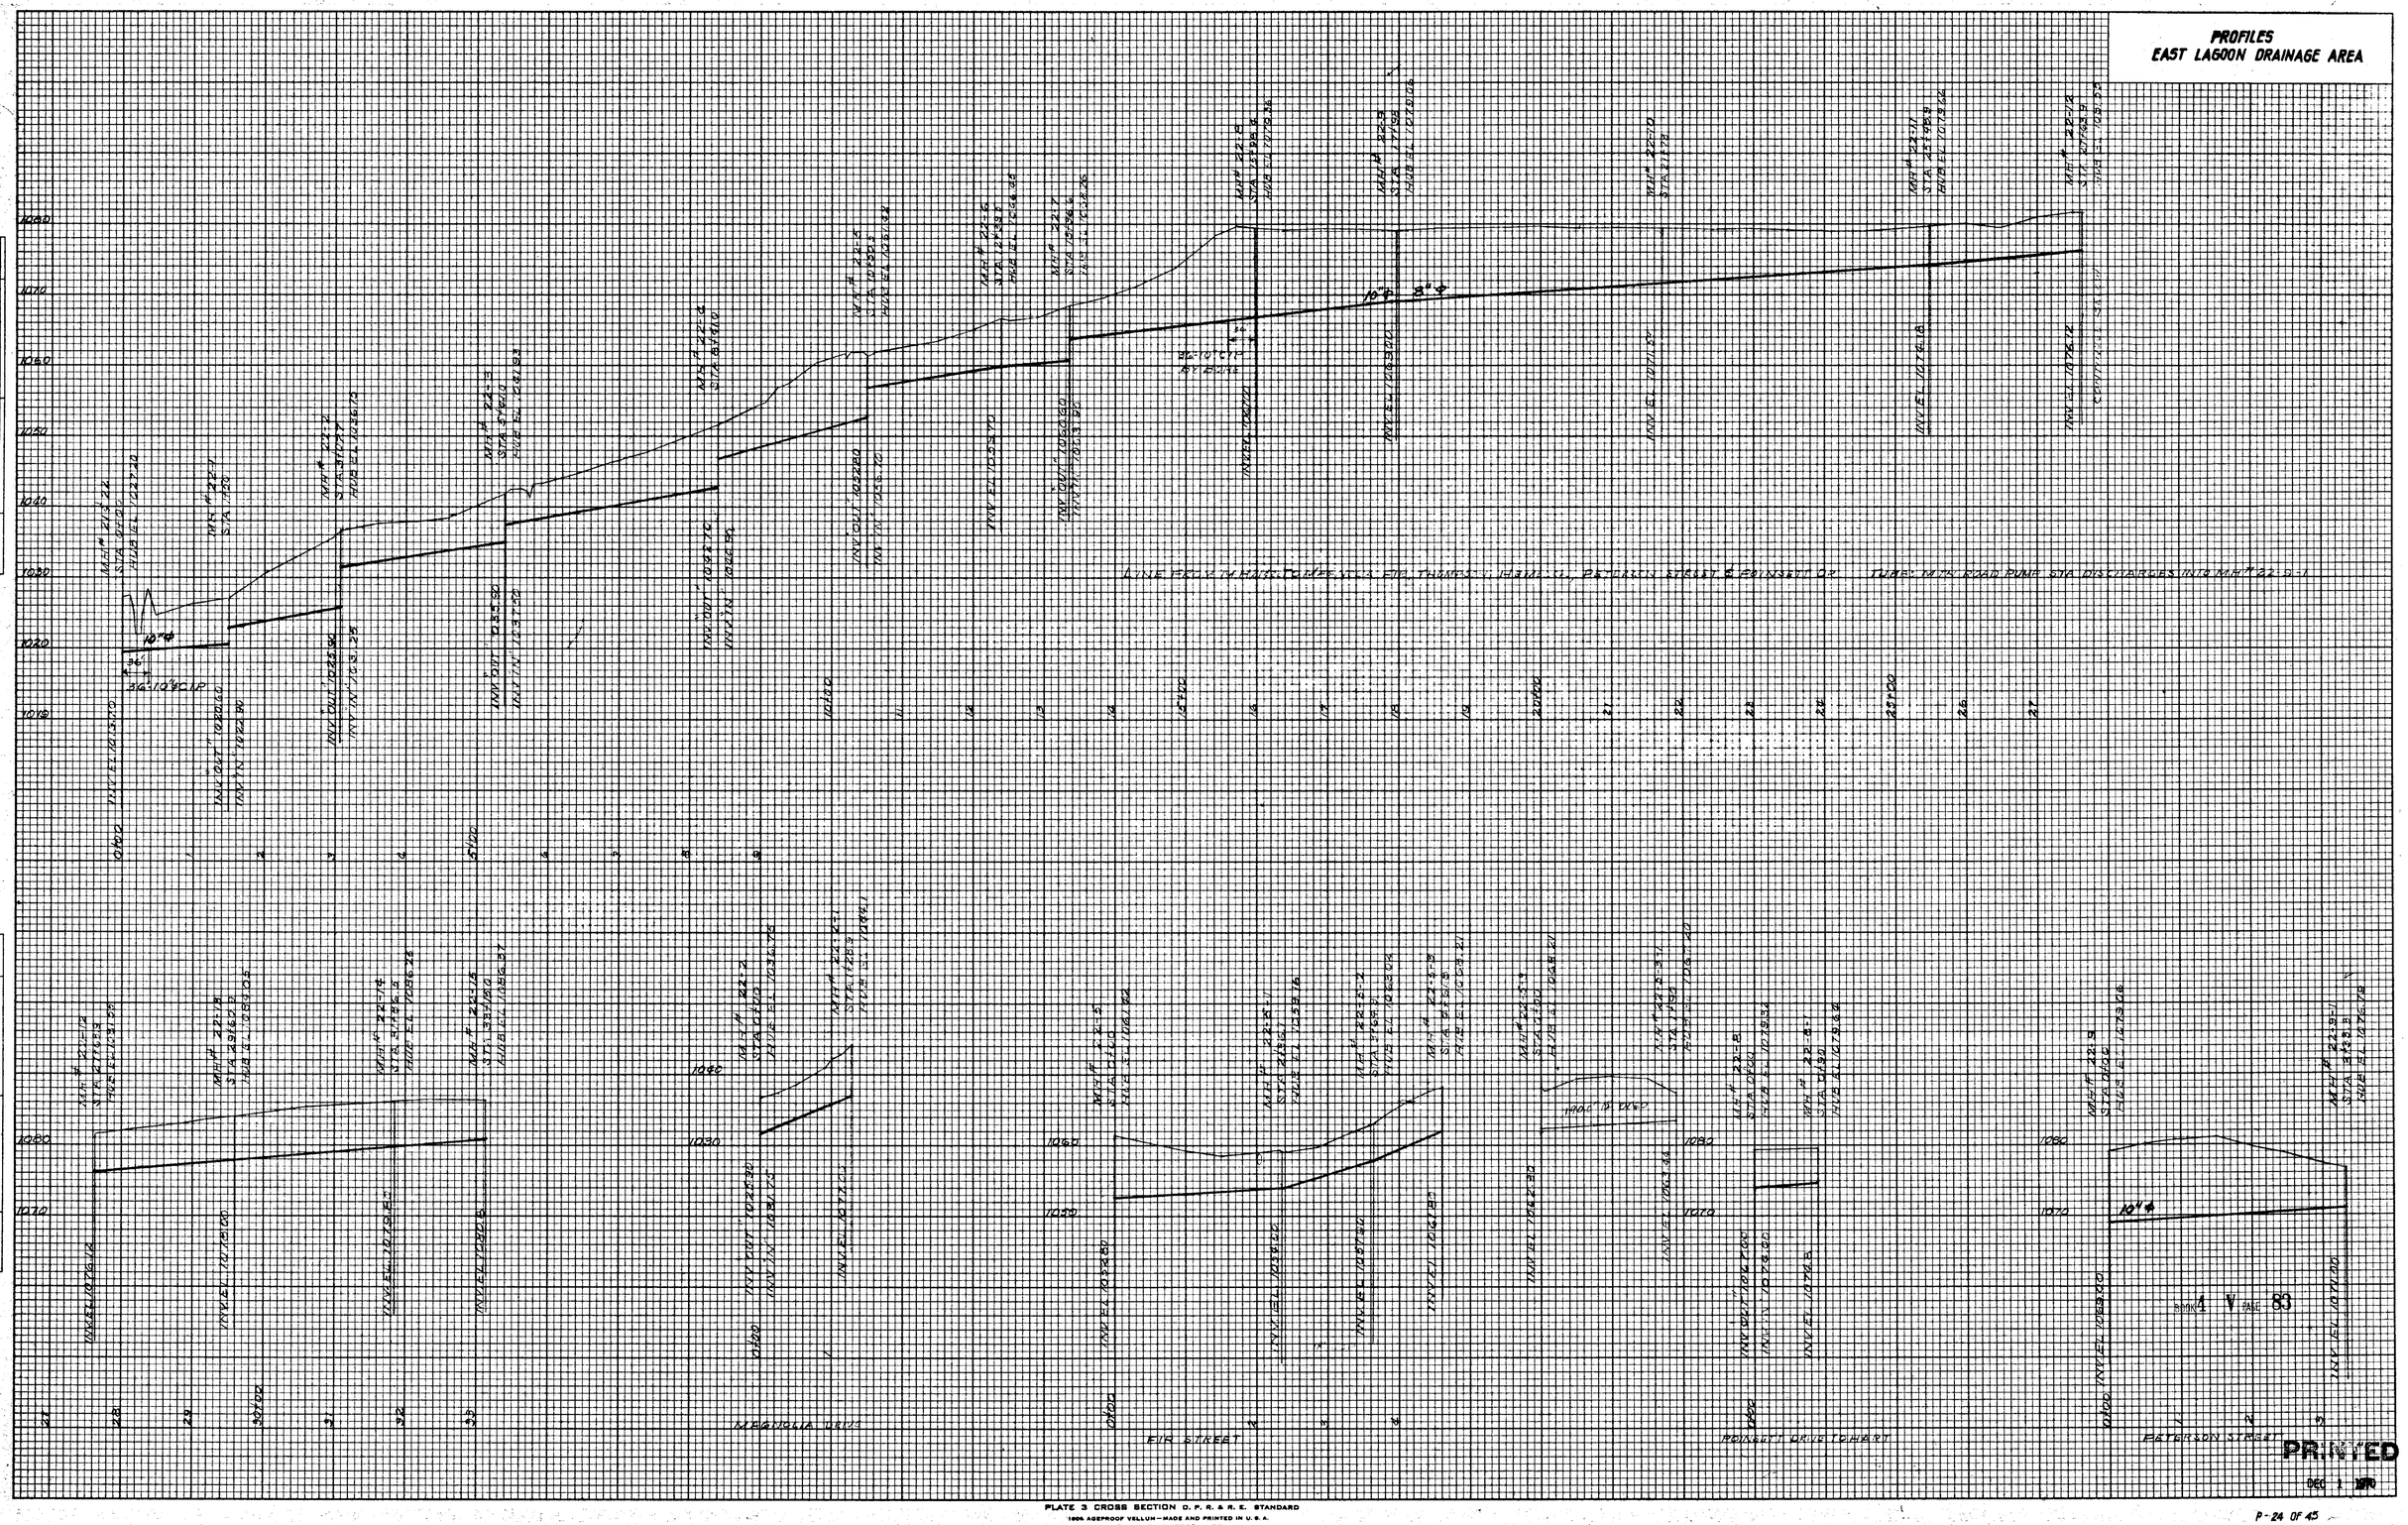

PLATE 3 CROSS SECTION O. F. R. & R. E. STANDARD

100% AGEPROOF VELLUM — MADE AND PRINTED IN U. S. A.
EUGENE DIETZGEN CO.

APPROVED
DEC 1 1970