


PROFILES
EAST LAGOON & STATE PARK RD. DRAINA. AR.



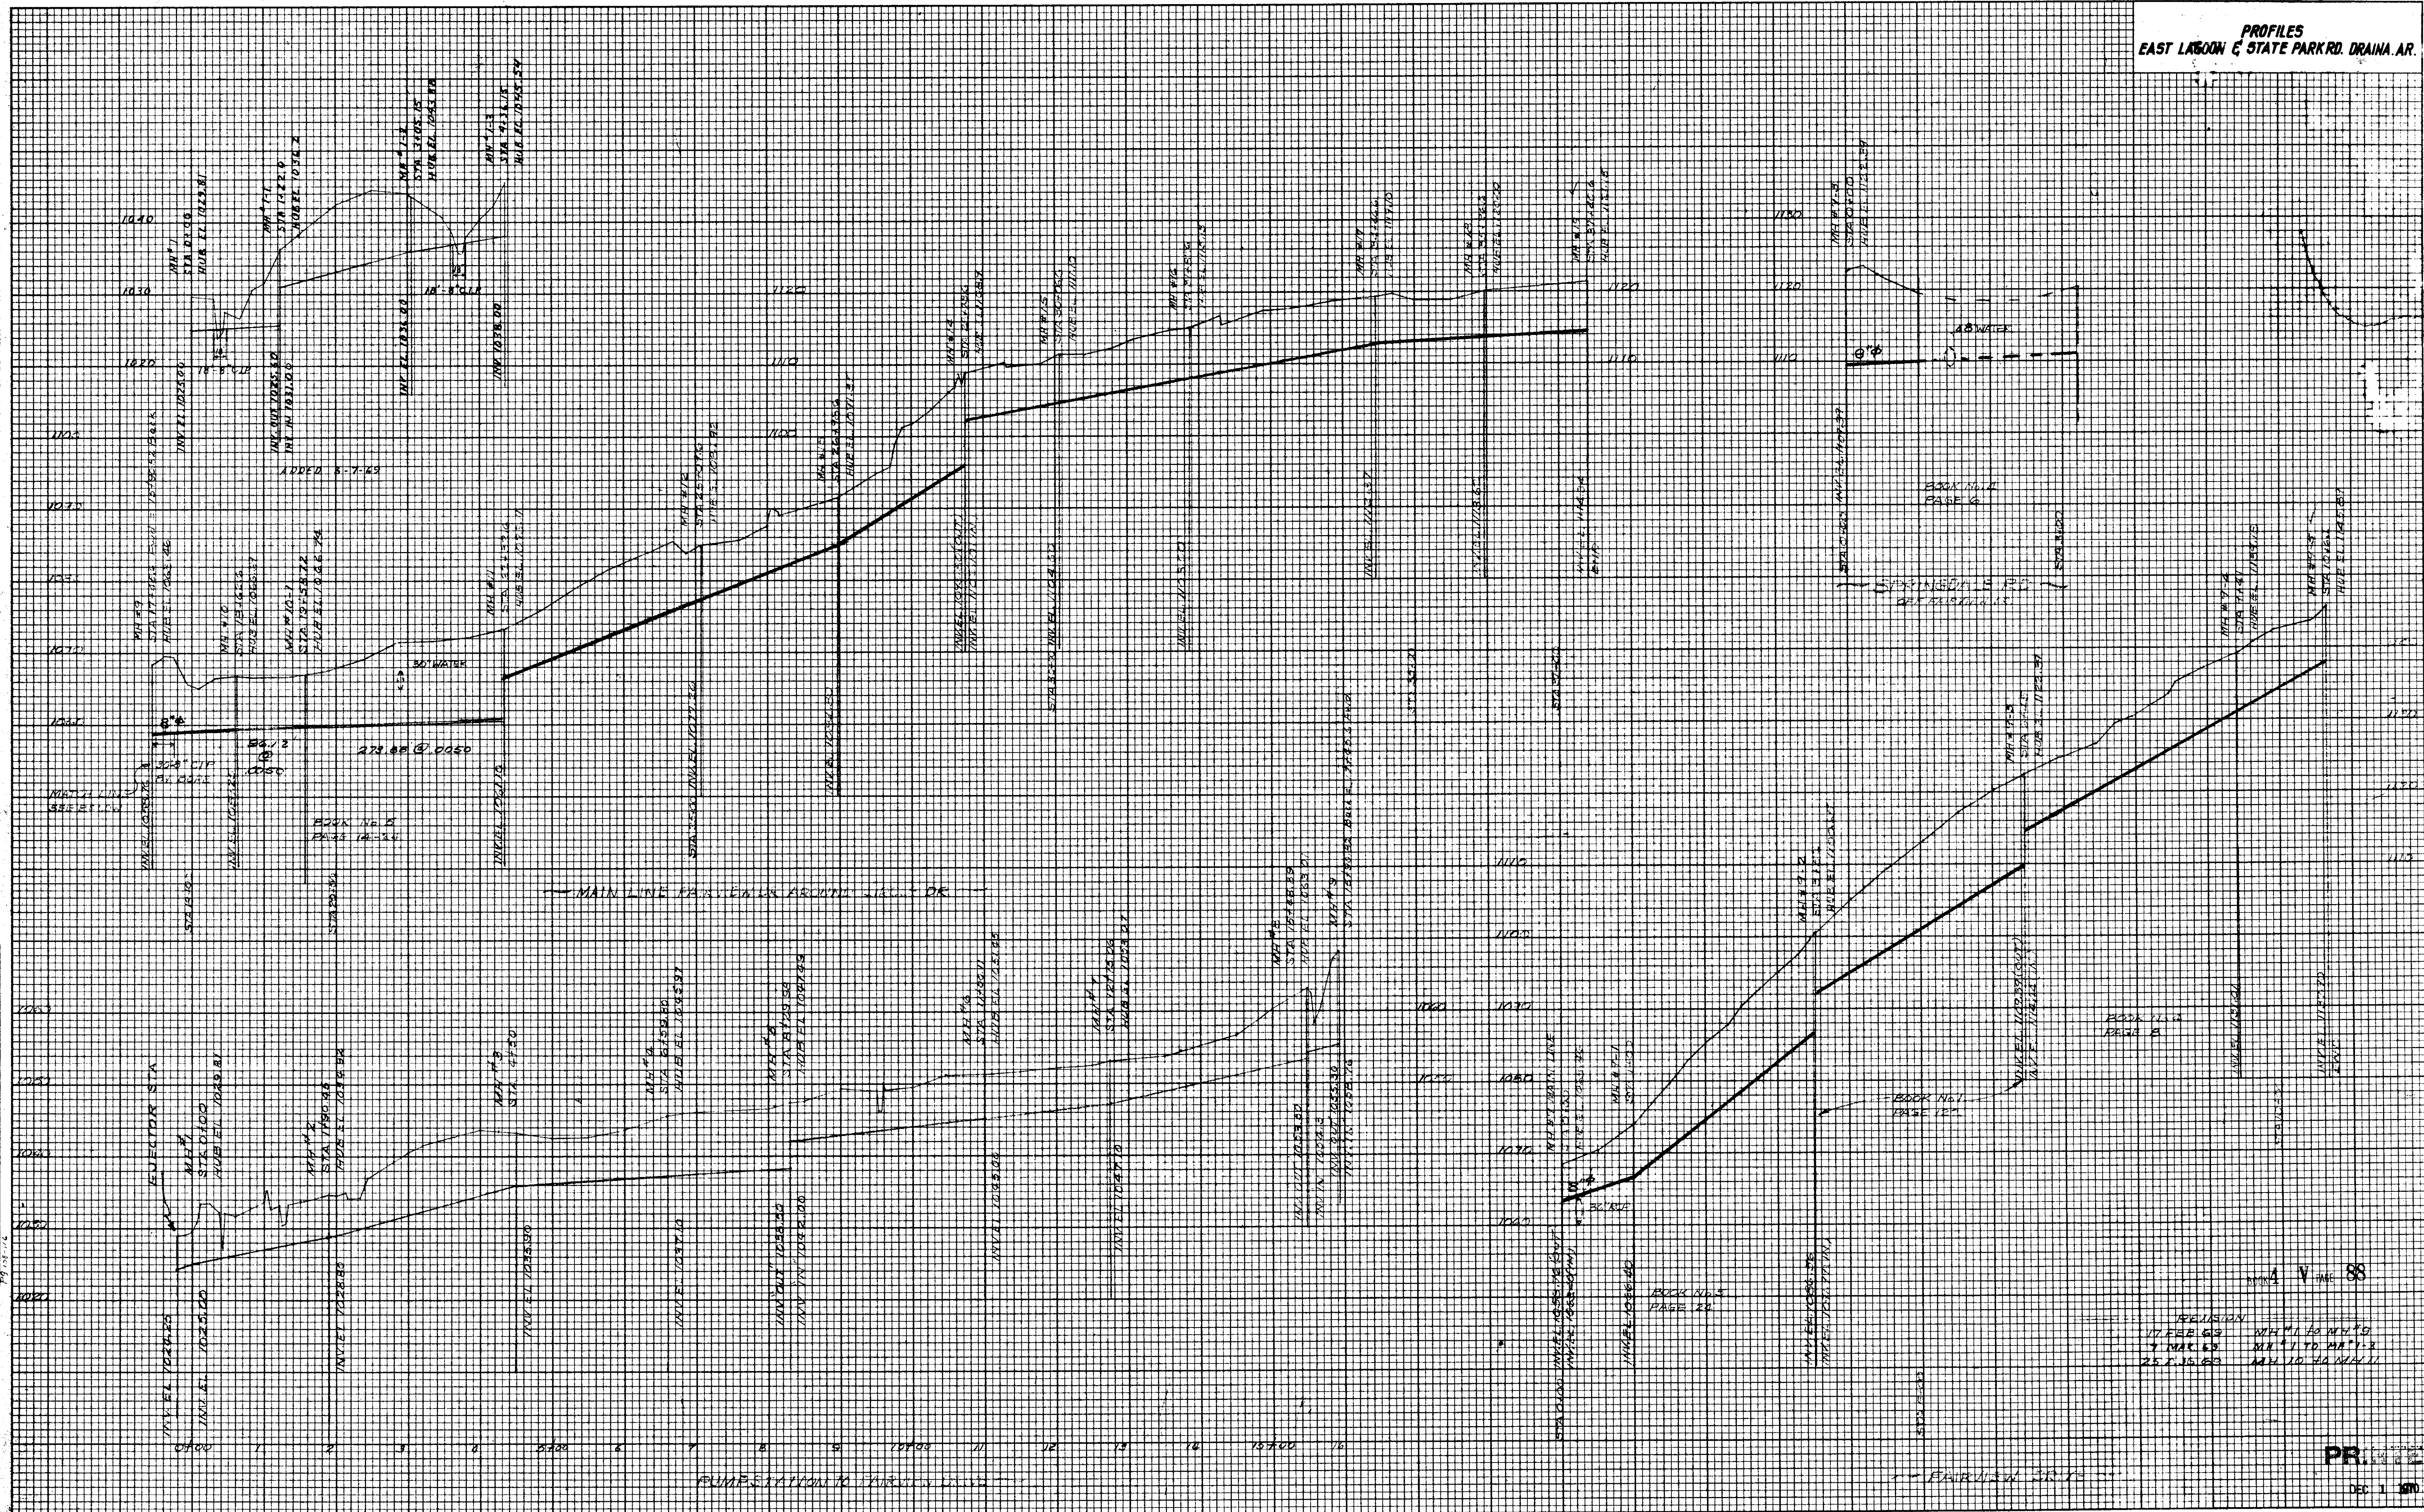

REVISION
 17 FEB 63
 1 MAR 63
 25 F 35 63

