


PROFILES
TUBBS MTN. RD. DRAINAGE AREA

DATE	
BY	
FINAL SURVEY	
QUANTITY	
REMARKS	
NO. OF SHEETS	
NO. OF SHEETS CHECKED	

DATE	
BY	
ORIGINAL SURVEY	
QUANTITY	
REMARKS	
NO. OF SHEETS	
NO. OF SHEETS CHECKED	

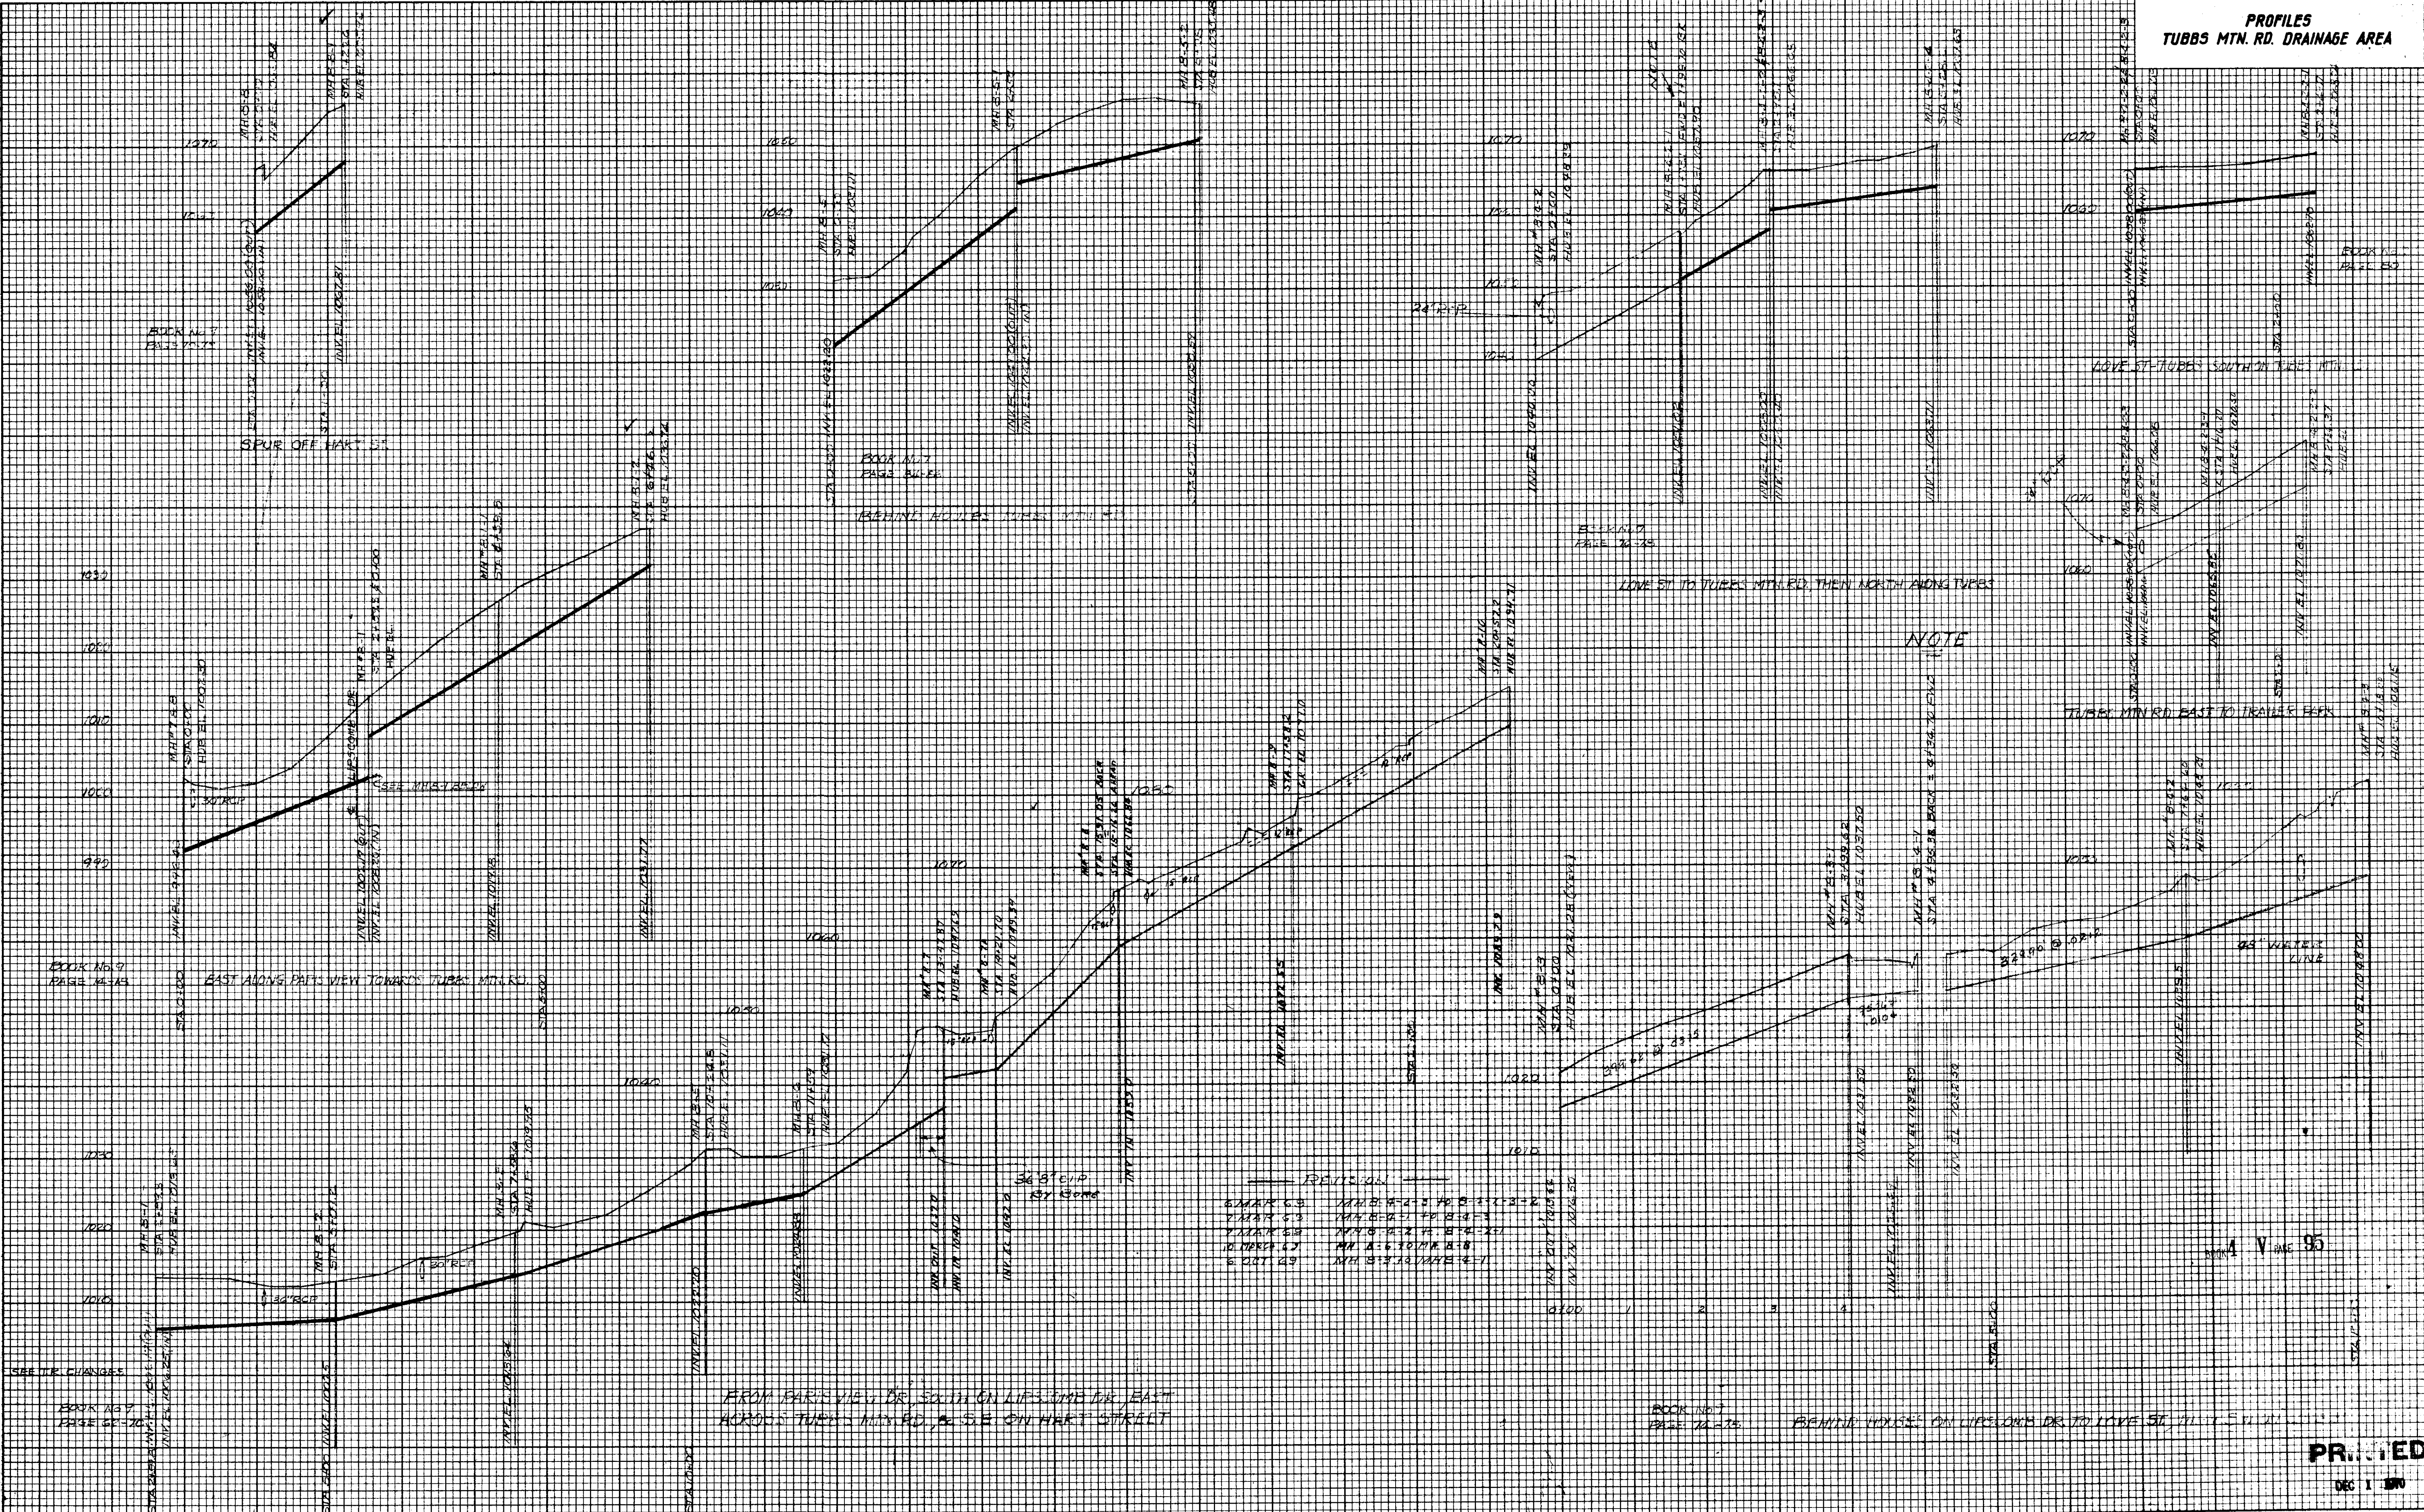

SEE TR. CHANGES

BOOK NO. 7
PAGE 66-70

FROM PARK VIEW DR. SOUTH ON LIPS DAMS DR. EAST
ACROSS TUBBS MOUNTN RD. & S.E. ON HART STREET

BOOK NO. 7
PAGE 70-75

BENTON HOUSES ON LIPS DAMS DR. TO LOVE ST. SEE PLAN

REVISION

6 MAR 65	M.H.B. 4-2-3 TO 5-1-3-2
1 MAR 53	M.H.B. 2-1-2 TO 3-0-3
1 MAR 53	M.H.B. 2-1-2 TO 3-0-3
10 APR 47	M.H. 2-6-3 TO 2-1-8
6 OCT 49	M.H. 3-2-1 TO 3-1-1

NOTE

TUBBS MOUNTN RD. EAST TO TRAILS PARK

LOVE ST. TO TUBBS MOUNTN RD. THEN NORTH ALONG TUBBS

LOVE ST. TUBBS SOUTH ON TUBBS MOUNTN RD.

PRINTED

DEC 1 1950