

20672
JAN 25 1973
FILED
GREENVILLE CO. S. C.
MAR 22 1973
CORNER MARKERSLEY

ADDITIONS AND IMPROVEMENTS

TO THE

SANITARY SEWERAGE SYSTEM

FOR THE

TOWN OF FOUNTAIN INN SOUTH CAROLINA

PROJECT NO. WPC-SC-131

MAYOR MENTONE O. McGEE

COUNCILMEN

W. D. ABERCROMBIE

HUBERT HENDRICKS

EARL BARBREY


ROY L. NEWTON

BRUCE FARROW

T. CHARLES THACKSTON

— = E.L.I.G. PL 660

BOOK 4 V PAGE 141

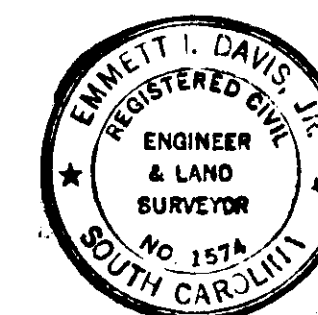

PRINTED

MAR 23 1971

DAVIS AND FLOYD ENGINEERS, INC.
CONSULTING ENGINEERS
GREENWOOD, S. C. ATLANTA, GA.

OWNER

TITLE

DESIGNED:
DRAWN:
CHECKED:
APPROVED:

DATE: AS BUILT PLANS
REVISIONS BY

SCALE:
DATE:

CONTRACT NO.
SH. OF