



REVISIONS			PIEDMONT ENGINEERS & ARCHITECTS	
NO.	DATE	BY		
1	12-7-74	RA	CO-SUBMITTED NAME ON LOT # 120	
2	3-4-75	RA	RELOCATED LINE ON LOTS 44, 45, 46, 47, 48	
3	2-17-76	RA	VOID LOT # 102 & REVISED LOT # 95	

RELEASED - 7-11-75  
 RE-RELEASED - 10-27-75  
 " " 12-8-75  
 " " 12-30-75  
 " " 6-4-76  
 " " 7-7-76

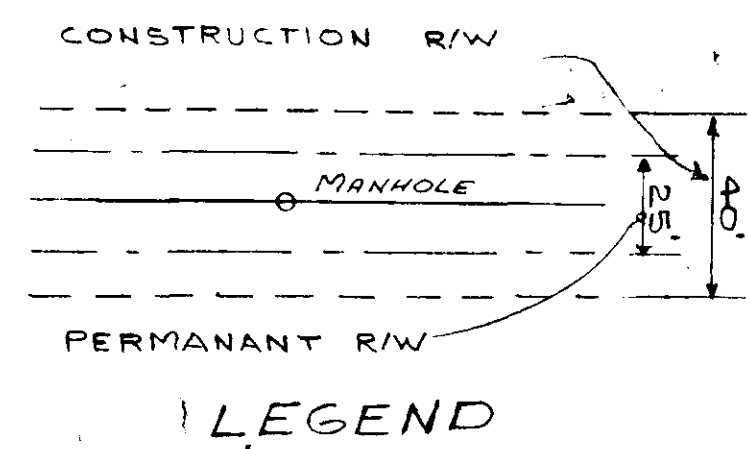

JUL 8 1976  
 MICROFILMED  
 BOOK 4 V PAGE 193

639

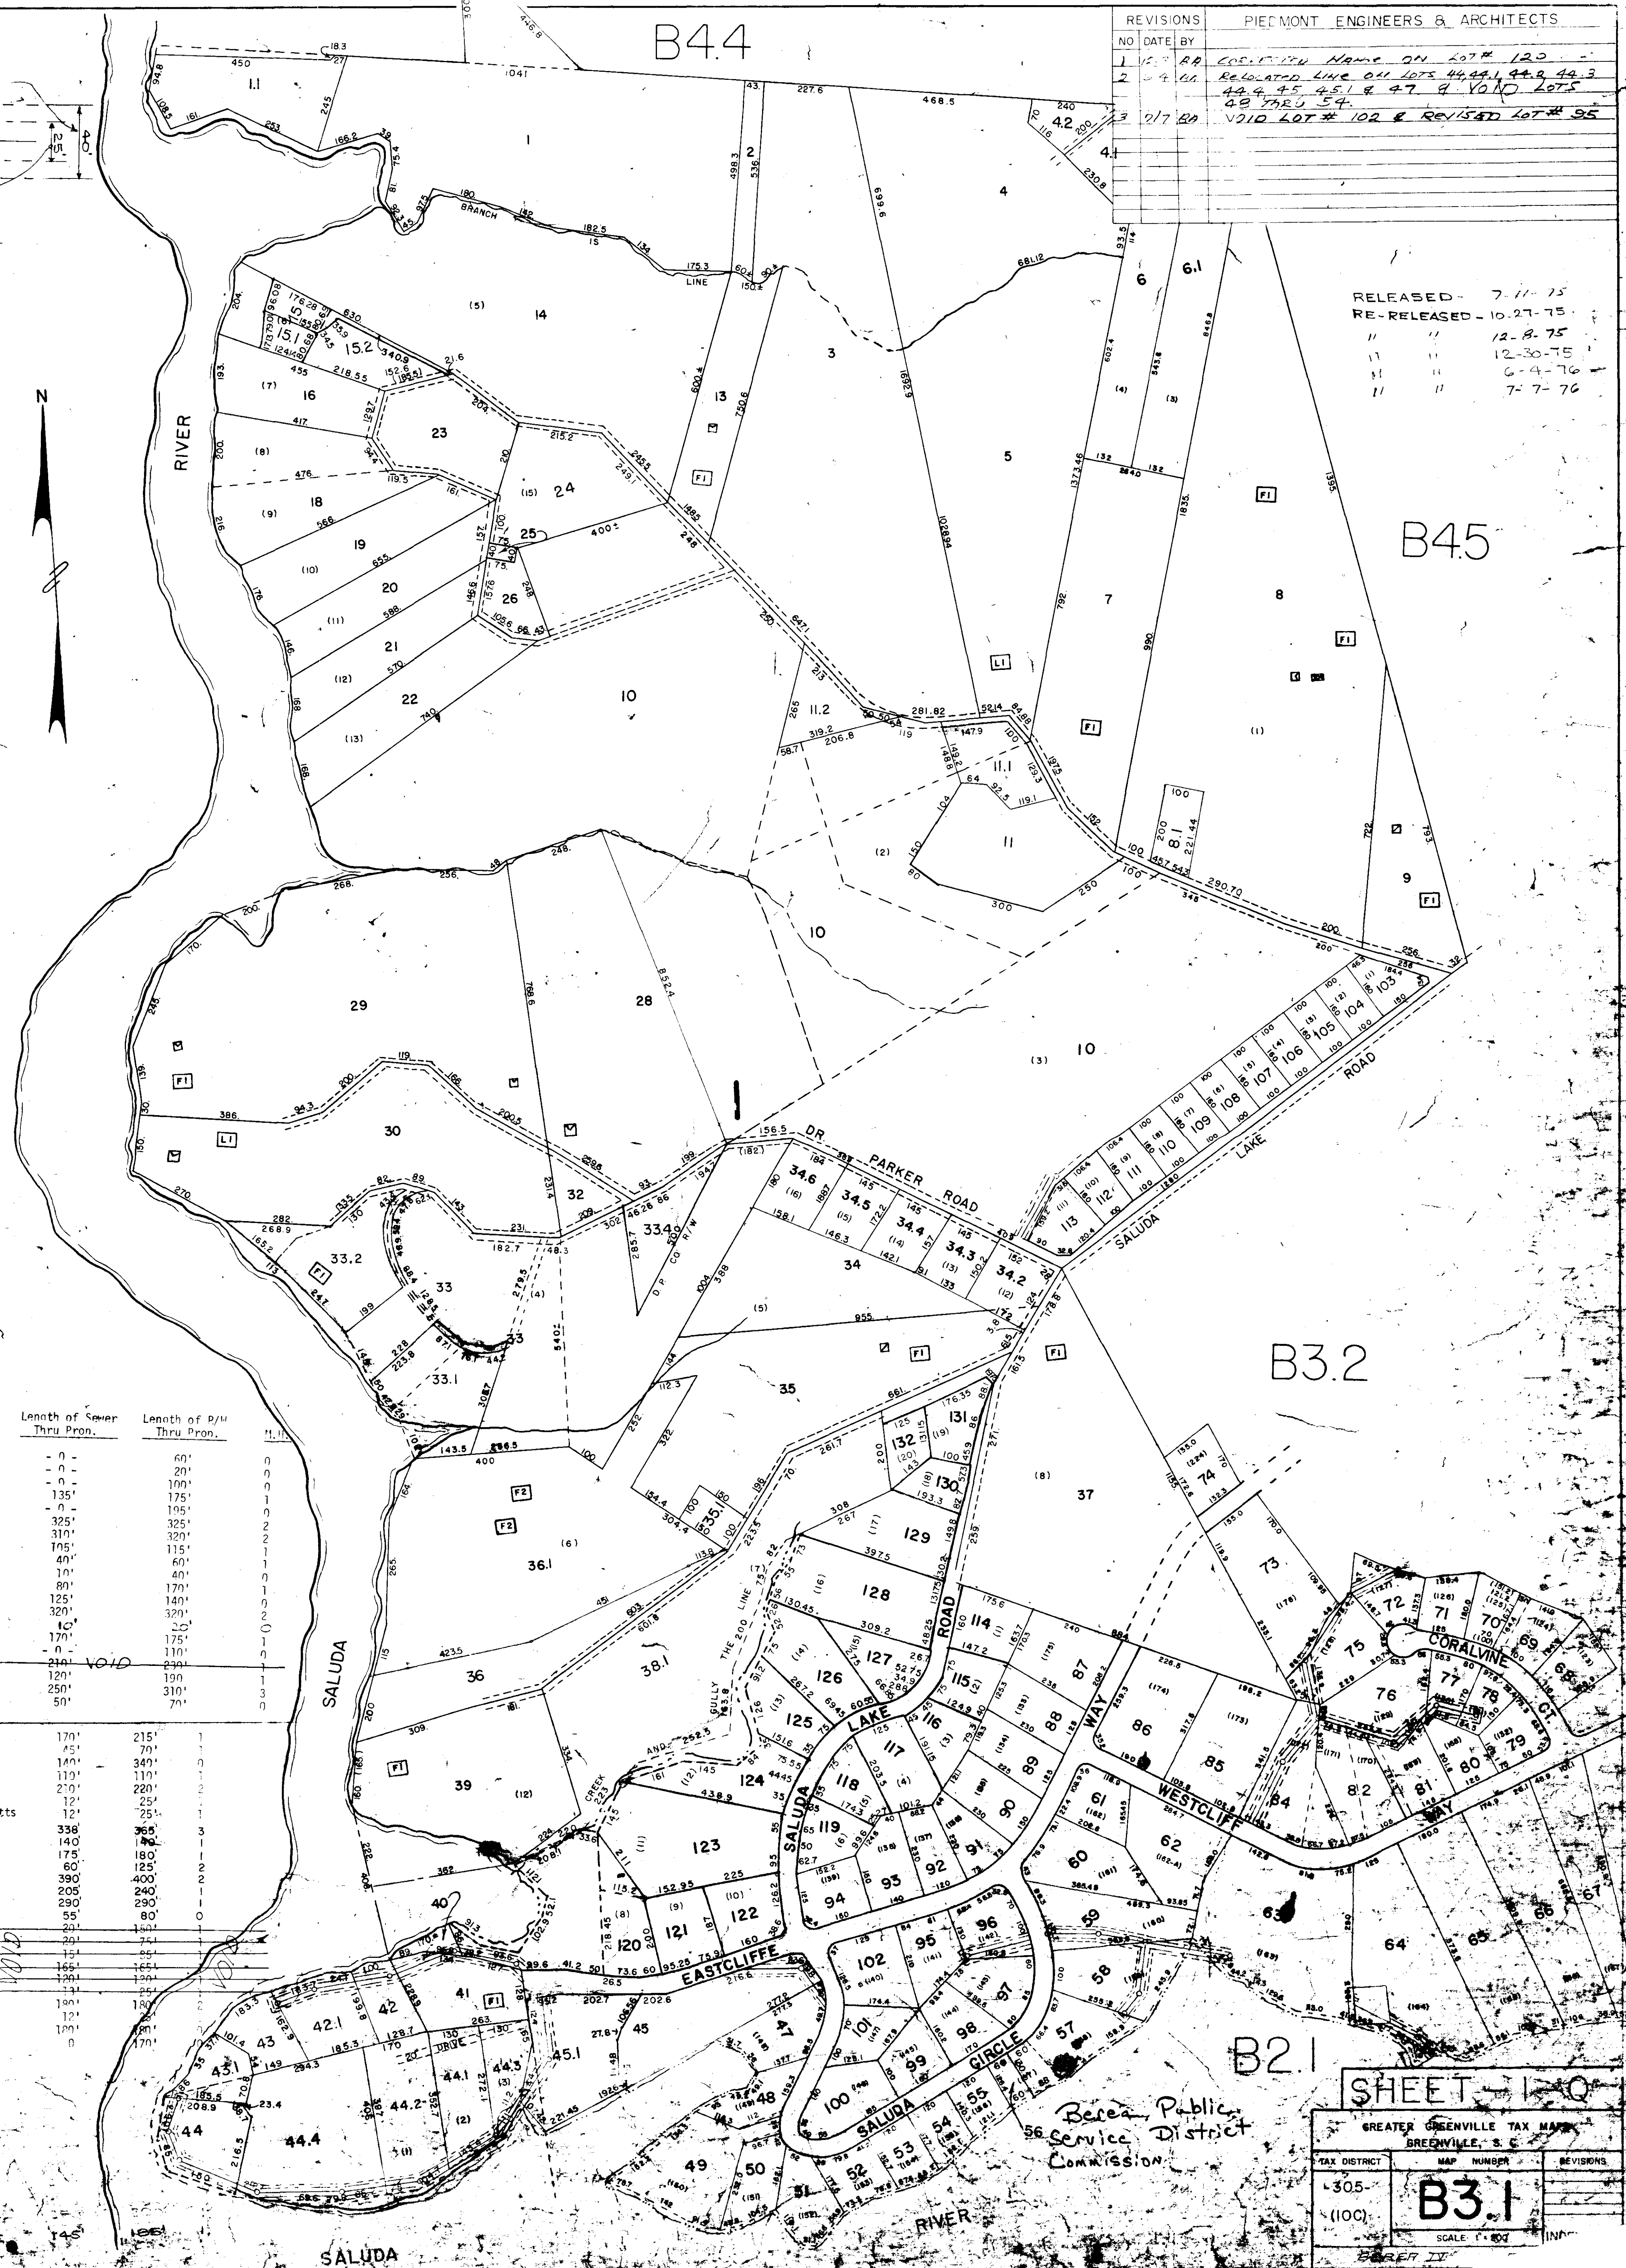

ITEM	BLOCK BOOK #	NAME	Length of Sewer Thru Prop.	Length of R/W Thru Prop.	M. I.
1	R3.1-1-69	Harry B. & Pam A. Shucker	0	60'	0
2	R3.1-1-70	Charles R. & Betty C. Elliott	0	20'	0
3	R3.1-1-71	Charles R. & Betty C. Elliott	0	100'	0
4	R3.1-1-72	P. F. Huff	135'	175'	1
5	R3.1-1-73	Charles Elizabeth Huff	0	195'	0
6	R3.1-1-74	R. F. Huff	325'	325'	2
7	R3.1-1-75	O. Suther Jr. & Mary H. Sims	310'	320'	2
8	R3.1-1-76	O. Suther Jr. & Mary H. Sims	105'	115'	1
9	R3.1-1-77	O. Suther Jr. & Mary H. Sims	40'	60'	0
10	R3.1-1-78	J. P. & Penny B. Owens	10'	40'	0
11	R3.1-1-79	Dev F. & Virginia L. Wilson	80'	170'	1
12	R3.1-1-80	Garv P. & Ann R. Kinn	125'	140'	1
13	R3.1-1-81	Dianne R. Cagle	320'	320'	2
14	R3.1-1-82	Patrick D. & Manda C. Howell	10'	25'	0
15	R3.1-1-83	J. P. Hall	170'	175'	1
16	R3.1-1-84	William S. & Doris C. Bynum	0	110'	0
17	R3.1-1-85	William S. & Doris C. Bynum	210'	240'	1
18	R3.1-1-86	William S. & Doris C. Bynum	VOID	VOID	VOID
19	R3.1-1-87	William S. & Doris C. Bynum	120'	190'	1
20	R3.1-1-88	William S. & Doris C. Bynum	250'	310'	3
21	R3.1-1-89	William S. & Doris C. Bynum	50'	70'	0

ITEM	BLOCK BOOK #	NAME	Length of Sewer Thru Prop.	Length of R/W Thru Prop.	M. I.
1	R3.1-1-120	H.E. Duwe	170'	215'	1
2	R3.1-1-121	H.F. Duwe	45'	70'	0
3	R3.1-1-122	Samuel T. Glenn	140'	340'	0
4	R3.1-1-123	Charles M. & Charlotte Durham	110'	110'	0
5	R3.1-1-124	Julian G. Hunt	210'	220'	2
6	R3.1-1-125	Anderson Jr. & Margaret Ann Watts	12'	25'	0
7	R3.1-1-126	James P. Ellis	338'	365'	3
8	R3.1-1-127	James William Durham	140'	140'	1
9	R3.1-1-128	Roy C. Young	175'	175'	1
10	R3.1-1-129	James H. Durham	60'	125'	1
11	R3.1-1-130	J. A. Whitlow Jr.	390'	400'	2
12	R3.1-1-131	George D. Mennan	205'	240'	1
13	R3.1-1-132	George R. Morgan Jr.	290'	290'	1
14	R3.1-1-133	Dennis & Diane R. Wyatt	55'	80'	0
15	R3.1-1-134	Daniel W. & Eleanor P. Clayton	201'	160'	1
16	R3.1-1-135	William R. Stevenson	165'	165'	1
17	R3.1-1-136	William R. Stevenson	120'	120'	1
18	R3.1-1-137	John W. & Jean Preszle	120'	120'	1
19	R3.1-1-138	Carlton R. & Faye S. Rozier	120'	120'	1

**SHEET 120**

Greater Greenville Tax Map  
 GREENVILLE, S.C.

TAX DISTRICT	MAP NUMBER	REVISIONS
4305	B3.1	

SCALE 1" = 100'

Berea Public Service District  
 COMMISSION