

RELEASED - 8-7-75

REVISIONS			PIEDMONT ENGINEERS & ARCHITECTS
NO.	DATE	BY	
1	8-24-76	BD	ADD LINE TO LOT 11 - UPPER END.

BLOCK BOOK NO.
B-1-1-11

NAME
STANLEY BROWN

LENGTH OF SEWER
THRU PROP 595'

LENGTH OF R/W
THRU PROP 650'

M.H. 3

FILED
GREENVILLE CO. S. C.

AUG 25 10 52 AM '76

EDWARD TANKERSLEY
L.L.C.

B-14

AUG 25 1976

⊕ B-1-1-11

STANLEY BROWN


55'

70'

0

⊕ ADD ON 8/24/76

CONSTRUCTION R/W

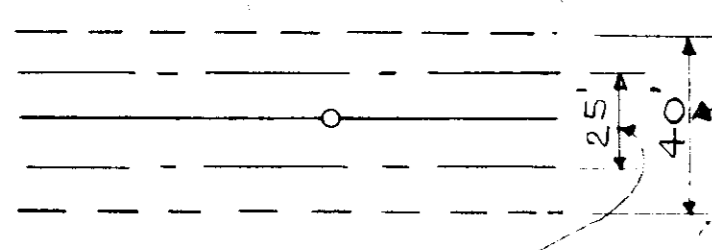


PERMANANT R/W

LEGEND

B-2

41-195

B-2

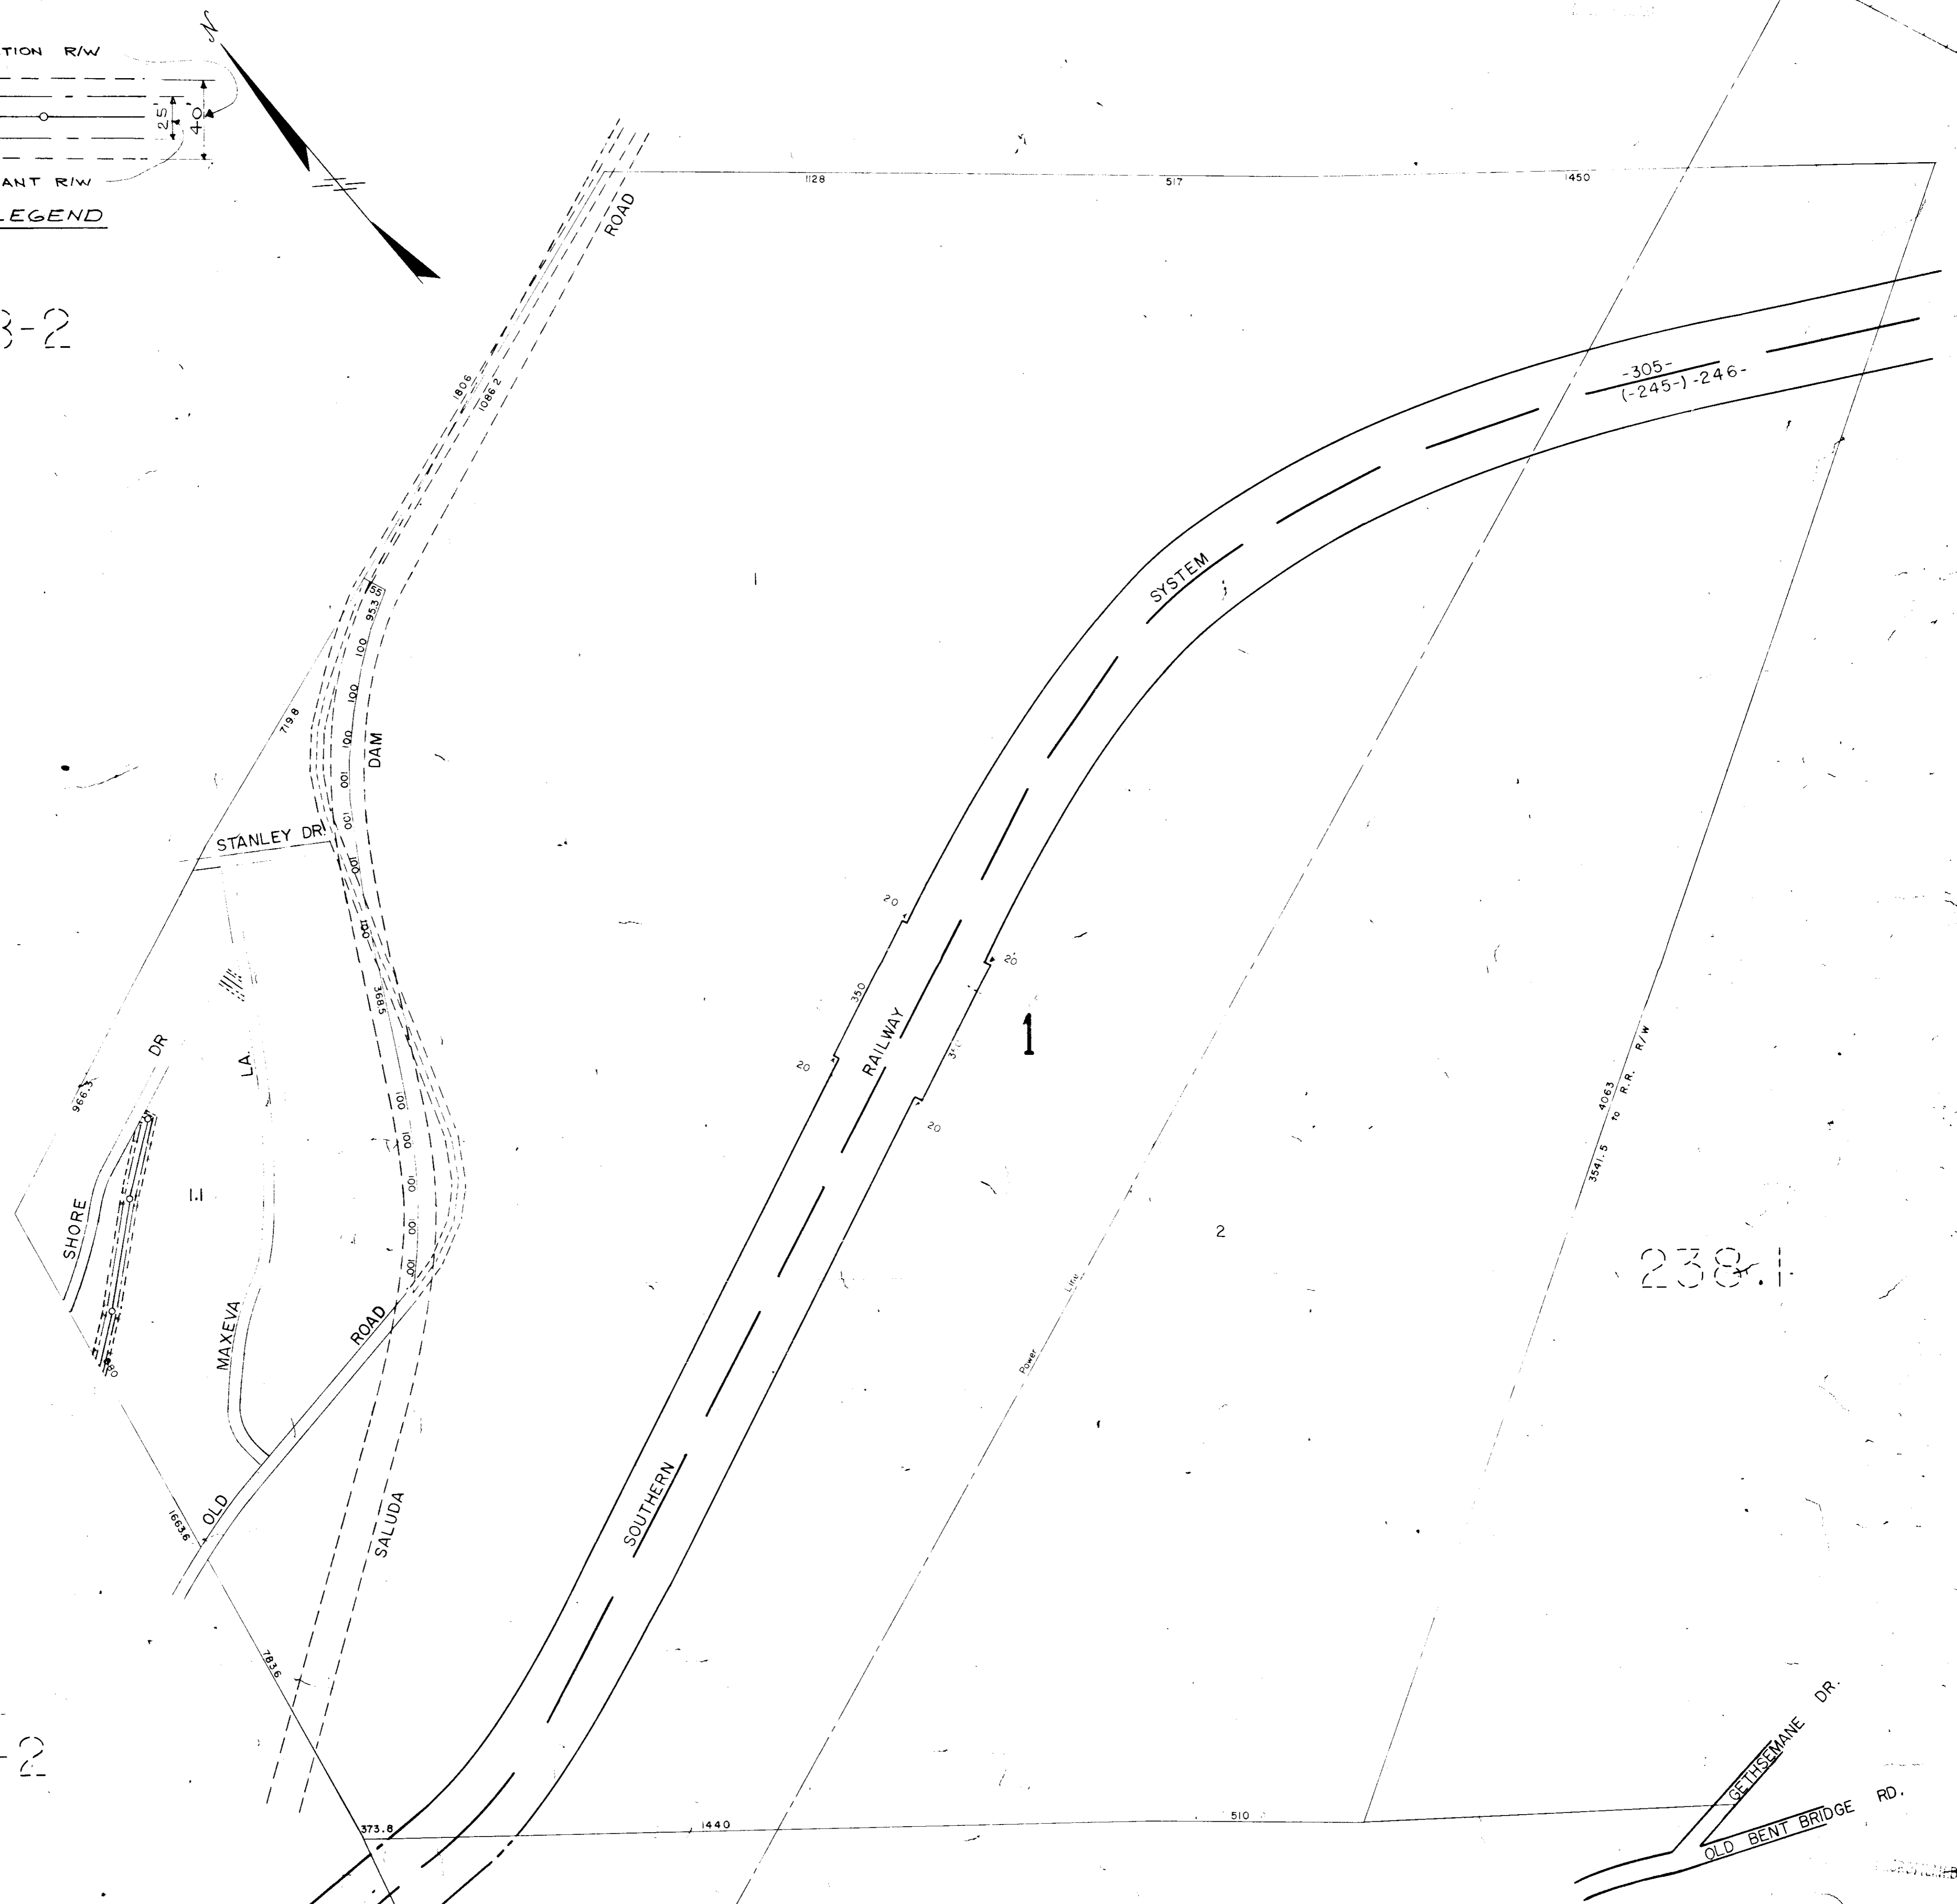

238.2

Berea Public Service
District Commission

SHEET-2-R

Filed This 25th day of August 1976
 And Recorded in Vol. 44 Page 196 at 10:52 AM
 Bonnie S Tankersley
 Register Messs Conveyance Greenville County, S. C.

BOOK 4 V PAGE 196
5362

GREENVILLE COUNTY TAX MAPS GREENVILLE, S. C.		
TAX DIST.	MAP NUMBER	REVISIONS
246 305	B-1	
SCALE 1" = 200'		