


Block Book No.	Name	Length of Sever Thru Property	Length of R/W Thru Property	M. H.
B 4.5-1-3	C. J. Bowen	0	370'	0
B 4.5-1-3.2	Hubert & Margaret Grover	535'	550'	2
B 4.5-1-6	Willie W. Rumm	0	380'	0

ADD ON 1-11-77

B 4.5-1-5	C. J. BOWEN	164'	164'	0-0
B 4.5-1-3.2	HUBERT & MARGARET GROVER	0	60'	0

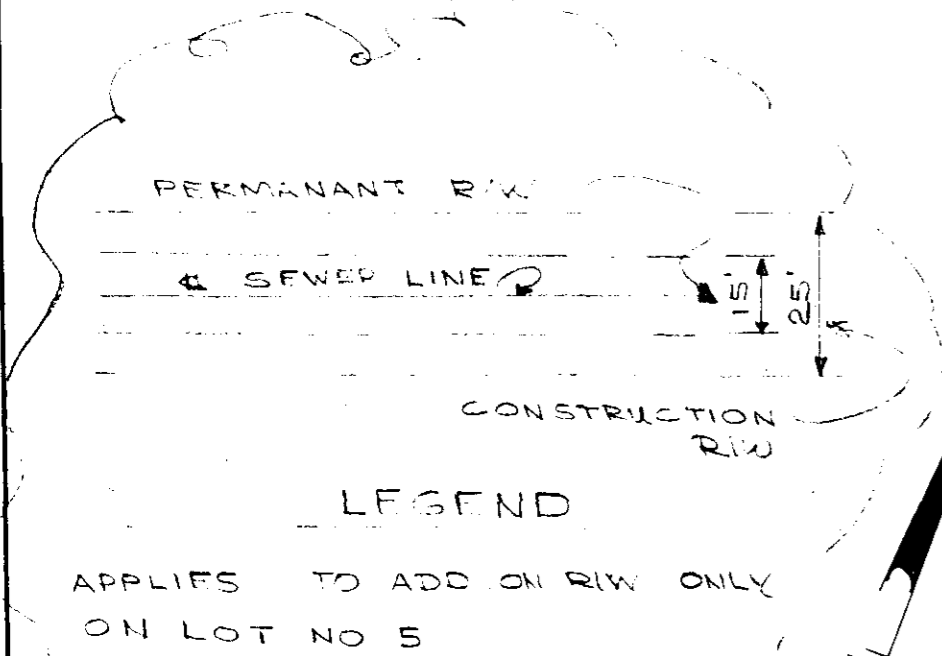


B-4.4

B-4.3

B-15

B-13

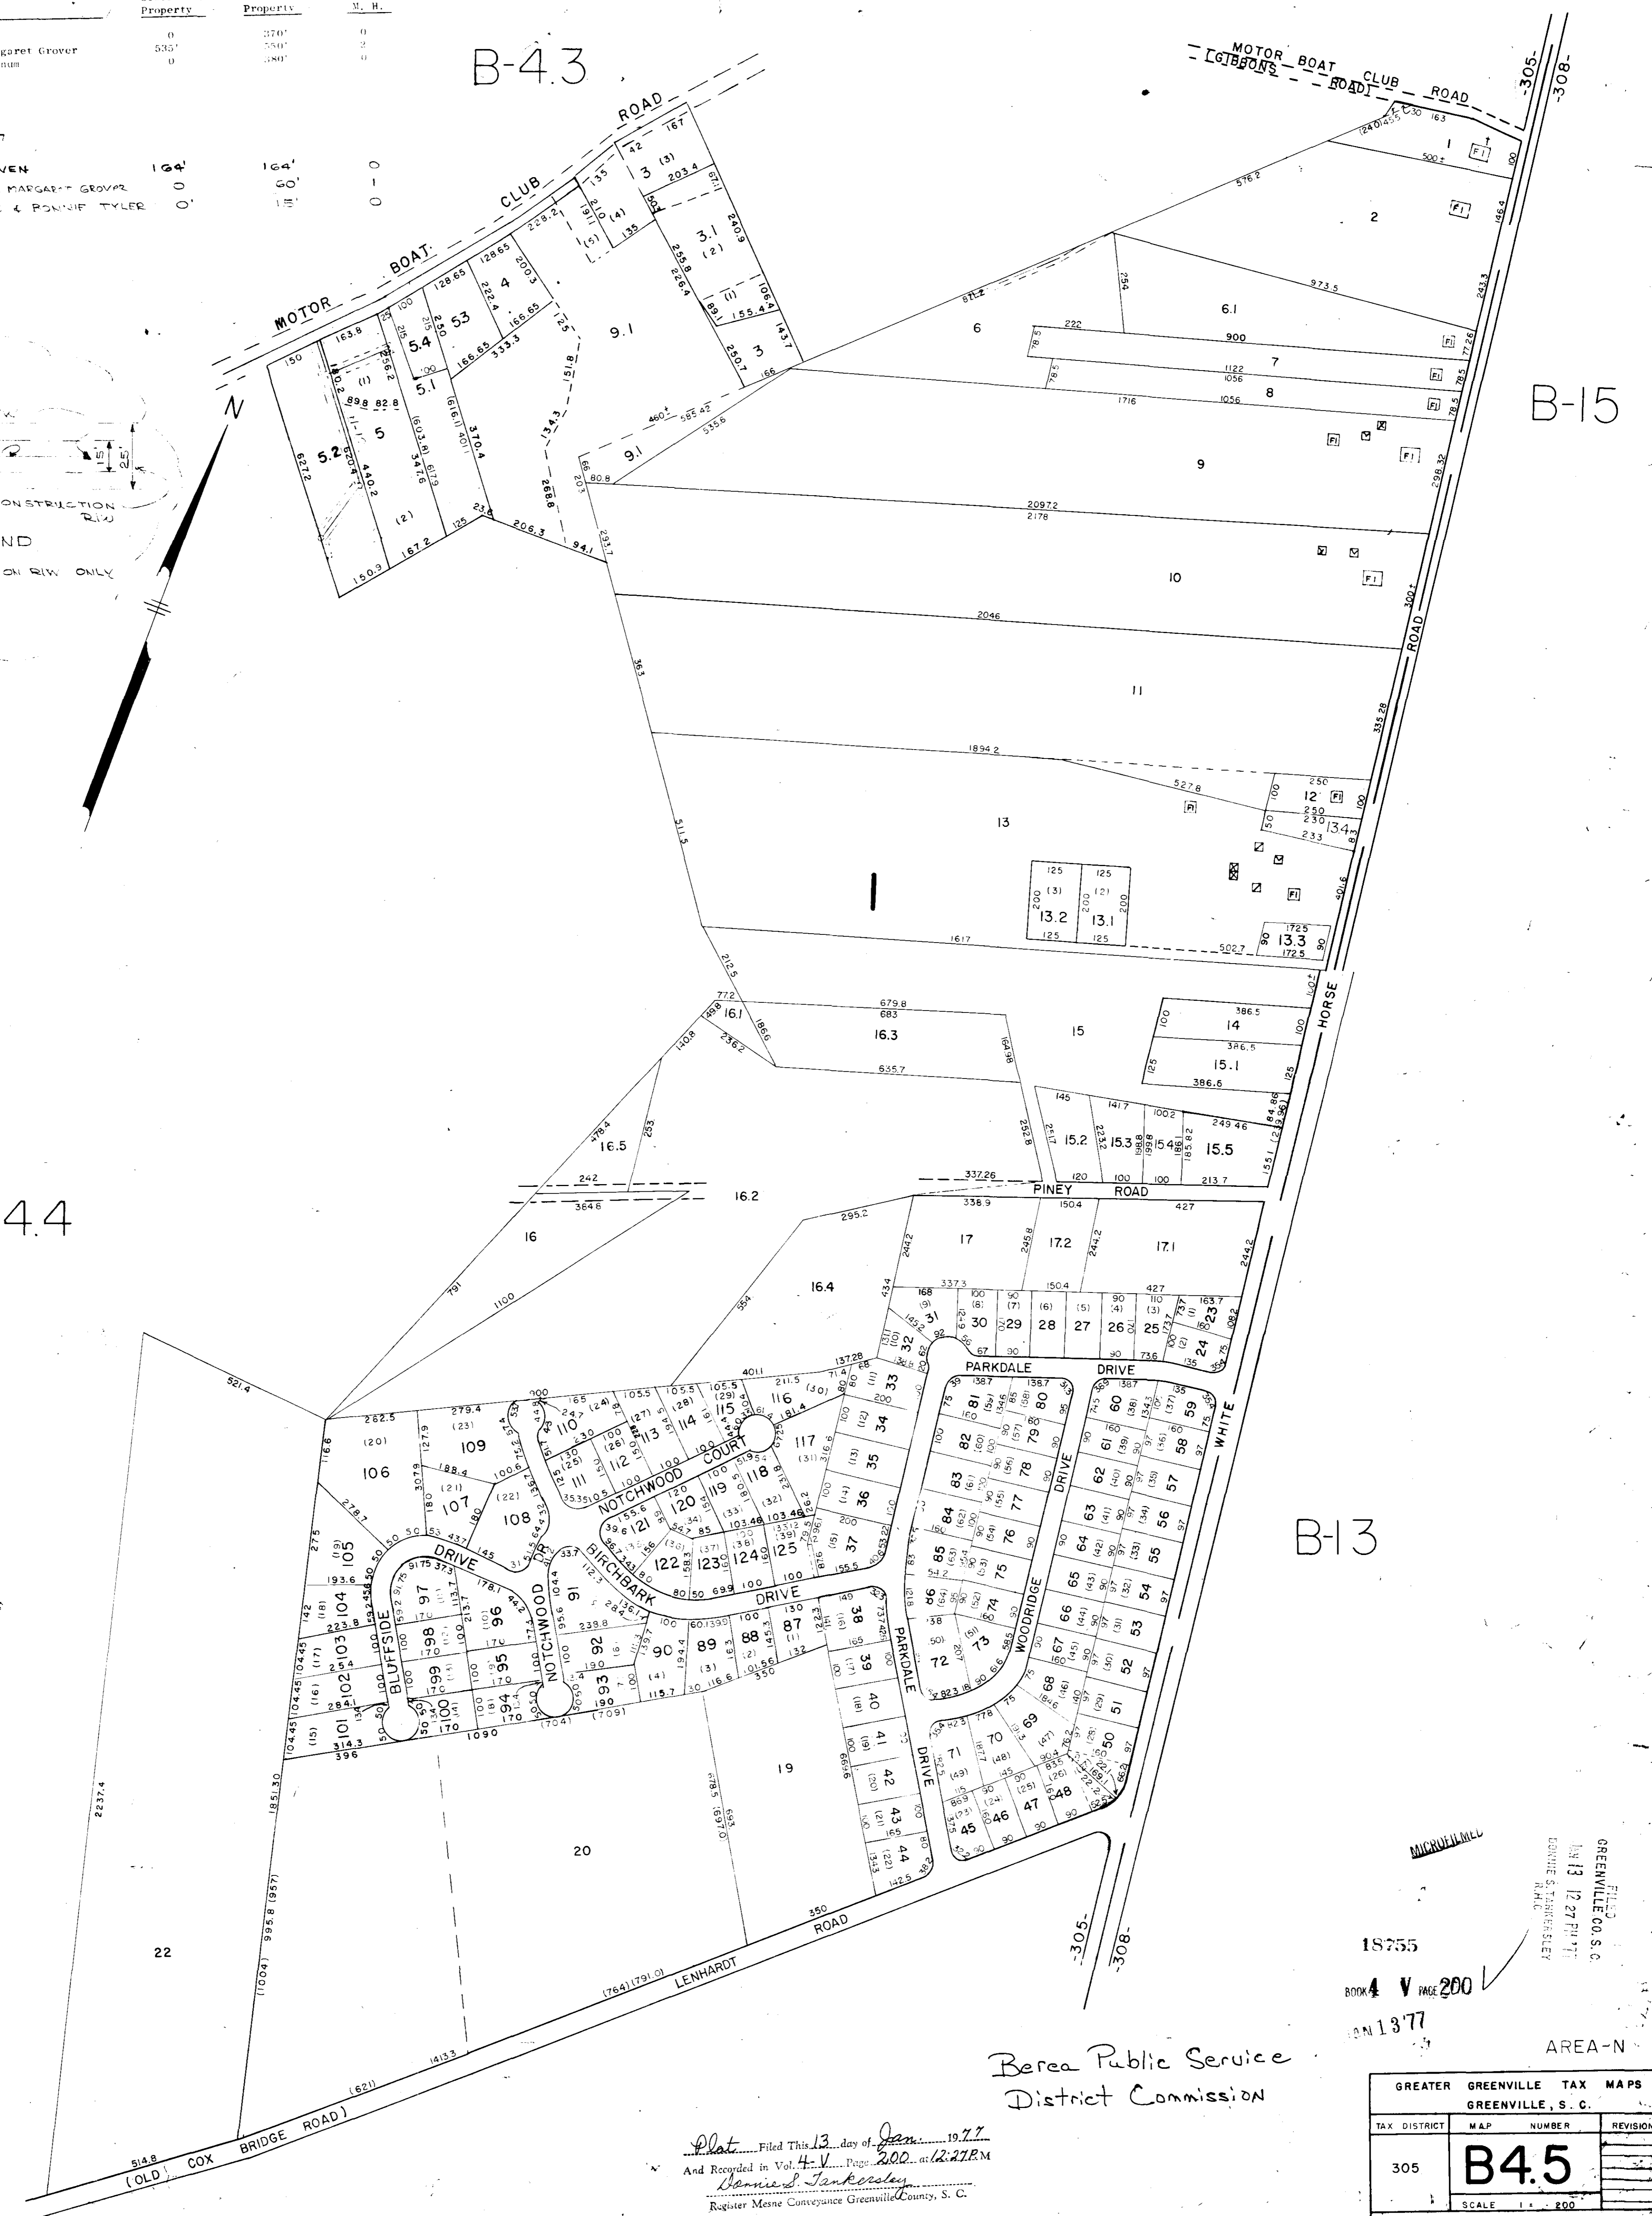

Berea Public Service
District Commission

Plat Filed This 13 day of Jan 1977
And Recorded in Vol. 4-V Page 200 at 12:27 P.M.
Dennis Tankersley
Register Mesne Conveyance Greenville County, S. C.

18755
BOOK 4 V PAGE 200
JAN 13 1977
AREA-N

GREATER GREENVILLE TAX MAPS GREENVILLE, S. C.			
TAX DISTRICT	MAP NUMBER	REVISIONS	
305	B4.5		

GREENVILLE CO. S. C.
JAN 13 12 27 PM '77
DENNIS TANKERSLEY
REGISTER