



FILED
GREENVILLE CO. S. C.
MAY 25 1977
BLAINE STAMMERLEY
PLUMBER

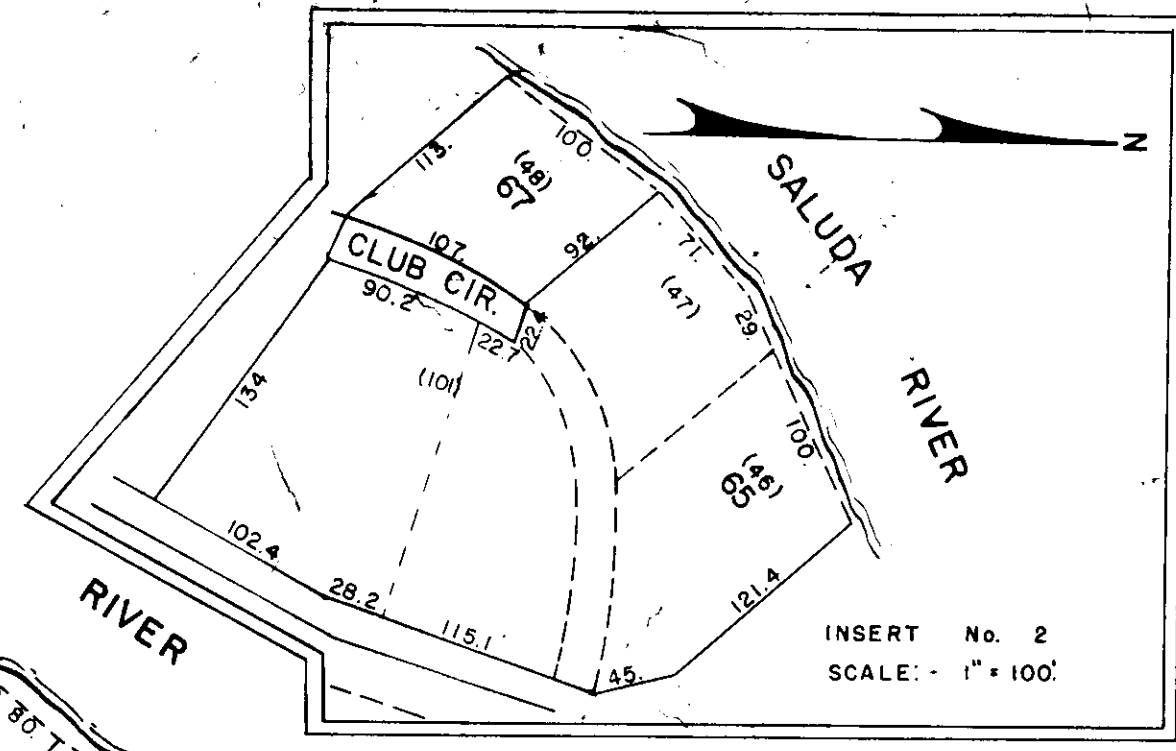

No.	Name	Length of Sewer thru Property	Length of R/W thru Property	Manhole
B 4.4-1-16	E. D. Robinson Est.	0'	100'	0
B 4.4-1-16.5	Walter L. & Mary Lee Williams	100'	100'	0
B 4.4-1-17	Mildred E. Whitmire Life Est. & Beverly W. Zimmerman	85'	115'	1
B 4.4-1-18	Mildred E. Whitmire Life Est. & Beverly W. Zimmerman	150'	155'	0
B 4.4-1-21	Claude F. Cato, Jr.	145'	150'	1
B 4.4-1-22	Claude F. Cato, Jr.	85'	110'	0
B 4.4-1-23	George Sijon	325'	375'	1
B 4.4-1-34	B. F. Bull	0'	25'	0
B 4.4-1-43	Mattie B. Ouzts	45'	80'	1
B 4.4-1-45	Mattie B. Ouzts	190'	195'	0
B 4.4-1-46	Mattie B. Ouzts	0'	40'	0
B 4.4-1-47	Charlotte R. Kay	90'	100'	1
B 4.4-1-48	Patrick L. & Carolyn H. Whitworth	112'	112'	0
B 4.4-1-49	William A. Moody	75'	75'	0
B 4.4-1-50	Alpha B. & C. Houston Childress	140'	160'	1
B 4.4-1-51	Thomas H. Penny	200'	220'	2
B 4.4-1-63	Mildred E. Whitmire Life Est. Etal	10'	20'	0

ADD ON- 11-13-75
ADD ON II-23-76
B.4.4-1-84 J.B. ELLENBURG

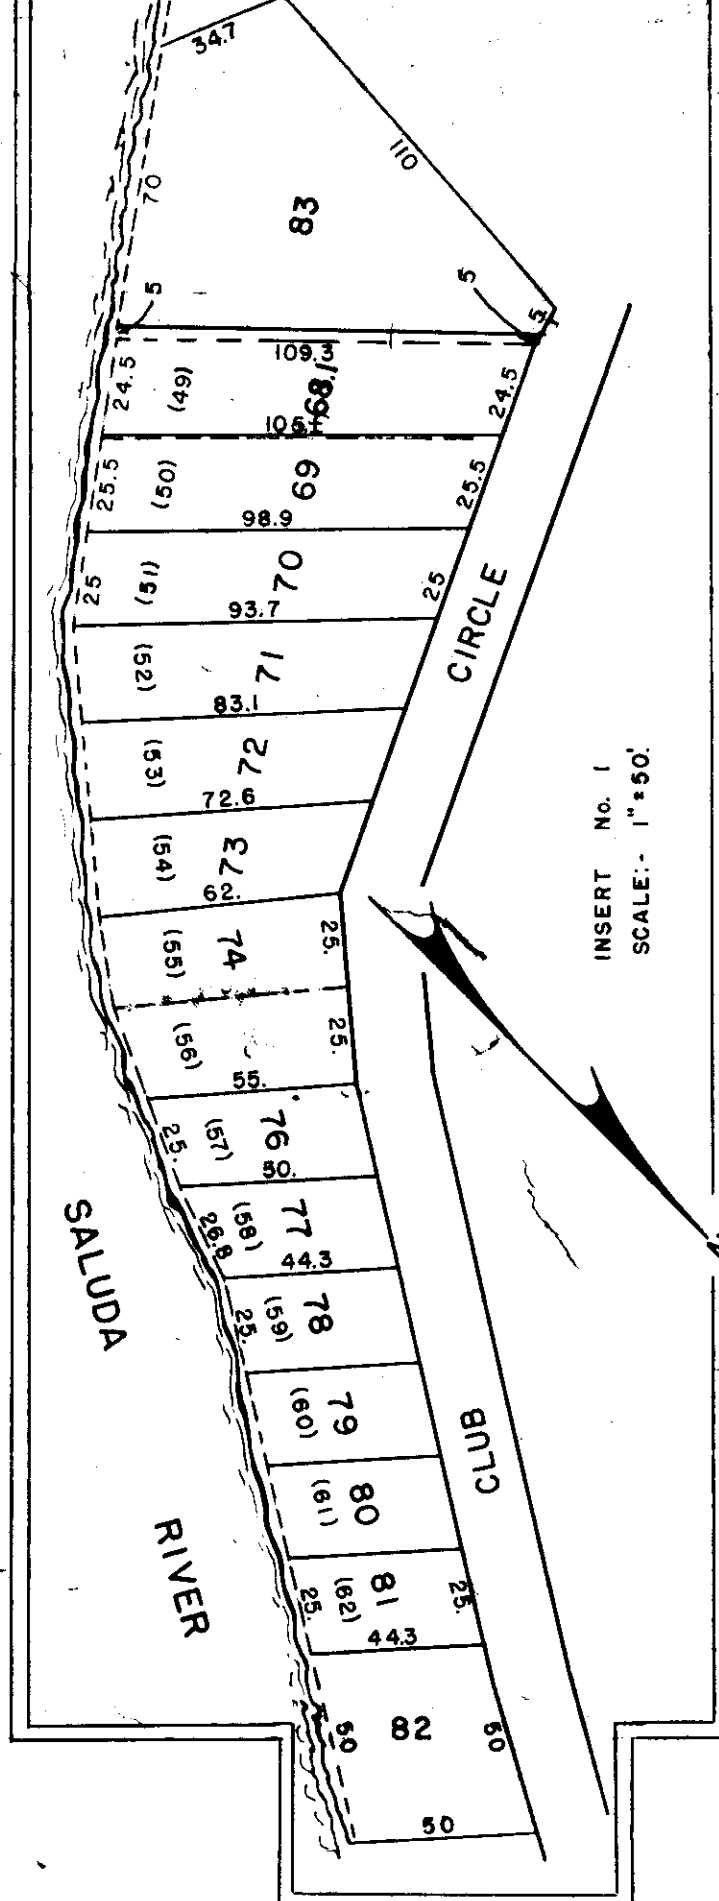

Block Book No.	Name	Length of Sewer thru Property	Length of R/W thru Property
B 4.4-1-8	Mattie Dial Free	160'	180'
B 4.4-1-81	Frances S. Miller	250'	270'
B 4.4-1-84	G. P. Lacroix	120'	131'
B 4.4-1-86	J. B. Ellenburg	0'	40'
B 4.4-1-87	Arthur Delans	0'	40'
B 4.4-1-61	C. J. Bull	60'	70'
B 4.4-1-10	George M. & Priscille Fairbright	90'	100'
B 4.4-1-9	Frances S. Daniels	0'	20'
B 4.4-1-50	Alpha B. & C. H. Childress	0'	196'
B 4.4-1-16.2	Jimmie & Rosa Ann Kirksey	0'	167'
B 4.4-1-16.3	Wilhelmina Franklin	0'	181'
B 4.4-1-16.4	Samuel & Beag Kirksey	0'	140'
B 4.4-1-16.6	Charles A. Haywood	290'	299'
B 4.4-1-16.7	Clyde C. & Jeanie L. Franklin	0'	750'

Berea Public Service
District Commission
36205

GREATER GREENVILLE TAX MAPS
GREENVILLE, S. C.

TAX DISTRICT	MAP NUMBER	REVISION
303	B4.4	
SCALE: 1" = 200'		

JUN 29 1977

REVISED 11/11/76
-1742100

LINE SHORTENED ON 12-1-75 AT REQUEST OF OWNER