



WG 1.2


WG 1.4

WG 1.1

WG 4

WG 2.1

WG 3

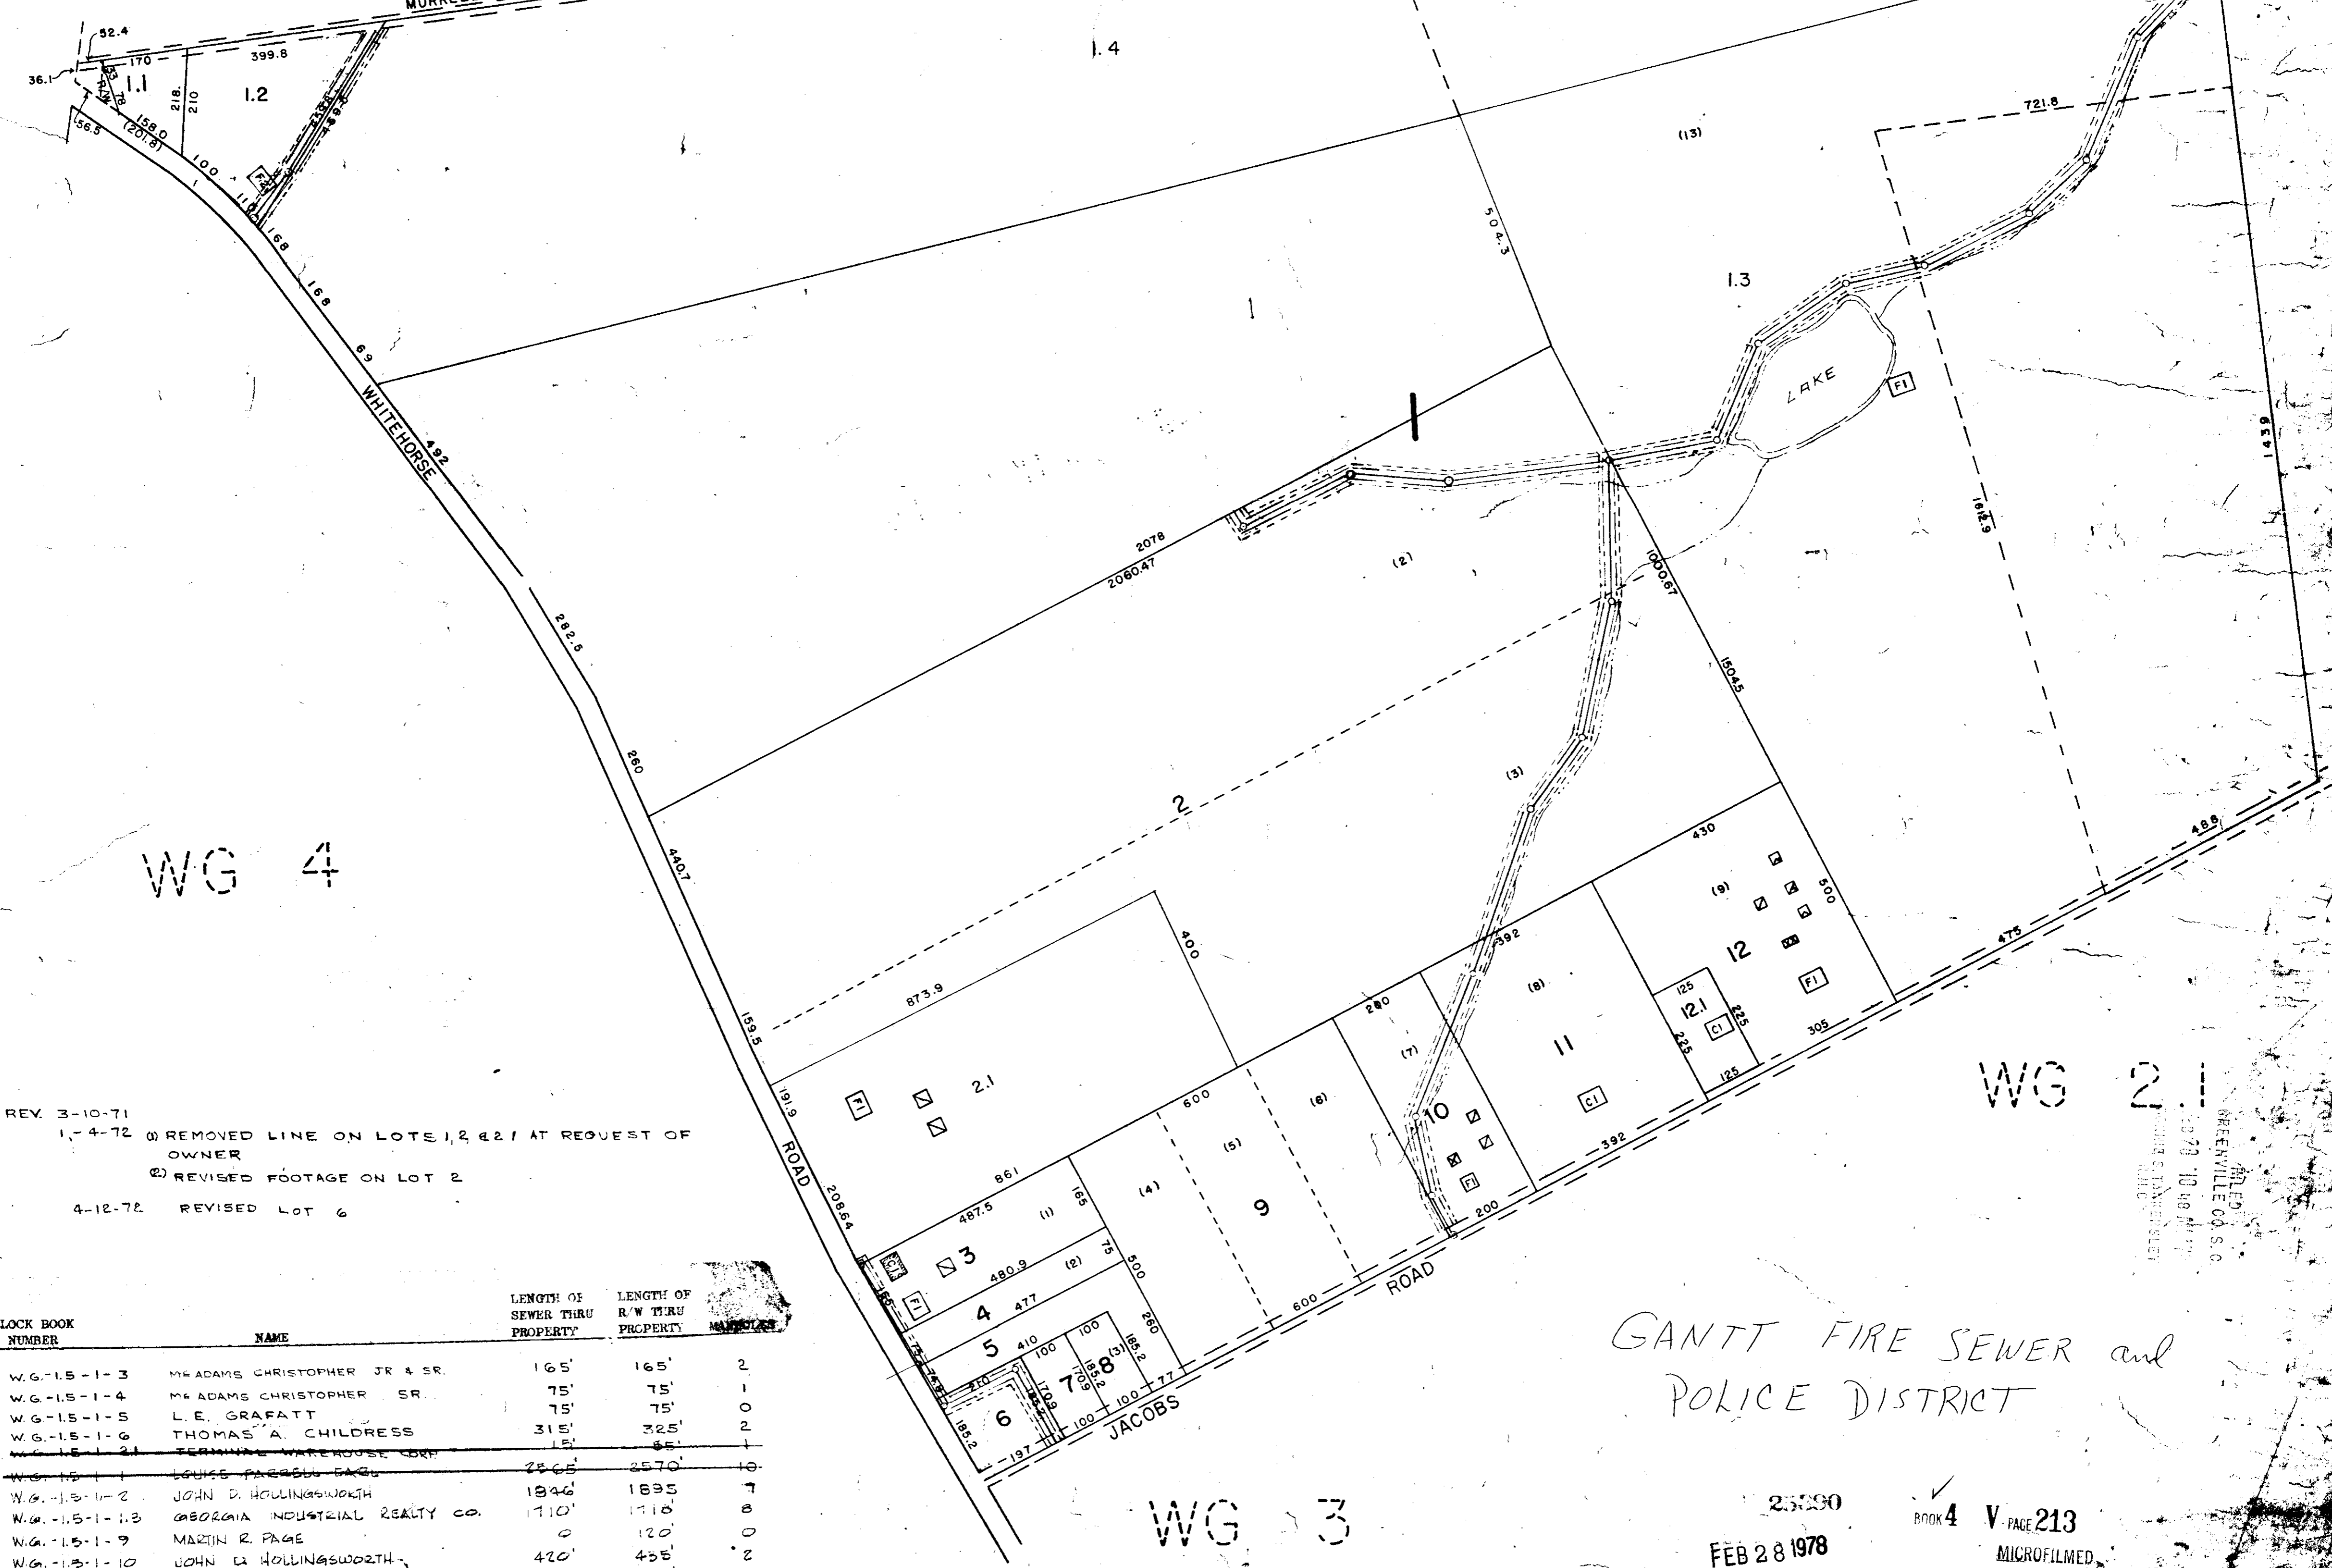

REV. 3-10-71
 1-4-72 (1) REMOVED LINE ON LOTS 1, 2 & 2.1 AT REQUEST OF OWNER
 (2) REVISED FOOTAGE ON LOT 2
 4-12-72 REVISED LOT 6

BLOCK NUMBER	NAME	LENGTH OF SEWER THRU PROPERTY	LENGTH OF R/W THRU PROPERTY	FEET
WG-15-1-3	MR ADAMS CHRISTOPHER JR & SR	165'	165'	2
WG-15-1-4	MR ADAMS CHRISTOPHER SR	75'	75'	1
WG-15-1-5	L. E. GRAFATT	75'	75'	0
WG-15-1-6	THOMAS A. CHILDRESS	315'	325'	2
WG-15-1-13	JOHN D. HOLLINGSWORTH	200'	240'	1
WG-15-1-14	W.M. MORGAN ETAL.	460'	460'	2
WG-15-1-15	MONTGOMERY LOCATION # 2	0	460'	0

GANTT FIRE SEWER and POLICE DISTRICT

25000
 FEB 28 1978
 BOOK 4 V PAGE 213
 MICROFILMED

GREENVILLE CO. S.C.
 GREENVILLE
 WG-15

ADD 5-6-72
 RE-RELEASE 1-6-78 REVISED LINE ON LOTS 1, 2 & 2.1
 11 2-16-78