

509.3

509.3

508.1

B5.3


B4.1

B4.2

BLOCK BOOK NO.	NAME	LENGTH OF SEWER THRU PROP.	LENGTH OF R/W THRU PROP.
B5.4-1-1	FRANCIS H. MCKEE	615'	625'
B5.4-1-11	H. DRESSA GUINN	20'	25'
B5.4-1-13	W.H. & MILDRED H. FARR	735'	760'
B5.4-1-14	W.H. & MILDRED H. FARR	220'	320'
B5.4-1-14.2	CARL & ESTHER STIFFLER	340'	380'
B5.4-1-15	HASKELL M. JONES	80'	80'
B5.4-1-4.2	LOYD W. GILSTRAP	140'	150'

ADD ON 5-23-78

B5.4-1-11	H. DRESSA GUINN	549'	575'
B5.4-1-11.3	ROBERT H. GALLOWAY	12'	25'
B5.4-1-17.1	H. DRESSA GUINN	375'	380'

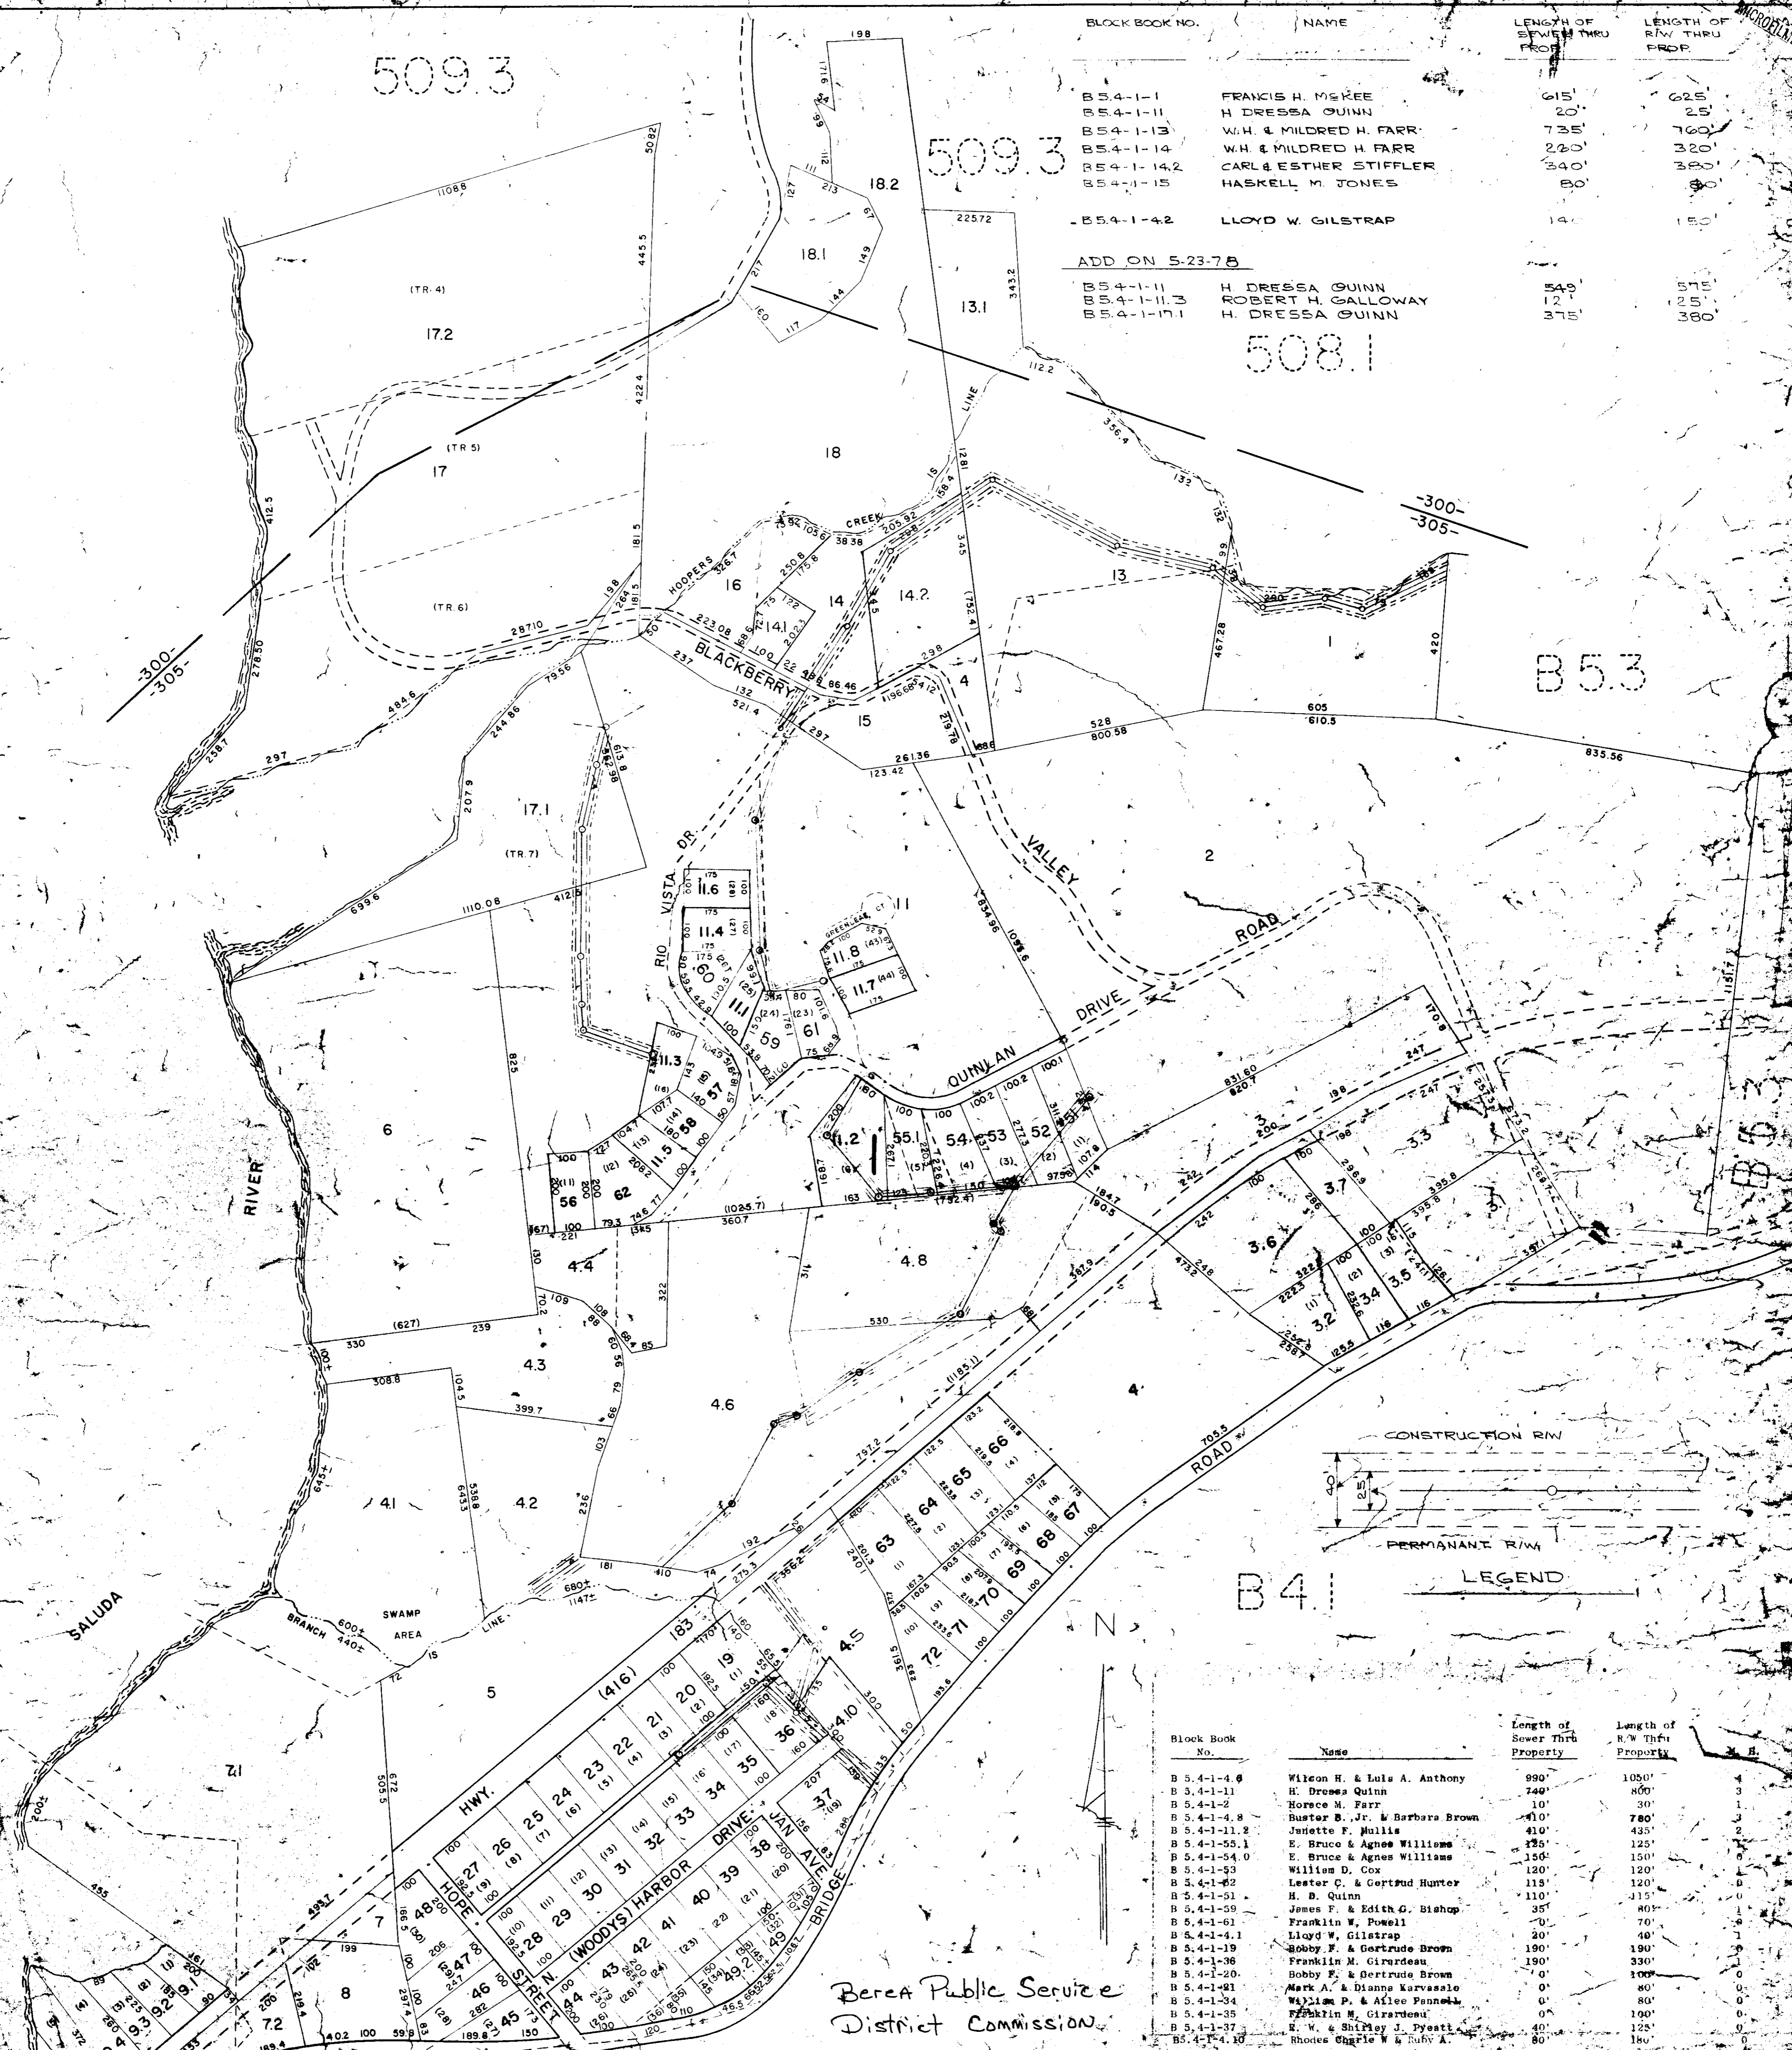

Block Book No.	Name	Length of Sewer Thru Property	Length of R/W Thru Property	Ac.	Sq. Ft.

Berea Public Service District Commission

ADD ON 5-4-1-11.1 CELIA LOUISE KERR

ADD ON 48/777 B5.4-1-4.5 GAINES B. & GRACE S. ANTHONY

ADD ON 10-19-77 B5.4-1-63 JOSEPH P. & CAROLYN R. TAYLOR

36083 BOOK 4 V PAGE 216 JUN 11 1978

Plat filed this day of June 1978 and Recorded in Vol. 300 at 10:51 AM

GREENVILLE COUNTY TAX MAPS

MAX. DIST.	MAP NUMBER	REVISIONS
300	B5.4	
305		

GREENVILLE CO. S. C. DONNIE S. HANNESELY