
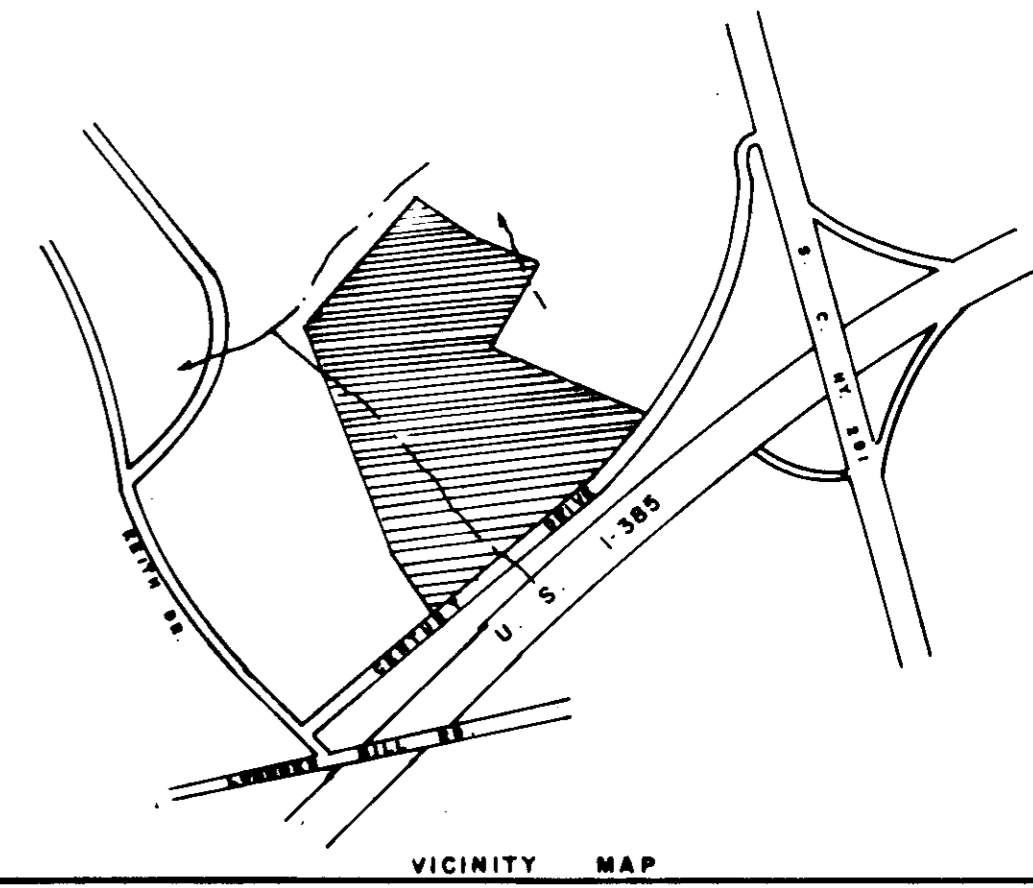


FILED  
 GREENVILLE CO. S. C.  
 MAY 23 1973  
 EDWIN S. TAYLOR  
 R.M.C.

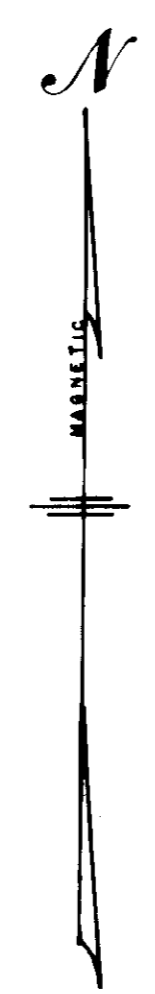

I HEREBY CERTIFY THAT THIS IS AN ACCURATE MAP OF AN ACTUAL SURVEY COMPLETED BY ME ON MAY 23, 1973.

C. O. Riddle  
 REG. S. C. LAND SURVEYOR NO. 1347

I HEREBY CERTIFY THAT I AM THE OWNER OF PROPERTY SHOWN ON THIS PLAT AND DO APPROVE OF THE SUBDIVISION THEREOF AS SHOWN.

L-385, INC. BY Wm. Boyd Dexter Secretary  
606 E. NORTH ST.

I HEREBY CERTIFY THAT MONUMENTATION OF THIS SUBDIVISION IN COMPLIANCE WITH THE CITY OF GREENVILLE, SOUTH CAROLINA SUBDIVISION REGULATIONS WAS COMPLETED BY ME ON MAY 23, 1973.

C. O. Riddle  
 REG. S. C. LAND SURVEYOR NO. 1347

THE UNDERSIGNED BEING THE OWNER OF THE PROPERTY SHOWN HEREON DO(ES) APPROVE THIS PLAN OF SUBDIVISION AND HEREBY DEDICATES TO PUBLIC USE THE ROADS, STREETS, EASEMENTS OR OTHER PUBLIC AREAS SHOWN HEREON.

L-385, INC. BY Wm. Boyd Dexter Secretary  
606 E. NORTH ST.  
MAY 28, 1973

**FINAL PLAN APPROVED**  
 GREENVILLE CITY PLANNING & ZONING COMMISSION  
 DATE 11-19-73 BY J. Obasay Thomas  
 SECRETARY OF COMMISSION

73 - 161

FINAL PLAT  
**CENTURY PLAZA**

L-385, INC. OWNER      C. O. RIDDLE SURVEYOR

NO. OF ACRES	<u>28.2</u>	MILES OF NEW ROADS	<u>0.38</u>
NO. OF LOTS	<u>3</u>	DATE	<u>MAY 25, 1973</u> <u>11/16/73</u>

SCALE 1" = 100'

5D-13

\*13504

**REVISED**

11-19-73  
 DATE  
 Drainage easement  
 Revised only.

NOTE: DRAINAGE AND UTILITIES EASEMENT 5' EACH SIDE OF ALL SIDE AND REAR LOT LINES.  
 REVISED 7/11/73  
 CHECKED AND REVISED TO SHOW DRAINAGE EASEMENT TO BE CONSTRUCTED AS SHOWN ON SHEET D-4 OF PLANS FOR APARTMENT DEVELOPMENT FOR FUTURE DEVELOPMENT BY J. L. ROGERS ENGINEERING CO., INC.

413504 Filed 11-19-73 and 11-19-73  
5D 13 0:53 AM  
Edwin S. Taylor