


FILED
GREENVILLE CO. S. C.
MAY 30 3 25 PM '75
DORRIS S. TANKERSLEY
R.L.C.

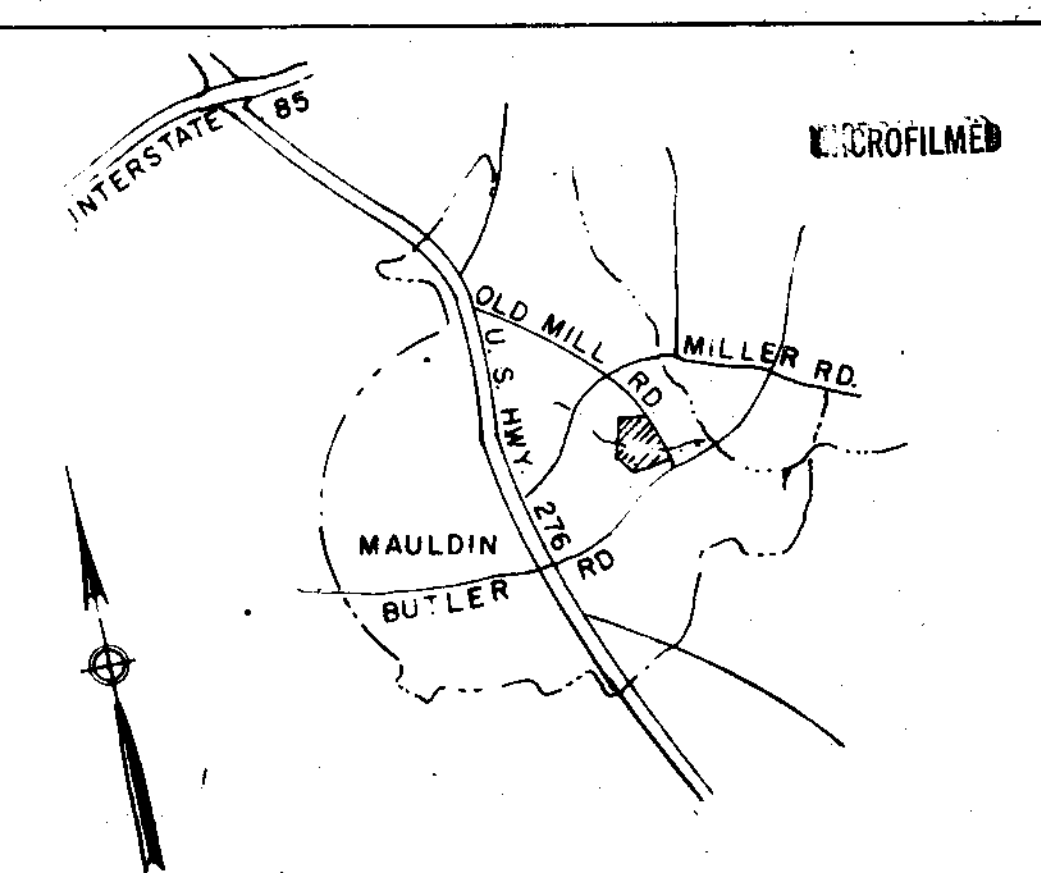

LOCATION MAP

FINAL PLAT

CERTIFICATE OF OWNERSHIP AND DEDICATION

"The undersigned hereby acknowledge that I am (we are) the owner(s) of the property shown and described hereon and that I (we) hereby adopt this plan of subdivision with my (our) free consent and that I (we) establish the minimum building restriction limits, and hereby dedicate to public use as roads, streets, and easements, for all areas so shown or indicated on said plat.

12 / 10 / 73 _____ Signed W. M. Burdett
 _____ Signed _____
 _____ Signed _____
 _____ Signed _____

CERTIFICATE OF ACCURACY

"I certify that this plat was (drawn by me) (drawn under my supervision) (an actual survey made under my supervision) from an actual survey made by me (done) (description recorded in Book _____ Page _____ Book _____ etc.) (other); that the error of closure as calculated by latitudes and departures is _____ that the boundaries not surveyed are shown as broken lines plotted from information found in Book _____ Page _____ that this plat was prepared in accordance with the Greenville County Subdivision Regulations as adopted.

12-10-73 _____ DATE
 _____ LICENSED ENGINEER OR REGISTERED SURVEYOR
 S. C. Registration No. 918

CERTIFICATE OF APPROVAL FOR RECORDING

"I hereby certify that the subdivision plat shown hereon has been found to comply with the Subdivision Regulations for Greenville County, with the exception of such violations, if any, as are noted in the minutes of the Greenville County Planning Commission of Greenville County, South Carolina, and that it has been approved for recording in the office of the County Register of Mars C. Tankersley.

12-10-73 _____ DATE
 _____ DIRECTOR OF PLANNING
 GREENVILLE COUNTY PLANNING COMMISSION

Plat Filed This 30th day of May 1975
 And Recorded in Vol. 50 Page 71 at 2:25 PM
 DORRIS S. TANKERSLEY
 Register - Mars C. Tankersley Greenville County, S. C.

FILE NUMBER
 71-119


BURDETT ESTATES

W. M. BURDETT, ETAL OWNER DALTON & NEVES, CO. ENGINEERS

NO. OF ACRES 50.67 MILES OF NEW ROADS 1.06

NO. OF LOTS 102 DATE DEC., 1973

ZONED R-12

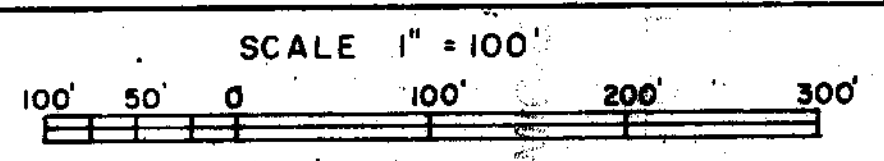

REVISED
 5/30/75
 DATE

JAMES T. MILLER IV

Revision of Lots 35, 36, 100, 101, 102, 80, 77, 78, 79, 66, & 65. Dec. 1973.

5' Drainage easement along all rear & side lot lines.

Iron pins at all corners.

RECORDING FEE
 PAID \$ 5.00

MICROFILMED