


MICROFILMED

SUNRISE DR.

WATER & SEWER IN ST. RW

MURRAY DR

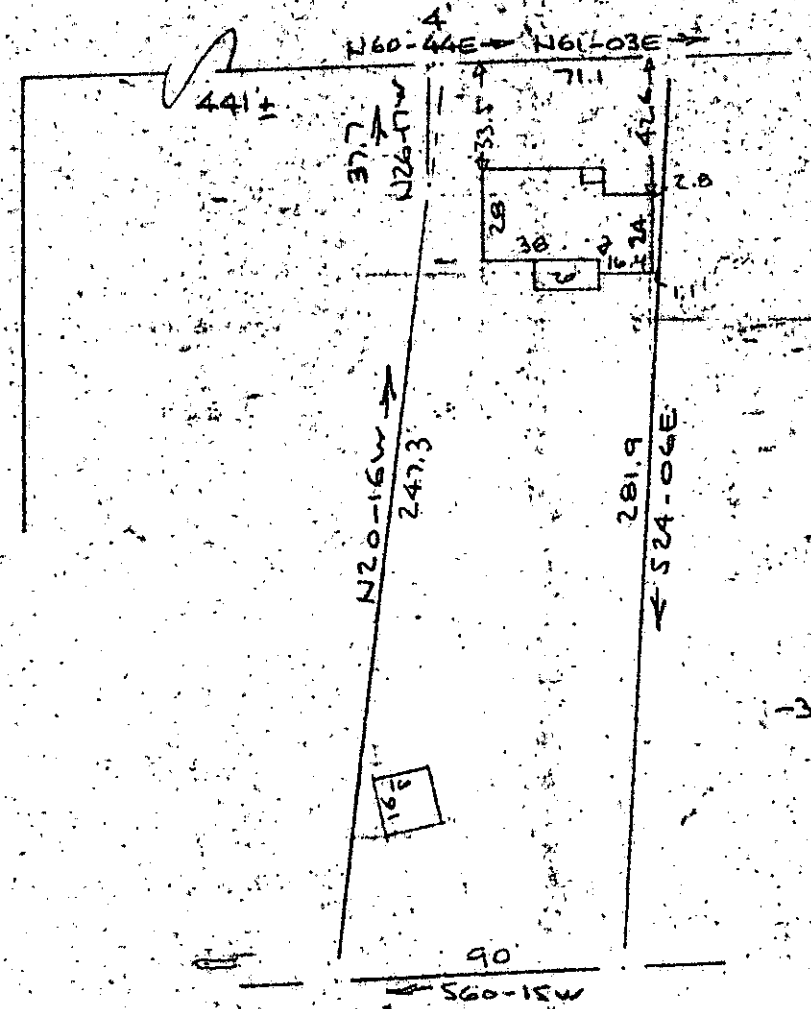

FILED
 GREENVILLE CO. S. C.
 DEC 7 1 34 PM '73
 DONNIE S. TANKERSLEY
 R. M. C.

PROPERTY OF
 RICHARD DUNAWAY
 NEAR GREENVILLE, S. C.
 SCALE 1"=60' 5 DEC 1973

This is to certify that on the 5th day of December 1973, I surveyed the property shown on this plat, being known as PROPERTY OF RICHARD DUNAWAY and recorded in the RMC Office Greenville County, S.C., in Plat Book at Page and that the property lines, walls and buildings are as shown hereon, and that the walls and buildings located on said lot do not encroach or project on adjacent street or property, and that no adjacent walls or buildings encroach or project on said premises, and no power lines cross this property except as shown hereon.

R. B. Bruce
 R. B. Bruce, RLS #1952

DEC 7 1973
 5. E. 6. R. M. C.

CAROLINA SURVEYING CO.
 112 Manly St.
 Greenville, S. C. 14927

RECORDING FEE
 PAID \$ 1.00