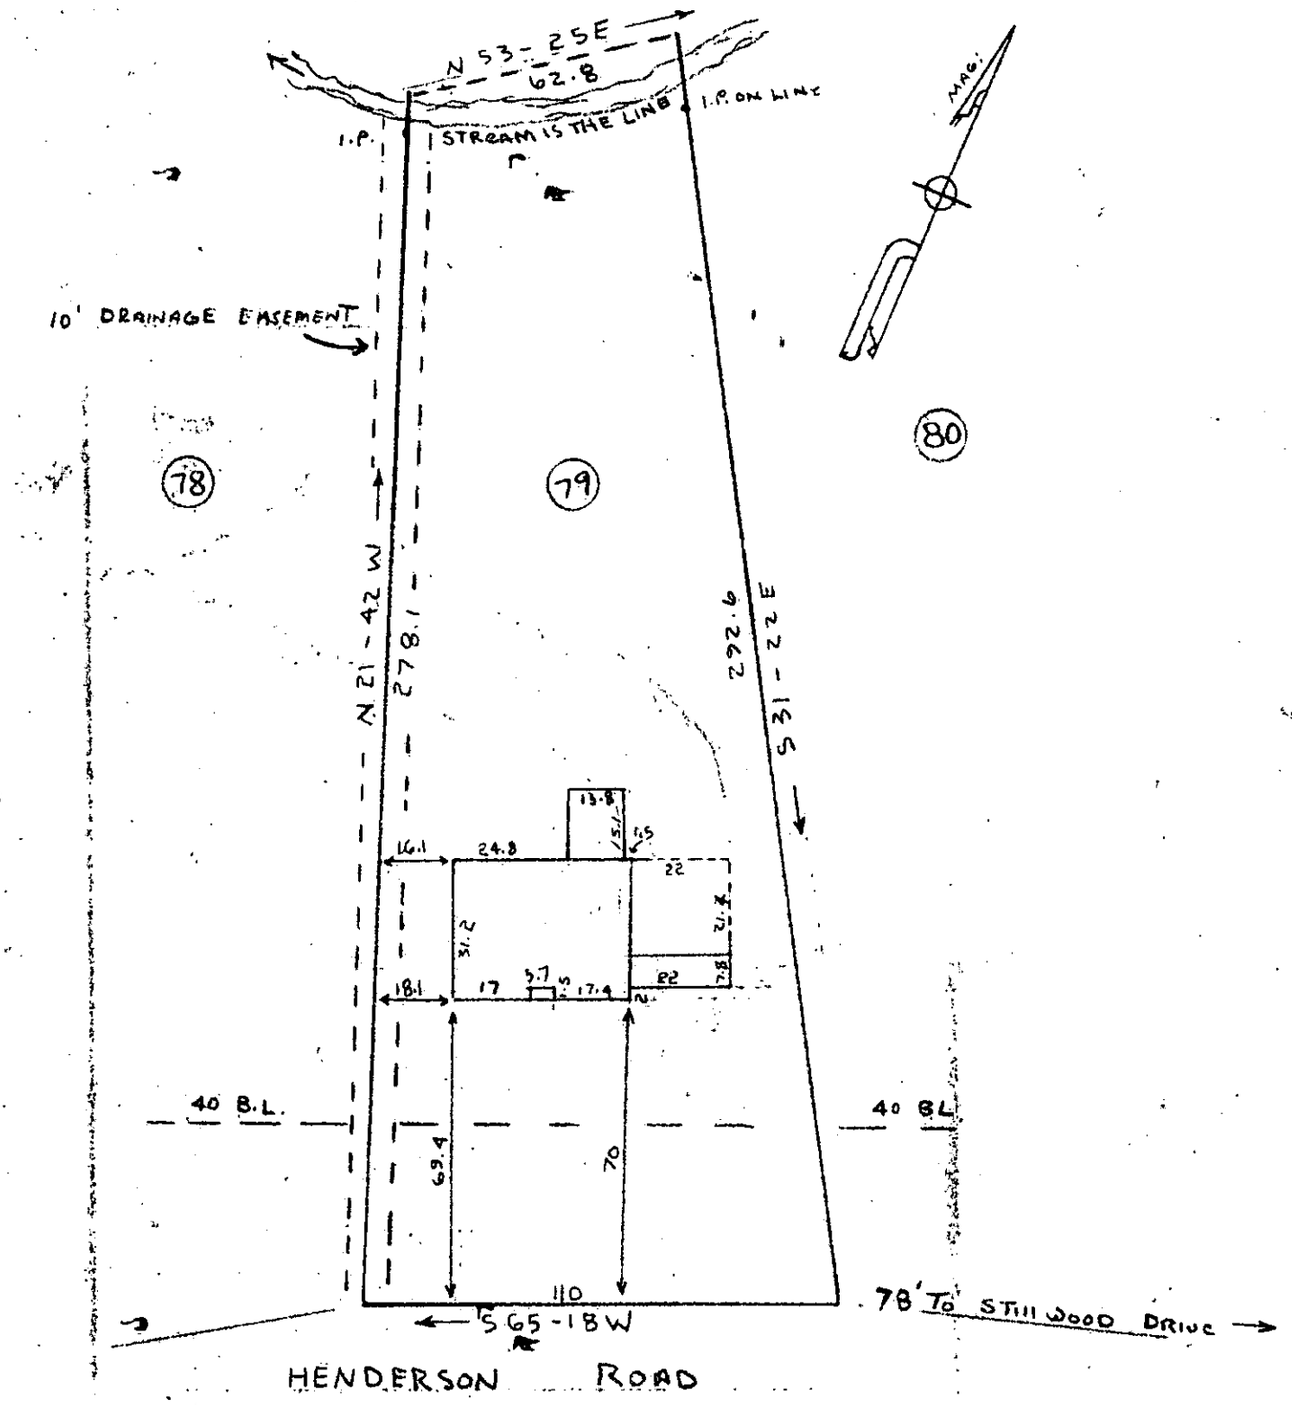

I hereby certify that on Dec. 18, 1973 I surveyed lot 79 according to a plat of Gower estate Section "F" dated Nov. 1965 and recorded in plat book "JJJ" on page 99 in the R.M.C. Office Of Greenville County; and that the property lines, buildings, and walls are as shown hereon, that no walls or buildings encroach on adjacent streets or property, and no buildings or walls encroach or project on these premises.

16596

Charles F. Webb R.L.S.

CHARLES F. WEBB
REGISTERED
1577
LAND SURVEYOR
SOUTH CAROLINA

PROPERTY OF

JOE F. LASSITER
AND
CLARE C. LASSITER

IN THE CITY OF GREENVILLE

GREENVILLE COUNTY S.C.

WEBB SURVEYING & MAPPING CO.

GREENVILLE S.C.

SCALE 1" = 40 DATE: DEC 1973

DONNIE S. TANKERSLEY
R.M.C.
DEC 31 9 53 AM '73
GREENVILLE CO. S.C.
RECORDING FEE
PAID $ 10.00

5E-26

BLT. BK. REF: 268.2-4-14

MICROFILMED