
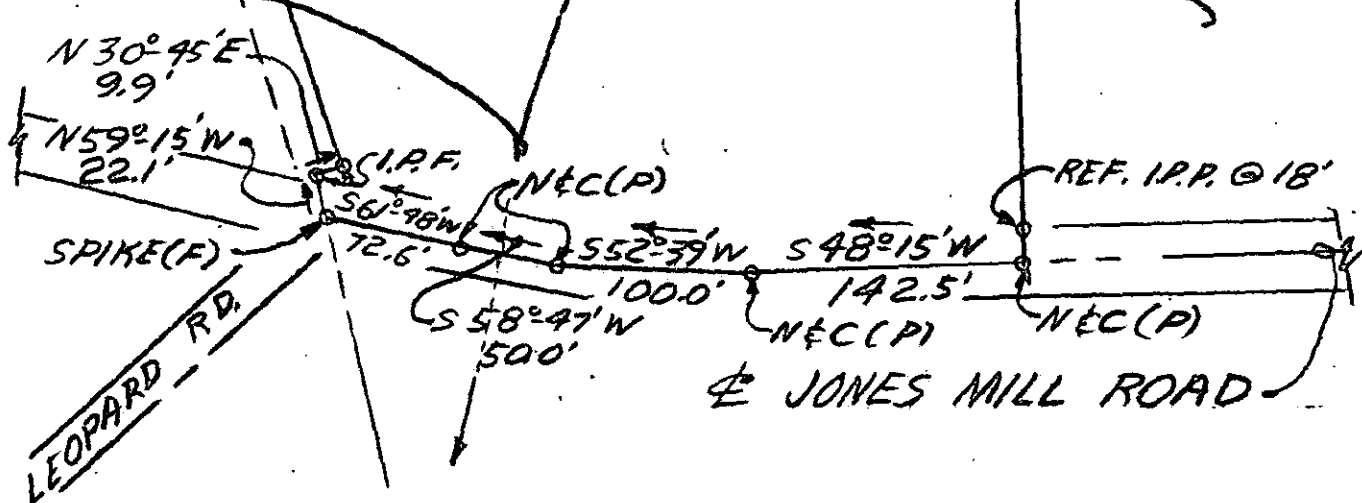


6.00 ACRES

36' RD R/W = APPROX. 0.13 ACRES

FILED
 GREENVILLE CO. S. C.
 JAN 9 11 21 AM '74
 DONNIE S. TANKERSLEY
 R.M.C.

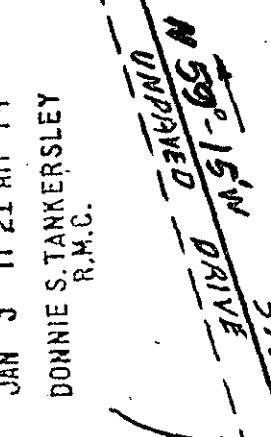

J. N. & B.A. BUERER



SEAL

STATE OF SOUTH CAROLINA
 GREENVILLE COUNTY

PROPERTY OF

J. A. GOODWIN

RECORDING FEE
 PAID \$ 1.00

5E-49
 JAN 9 1974

17318

FREELAND & ASSOCIATES
 Greenville, South Carolina
 SURVEY J. R.F.
 DR. J. R.F.
 CH. James R. Freeland
 SCALE 1" = 100'
 DATE JUNE 12, 1973
 DWG NO. 73-16A