


MICKS

RECORDING FEE
PAID \$ 1.00

LAKE DR.

SKYLAND DR.

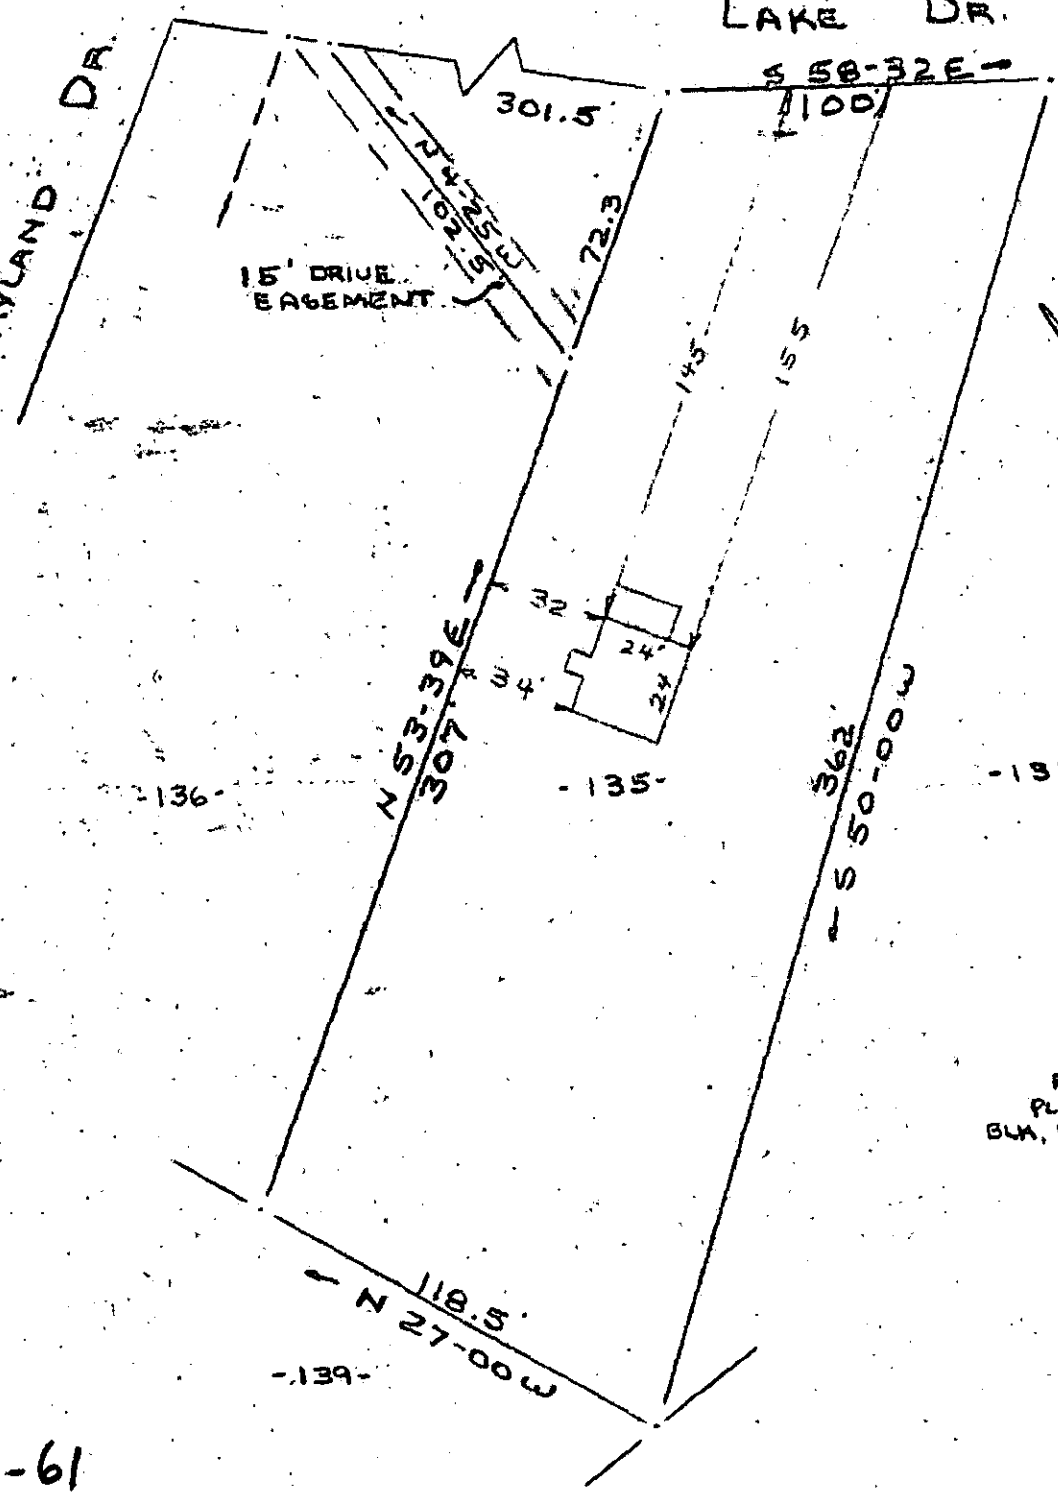

DEED:
 WONDERLAND
 PATENT - SUB-DIV.
 PLAT BK. - BB @ 29
 BK. BK. - 669.1 - 1-68

JAN 22 12 07 PM '74
 DONNIE S. TARKERSLEY
 R.M.C.

GREENVILLE CO. S.C.

5E-61

SURVEY FOR
 JERRY L. SCHOLL & ALICE B. SCHOLL
 NEAR GREENVILLE, S.C.
 SCALE 1"=80' 14 JAN. 1974

JAN 22 1974

CAROLINA SURVEYING CO.
 112 MANLY ST.
 GREENVILLE, S.C.

