


MICROFILMED

RECORDING FEE PAID \$ *1.00*

-63-

-64-

DUMENT AVE

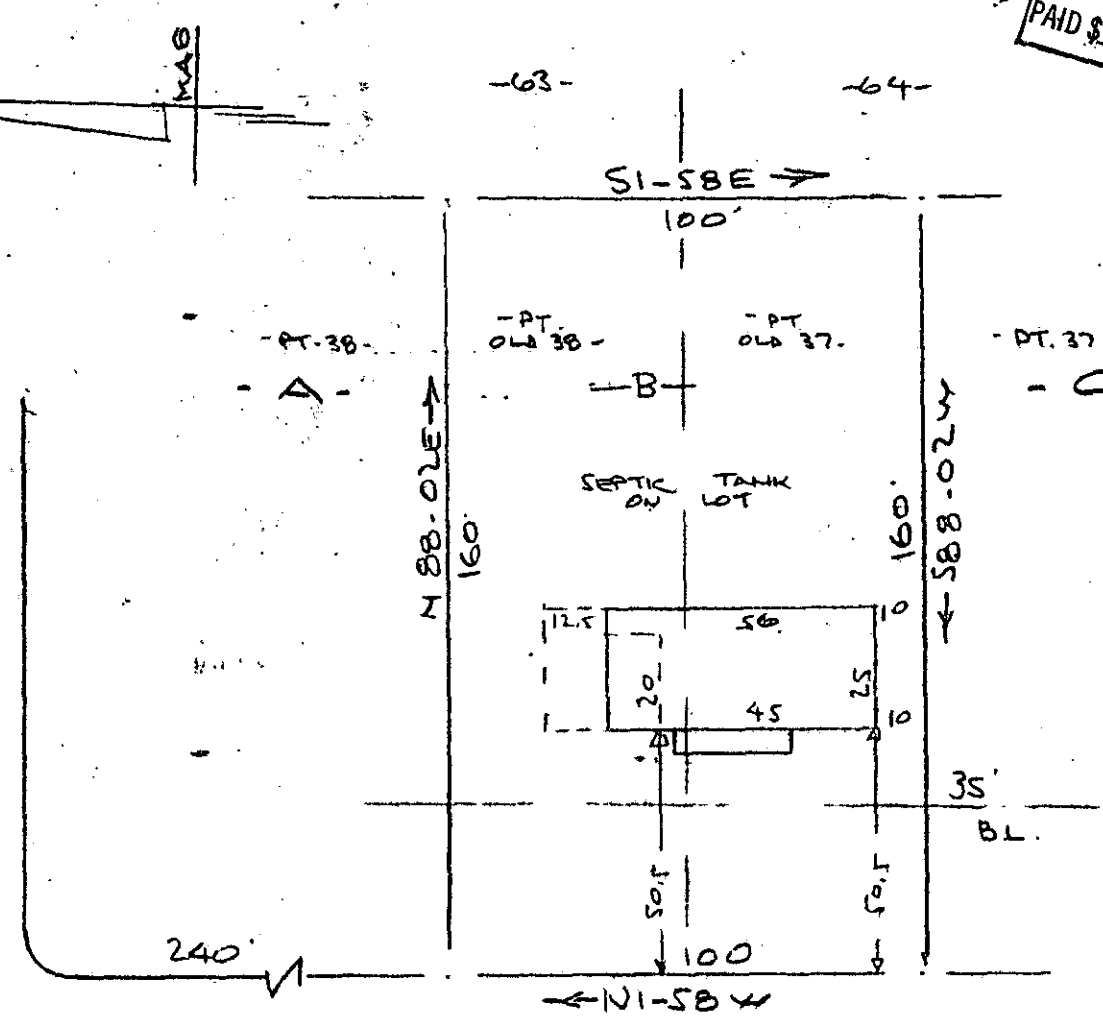

GAYLE STREET WATER IN ST. R/W


PROPERTY OF
 JON DALLAS SNYDER & JUANITA SNYDER
 NEAR GREENVILLE, S. C.
 SCALE: 1"=40' 25 MAR 1974

This is to certify that on the 25th day of March 1974, I surveyed the property shown on this plat, being known as (old) part of 38 & (old) part of 37 also lot B on plat of ROCKVALE SUBDIVISION and recorded in the RMC Office Greenville County, S.C., in Plat Book "QQ" at Page 108 also revised plat of ROCKVALE (Survey for Henry C. Harding Bldrs.) recorded in Plat Book "NNN" at Page 191 and that the property lines, walls and buildings are as shown hereon, and that the walls and buildings located on said lot do not encroach or project on adjacent street or property, and that no adjacent walls or buildings encroach or project on said premises, and no power lines cross this property except as shown hereon.

R. B. Bruce
 R. B. Bruce, RLS #1952

CAROLINA SURVEYING CO.
 112 Manly St.
 Greenville, S. C. 5E-137

MAR 28 1974

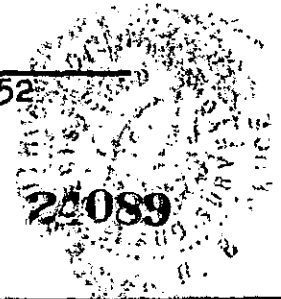

FILED
 GREENVILLE, CO. S. C.
 MAR 28 1 02 PM '74
 DONNIE S. TANKERSLEY
 R.M.C.

140/24 (3429)