
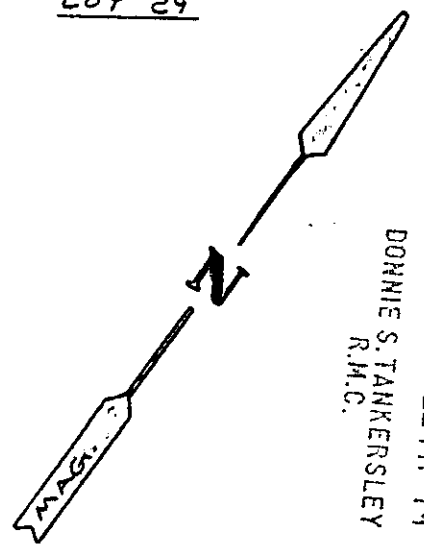


RECORDING FEE  
PAID \$ 10.00

I.P.'S @ ALL CORNERS

MICROFILMED

WATER & SEWER IN ST. R/W

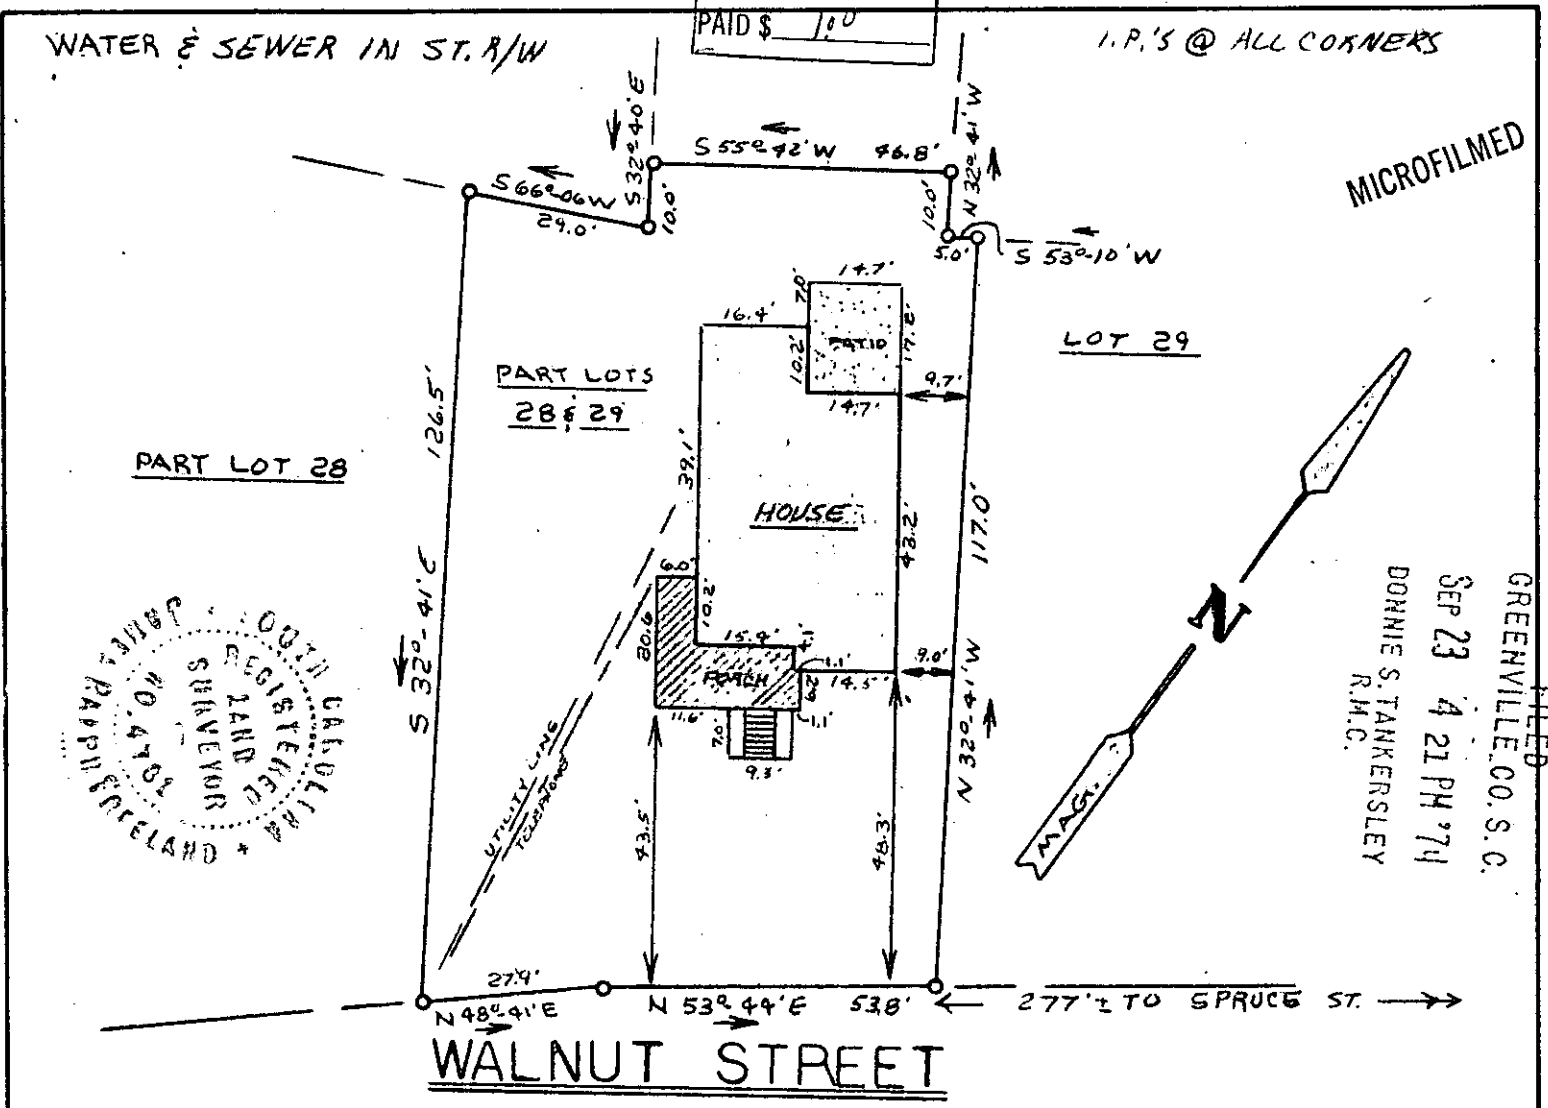

FILED  
GREENVILLE CO. S.C.  
SEP 23 4 21 PM '74  
DONNIE S. TANKERSLEY  
R.M.C.

This is to certify that on Sept. 19, 1974, I surveyed the property shown on this plat, known as Part Lots 28&29 on Plat of Overbrook Land Company, filed in the R.M.C. Office of Greenville County in Plat Book E on Pages 251&252, and that the property lines, walls and buildings are as shown hereon; that the building located on said lot does not encroach or project on adjacent streets or property and that no adjacent walls or buildings encroach or project on said premises, and that no utility lines cross this property except as shown hereon.

*James R. Freeland* F.L.  
James R. Freeland H.L.S. 4781

✓ 5 I - 42

7938

Blk. Bk.



SEAL

STATE OF SOUTH CAROLINA  
GREENVILLE COUNTY

OVERBROOK LAND CO.

PART LOTS 28 + 29

PROPERTY OF  
JAMES H WARD JR

SHIRLEY P WARD

FREELAND  
&  
ASSOCIATES  
GREENVILLE, S.C.

SURVEY F.L. F.S.F.  
DRAWN F.L.  
CHECK S.F.  
SCALE 1"=30'  
DATE 9-19-74  
DWG. NO. 234