MICROFILMED

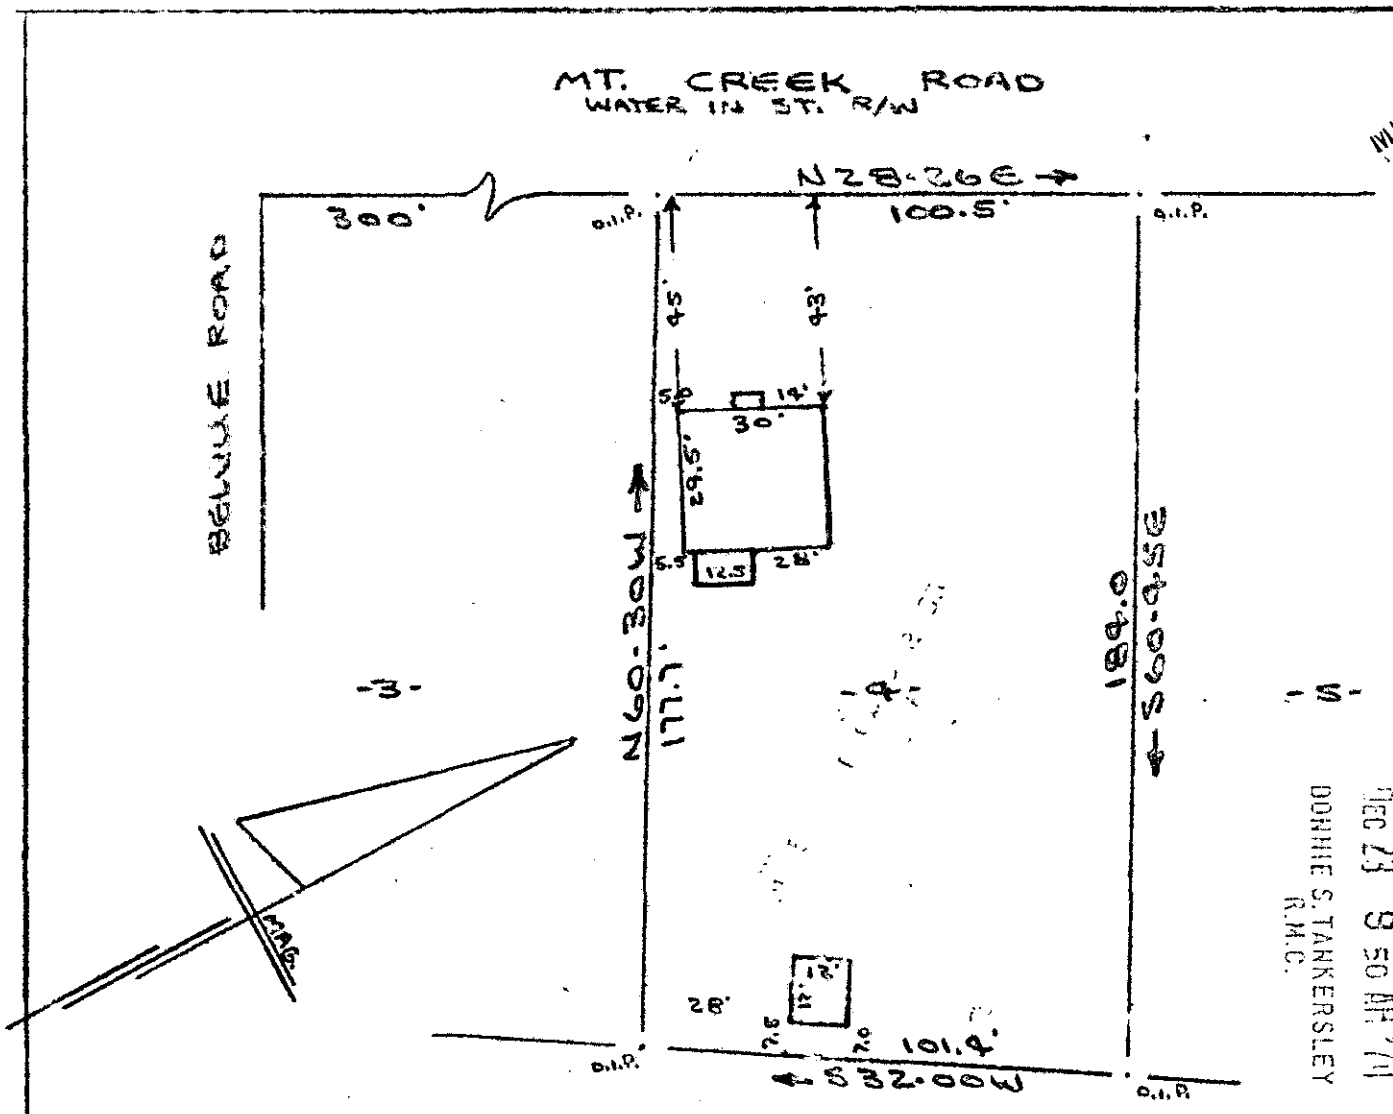

FILED
GREENVILLE CO. S. C.
DEC 23 9 50 AM '74
DONNIE S. TANKERSLEY
R.M.C.

PROPERTY OF
ROY B. COOKE
NEAR GREENVILLE, S.C.
SCALE 1" = 40' 16 DEC. 1974

This is to certify that on the 16th day of December 1974, I surveyed the property shown on this plat, being known as lot 4 on plat of ROY B. COOKE and recorded in the RMC Office Greenville County, S. C., in Plat Book at Page ; and that the property lines, walls and buildings are as shown hereon, and that the walls and buildings located on said lot do not encroach or project on adjacent street or property, and that no adjacent walls or buildings encroach or project on said premises, and no power lines cross this property except as shown hereon.

15247
5K-5
DEC 23 1974

R. B. Bruce
R. B. Bruce, RLS #1952

NOTE: Also being known as lot 4 on plat of Property of D. L. Chandler made by J. L. Freeman, February 26, 1942, (unrecorded)

CAROLINA SURVEYING CO.
112 Manly St.
Greenville, S. C.

RECORDING FEE
PAID $ 1.00

72/7522