

MICROFILM

KEOWEE AVENUE


SALUDA AVENUE

LOT 26

LOT 28

LOT 27

Garage

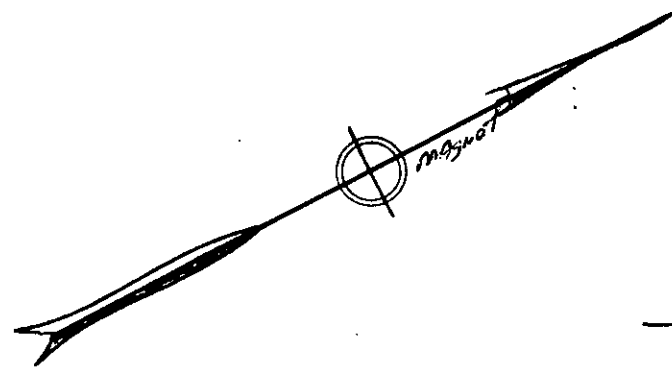

N27-28E 55'

110'

I.P.

I.P.

172.6'

N62-34W

42.5'

172.75'

S62-32E

I.P.

I.P.

S27-40W 54.9'

15Ft. Alley

FILED
GREENVILLE CO. S. C.
MAY 7 11 04 AM '75
DONNIE S. TANKERSLEY
R.H.C.

PROPERTY OF
MICKI M. HINTON
GREENVILLE, S. C.

Scale 1" = 30' May, 1975

25831

5K-140

This is to certify that on the 1st day of May, 1975, We surveyed the property shown on this plat; being known as Lot 27 of R. L. Brownlee, Redivision of Lots 25-26-27 of Cherokee Park, Recorded in Plat Book V page 171, Office of R. M. C. Greenville Co., S. C.; and that the property lines walls and buildings are as shown hereon; that the buildings located on said lot do not encroach or project on adjacent streets or property; and that no adjacent buildings or walls encroach or project on said premises.

MAY 7 1975

RECORDING FEE
PAID \$ 1.00



R.W. Dalton
Dalton & Neves Co., Engineers
Manley St. - 6th Fl. - F.B. 405