


MICROFILMED

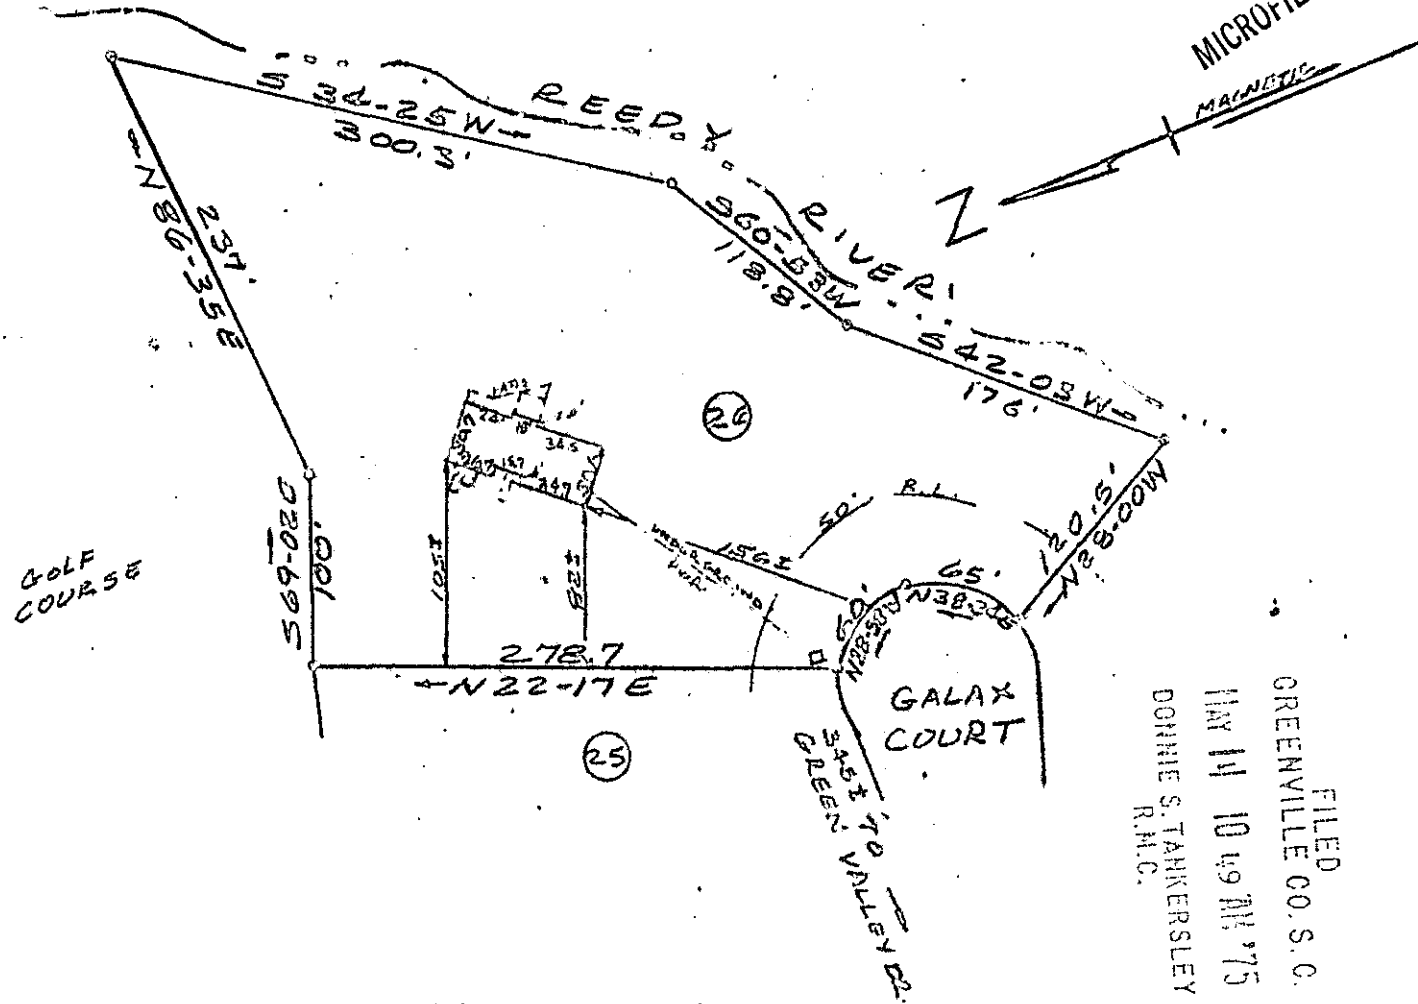

FILED
 GREENVILLE CO. S.C.
 MAY 14 10 49 AM '75
 DONNIE S. TARKERSLEY
 R.M.C.
 MAY 14 1975

PROPERTY OF
HAROLD F. GALLIVAN III
 &
FIELDING C. GALLIVAN
 NEAR GREENVILLE, S.C.
 MAY 1, 1975 SCALE 1" = 100'

This is to certify that on May 1, 1975, I surveyed the property shown on this plat, known as Lot No. 26 of Green Valley as shown on a plat received in the RMC Office for Greenville Co. in Plat Book QQ at page No. 2 & 3, and that the property lines, walls and buildings are as shown hereon, and that the building located on said lot does not project nor encroach on adjacent streets or property, and that no adjacent walls or buildings project nor encroach on said lot, and that no utility lines cross this lot except as may be shown hereon.

Survey by Campbell & Clarkson,
 Surveyors, Inc.

R.D. Campbell
 S.C.P.L.
 NOTEN.

✓ 5 m - 9

26452

PAID 1.00