


MICROFILMED

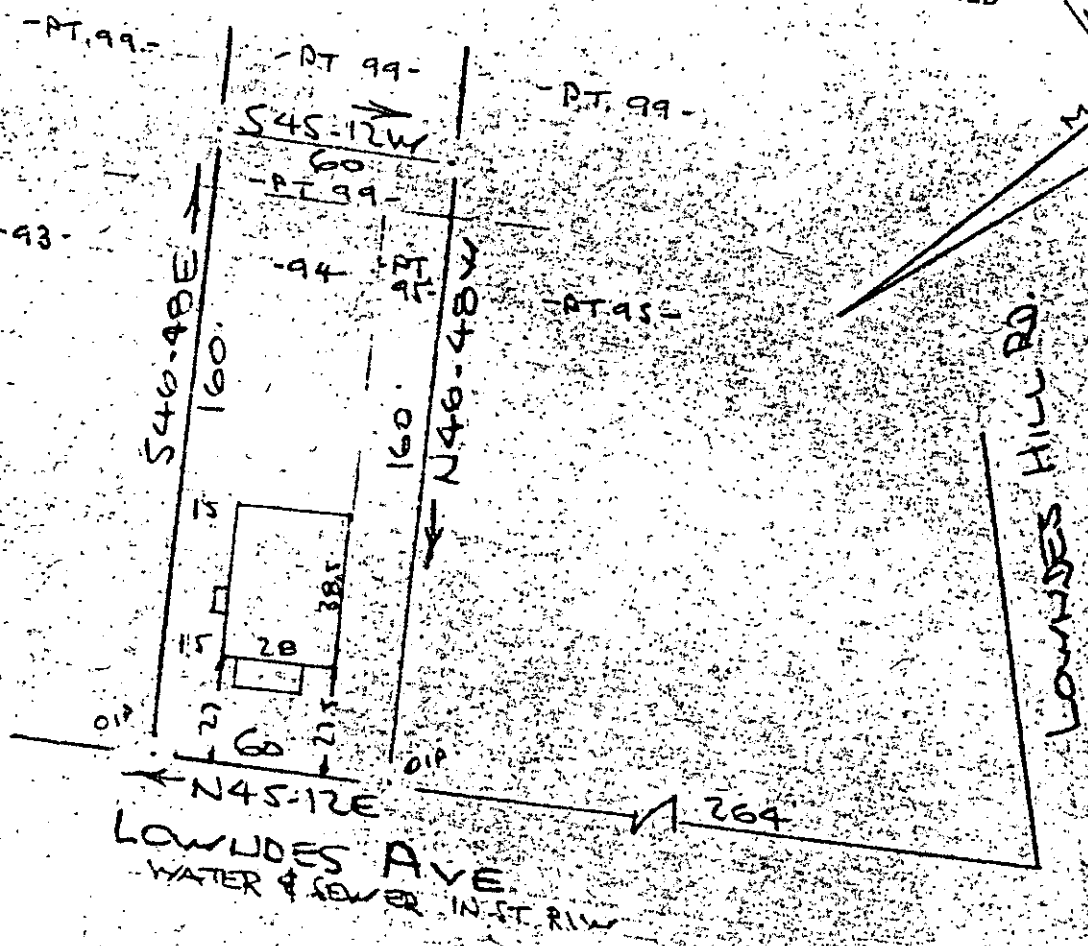

PROPERTY OF
FRANK D. SMITH
 GREENVILLE, S. C.
 SCALE: 1" = 50'
 13 JUNE 1975

This is to certify that on the 13th day of June 1975, I surveyed the property shown on this plat, being known as part of lot 99, part of lot 95 and lot 94 on plat of DIXIE HEIGHTS and recorded in the RMC Office Greenville County, S. C., in Plat Book "W" at Page 143; and also being known as PROPERTY OF FRANK D. SMITH and recorded in the RMC Office in Plat Book at Page and that the property lines, walls and buildings are as shown hereon, and that the walls and buildings located on said lot do not encroach or project on adjacent street or property, and that no adjacent walls or buildings encroach or project on said premises, and no power lines cross this property except as shown hereon.

JUN 26 1975

FILED
 GREENVILLE CO. S. C.
 JUN 26 2 41 PM '75
 DONNIE S. TANKERSLEY
 R.M.C.

5M-81

RECORDING FEE
 PAID \$ 1.00

30676

CAROLINA SURVEYING
 112 Manly St.
 Greenville, S. C.

R. B. Bruce, RLS
 CO.



147/61 - 60 A