MICROFILMED

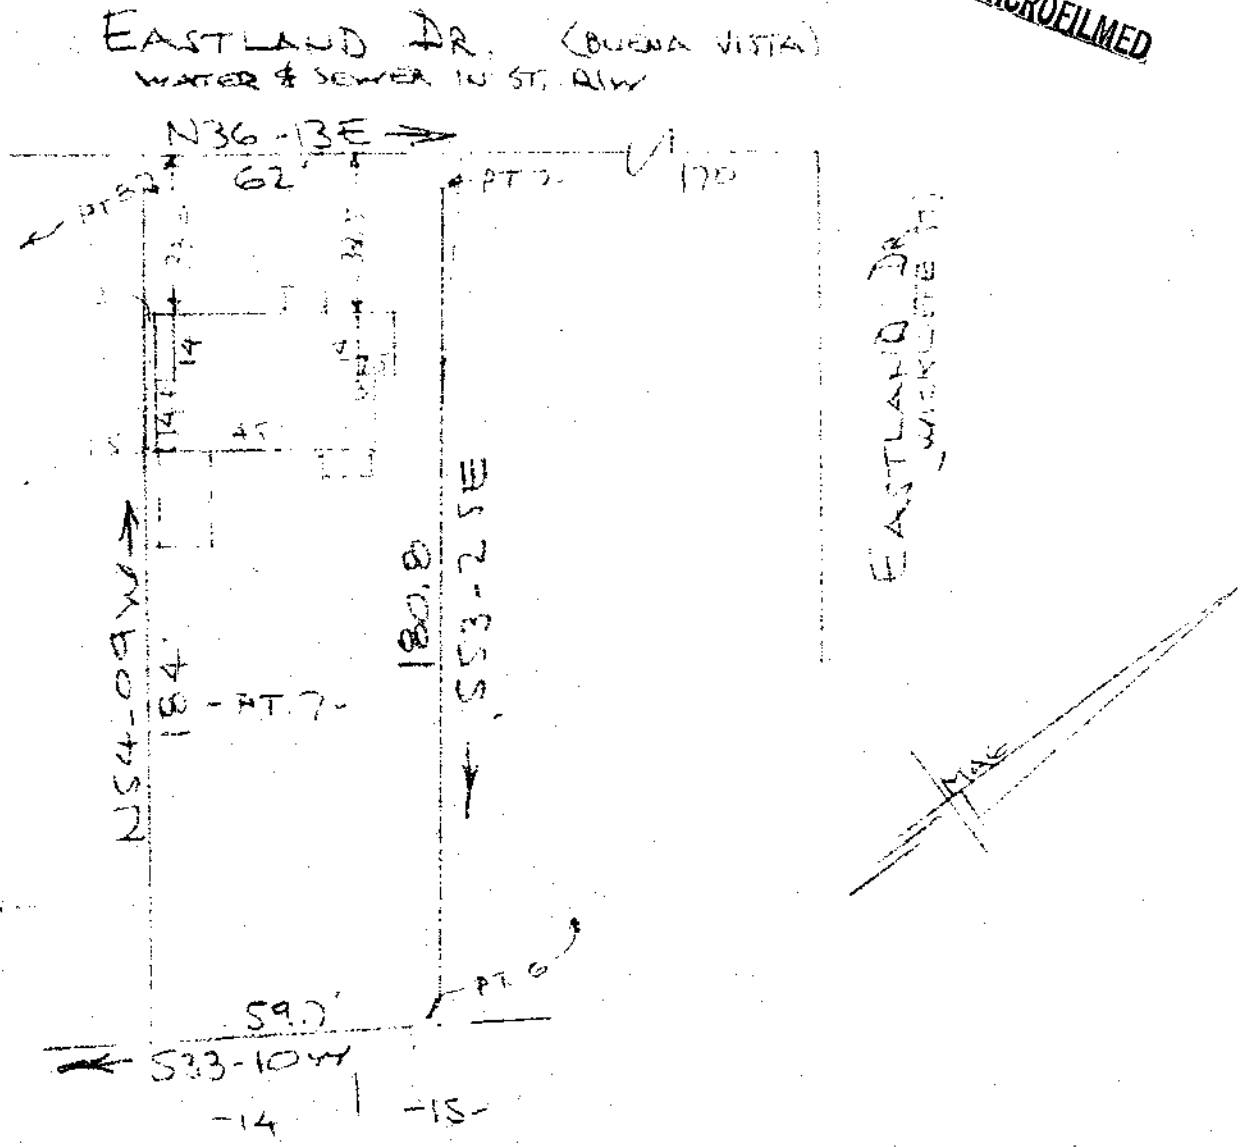

PROPERTY OF
DAVID BRUCE COOPER
GREENVILLE, S. C.
SCALE: 1" = 40'
10 JULY 1975

FILED
GREENVILLE CO. S. C.
JUL 23 4 23 PM '75
DONNIE S. TANKERSLEY
R.M.C.

This is to certify that on the 10th day of July 1975, I surveyed the property shown on this plat, being known as part of lot 6, part of lot 7 and part of lot 8 on plat of G. B. LEE PROPERTY and recorded in the RMC Office Greenville County, S. C., in Plat Book "K" at Page 43; and that the property lines, walls and buildings are as shown hereon, and that the walls and buildings located on said lot do not encroach or project on adjacent street or property, and that no adjacent walls or buildings encroach or project on said premises, and no power lines cross this property except as shown hereon.

Known as Property of David Bruce Cooper and recorded in Plat Book at Page

JUL 23 1975 2056

5M-122

R. B. Bruce RLS#1952

SOUTH CAROLINA REGISTERED NO. 1952 LAND SURVEYOR R. B. BRUCE

CAROLINA SURVEYING CO.
112 Manly St.
Greenville, S. C.

RECORDING FEE
PAID $ 1.00